


Sketch 22214 1/2

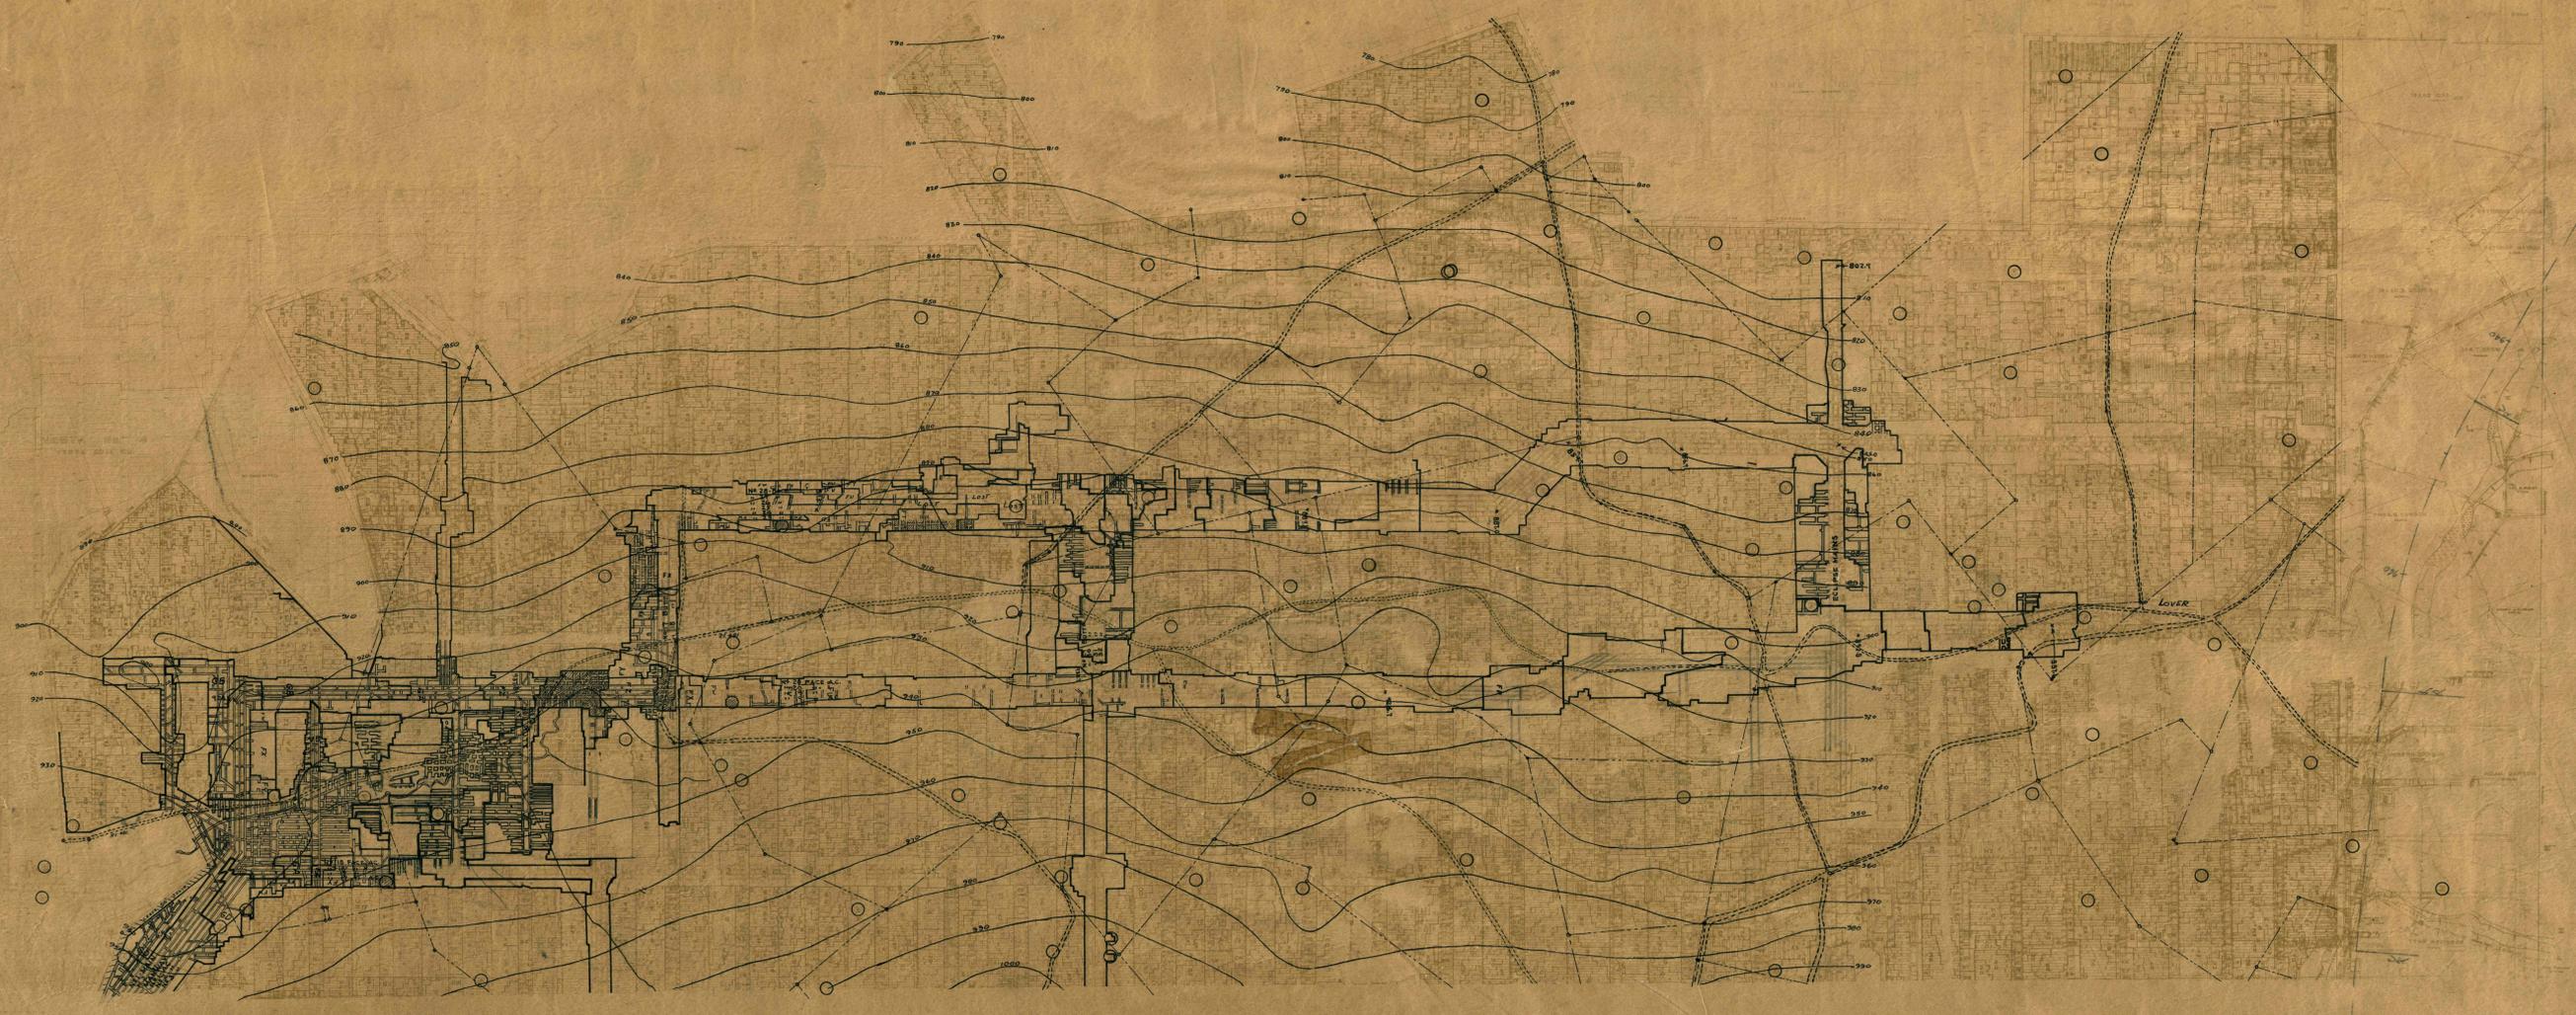

Figs 20 21