


Fits to 22

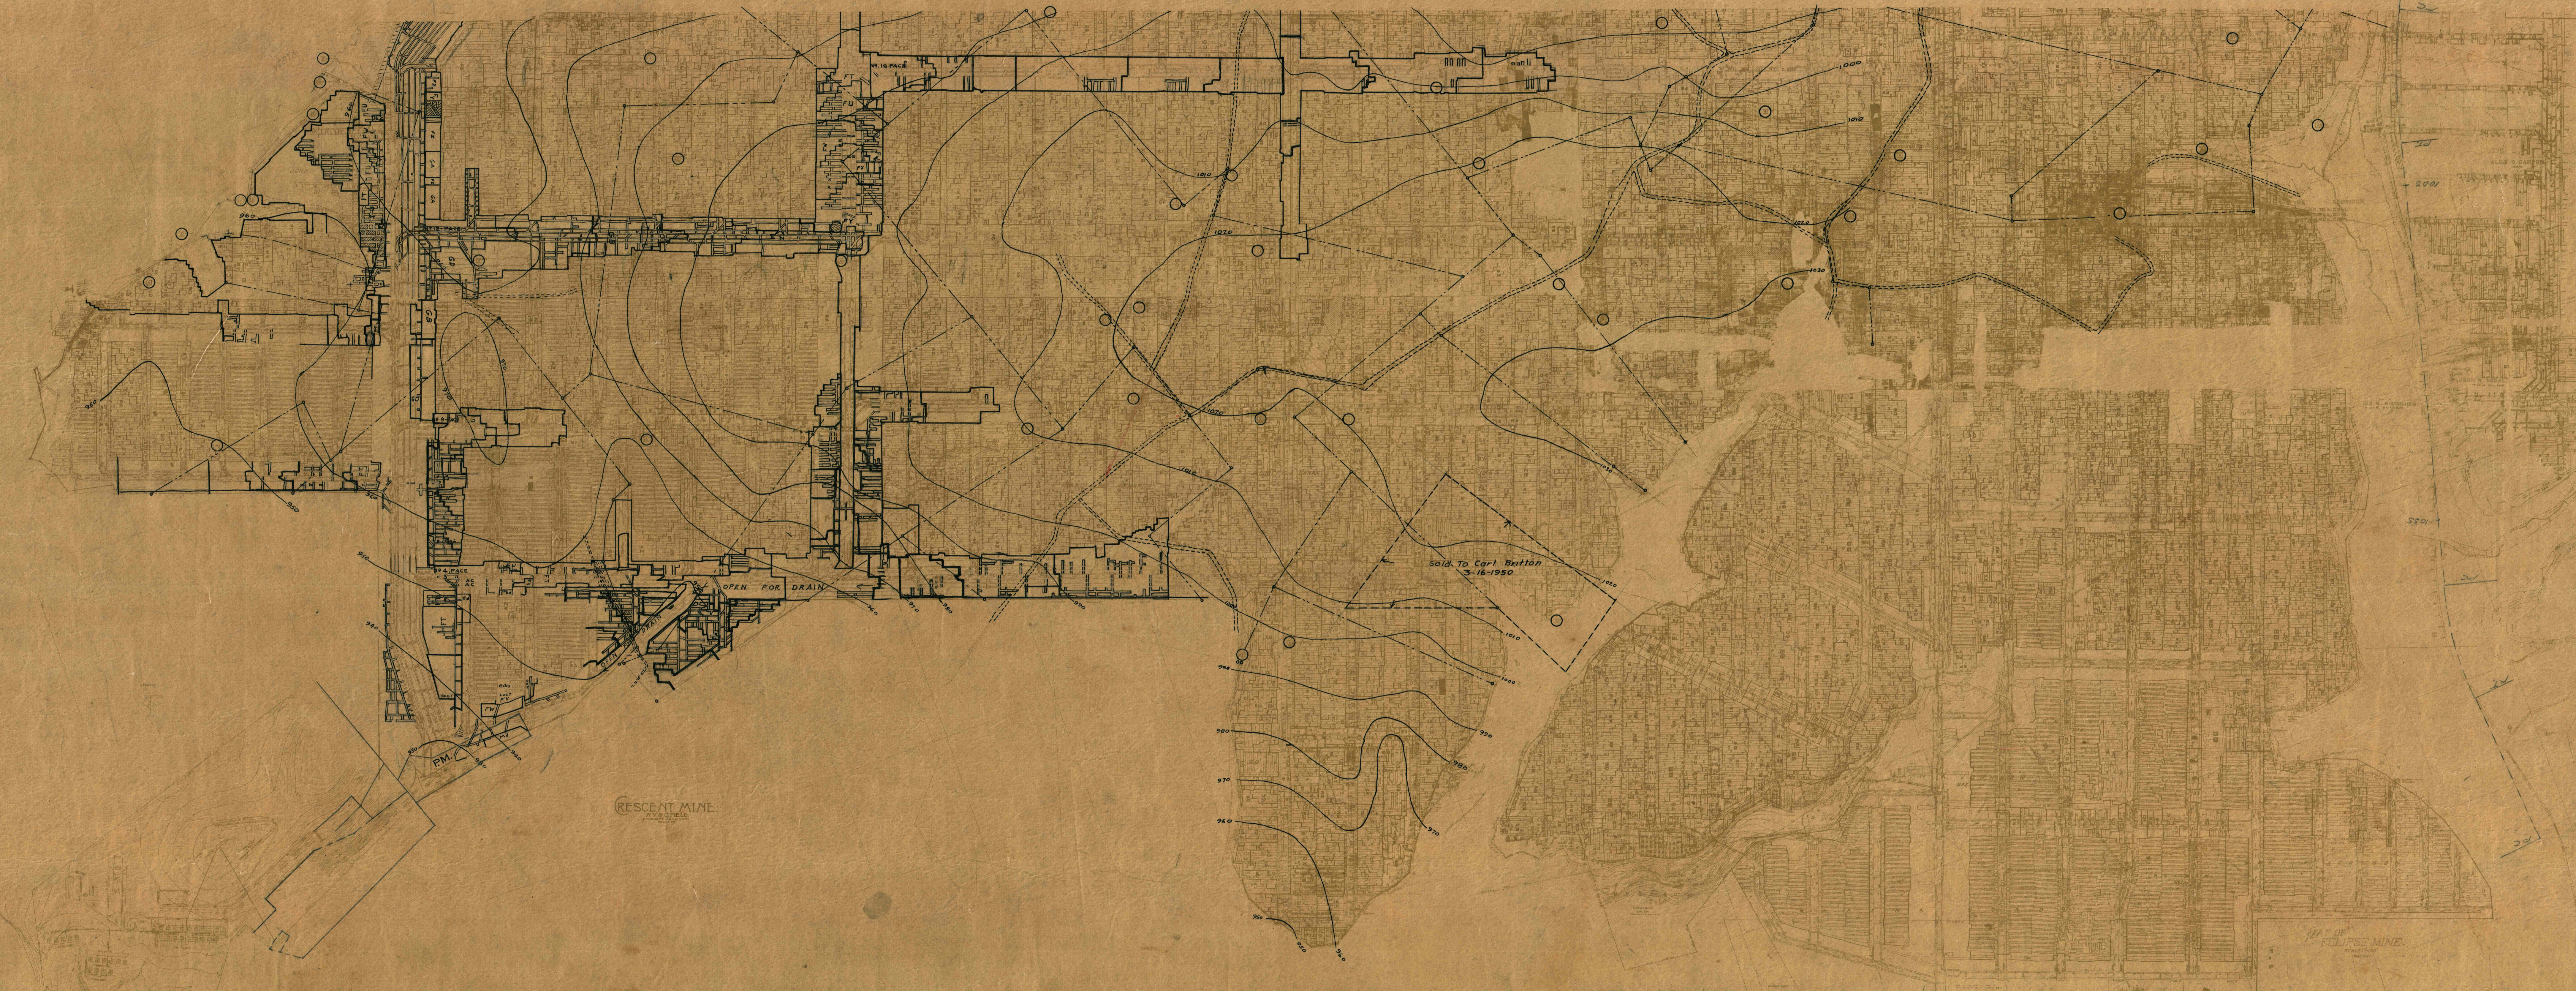


FIT TO SH. #20

SEE FITTING WORK

SOLD TO Carl Britton


Crescent #21

Crescent #21