



	1916	1917	1918	1919	1920	1921	1922	1923	1924	1925	1926	1927	1928	1929	1930	1931	1932
JANUARY					31												
FEBRUARY	14	12				23	6	13					4				
MARCH	3	9			2												
APRIL	29	7	28				14		2				26	23	25		
MAY	5		16														
JUNE	15								26	17		3				11	
JULY		6	20				10										
AUGUST	15												23	10			
SEPTEMBER	15																
OCTOBER							13					3	19				
NOVEMBER	3	22								2							
DECEMBER	12				6	18	6	22									22

MANOR GAS COAL COMPANY.

PLAN

of DENMARK MINE.

Scale 1" = 600'

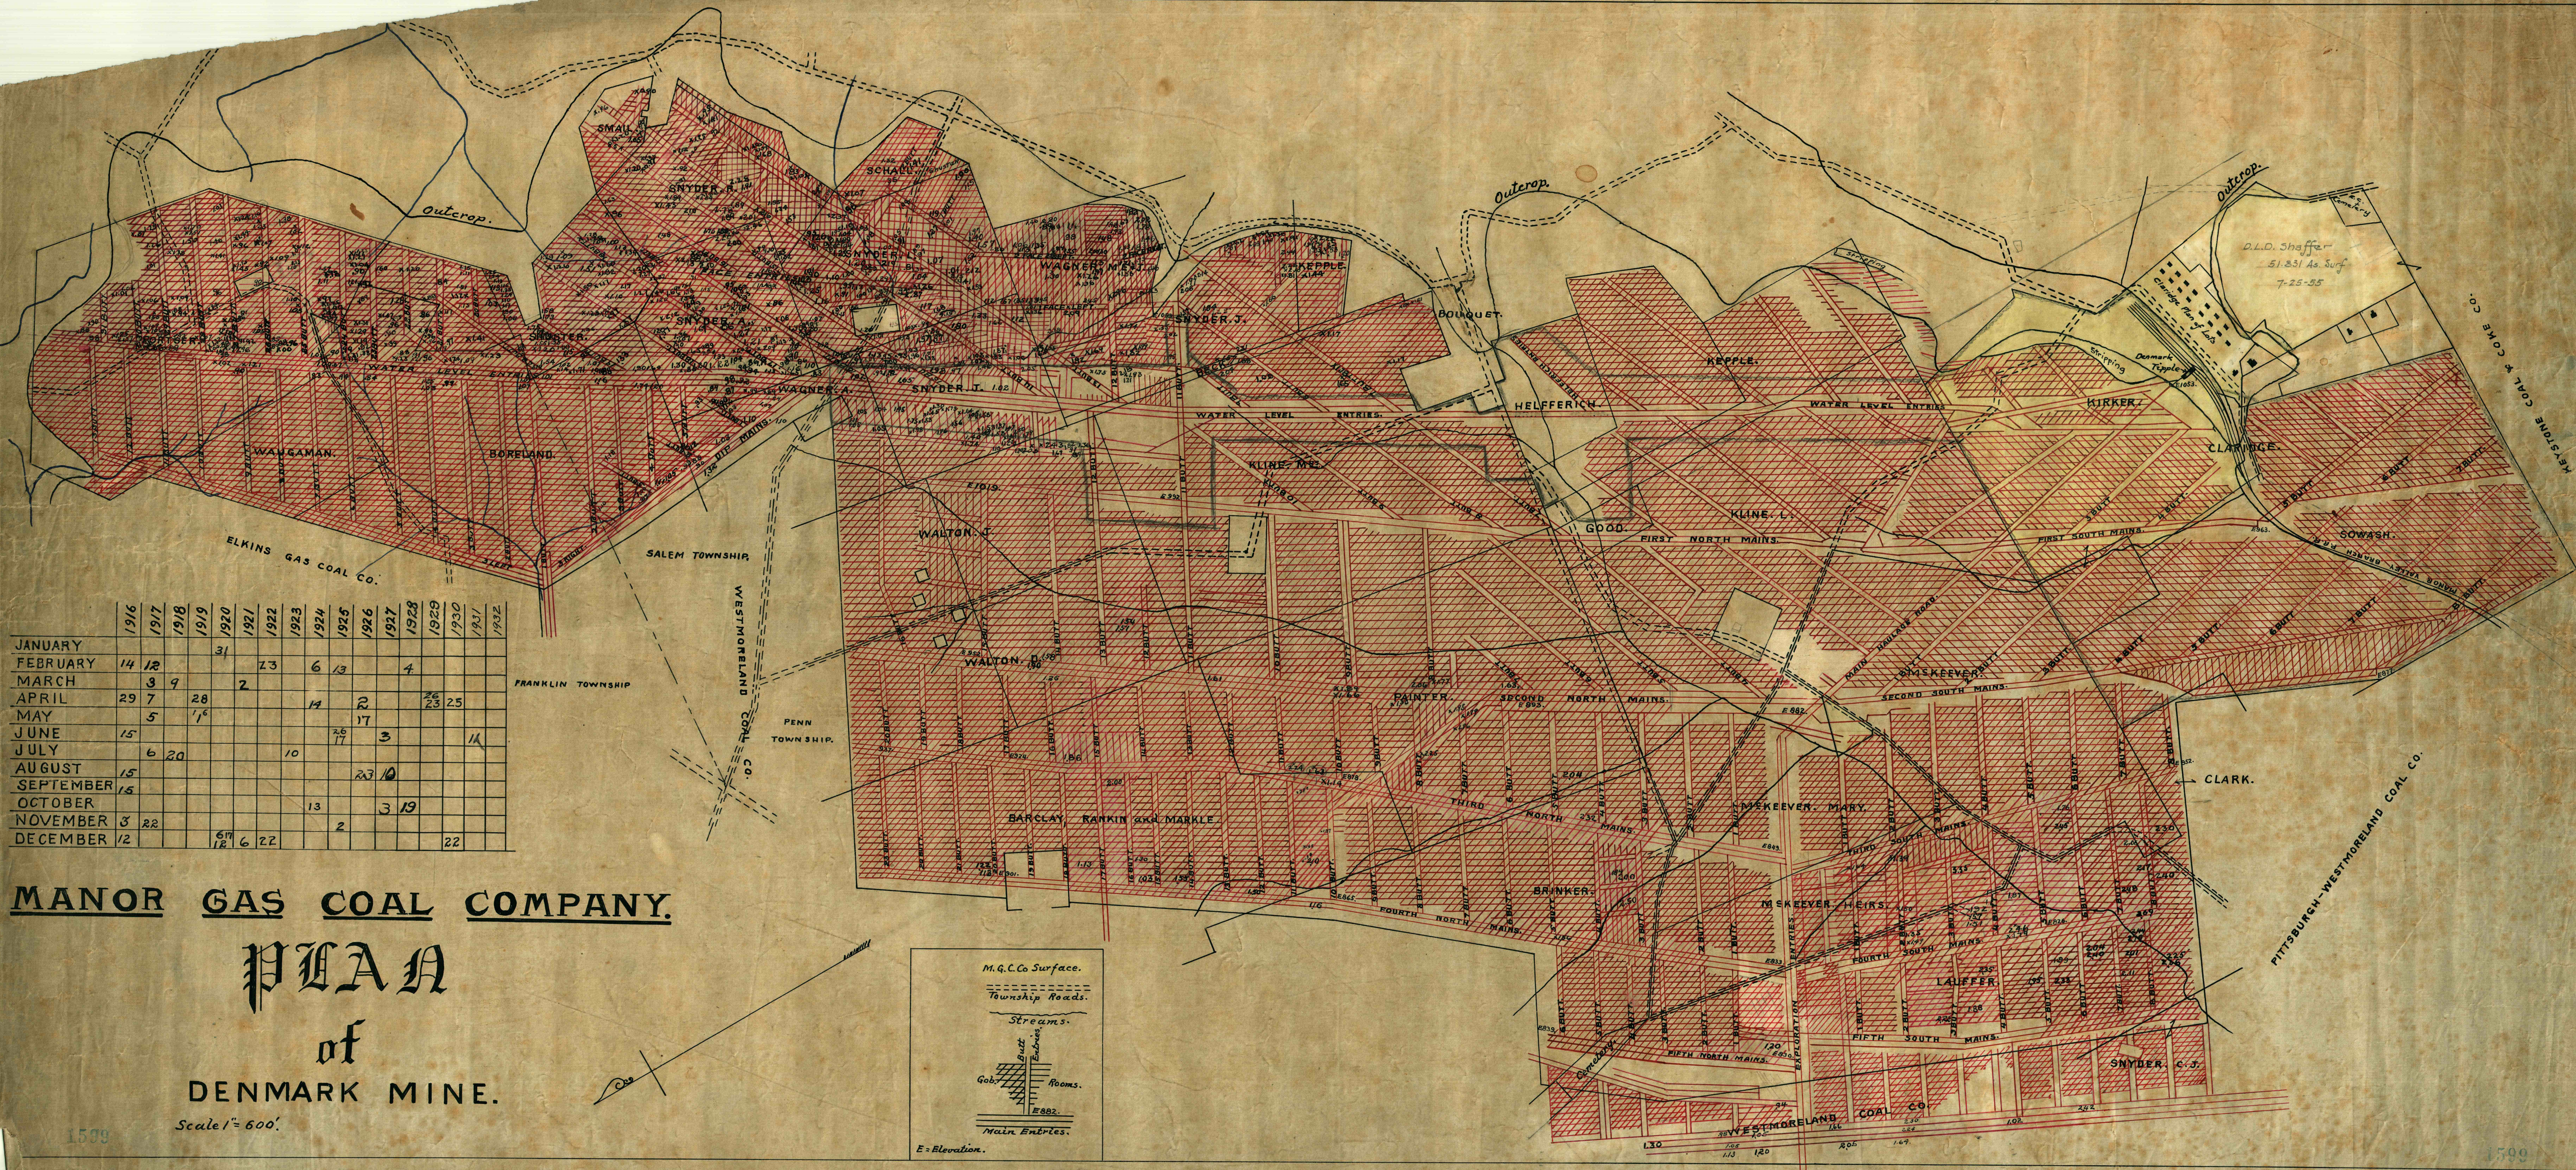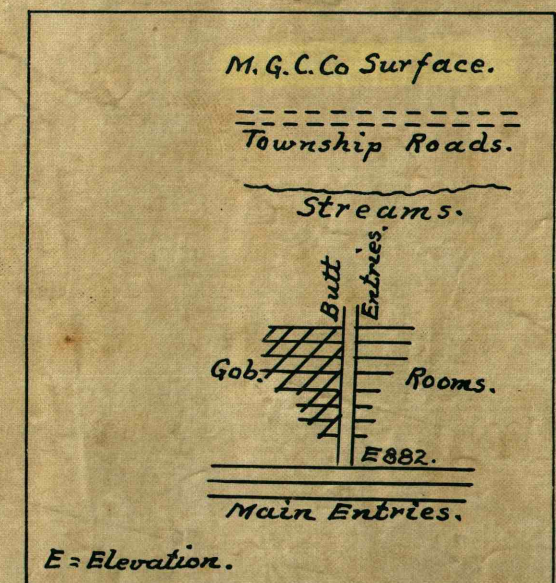

1599

1599