

CONSOLIDATION COAL COMPANY

DILWORTH MINE

36-04281

RICES LANDING BORO.
GREENE COUNTY PA.

SCALE 1" = 200'

MAP PREPARED AS OF DECEMBER 31, 2002

PROJECTED TO FINAL MAP


CLOSE LOOP SURVEY ACCURACY 1:15,000

INDIVIDUAL RESPONSIBLE FOR INFORMATION ON MAP:

THESE MAPS SATISFY THE REQUIREMENTS OF BOTH 75.372 & 75.1200 AS OF THE DATE PREPARED.

THERE ARE NO KNOWN WORKINGS ABOVE OR BELOW THIS MINE.

OXYGEN CONTENT AT BLEEDER EVALUATION POINTS IS GREATER THAN 19.5 %

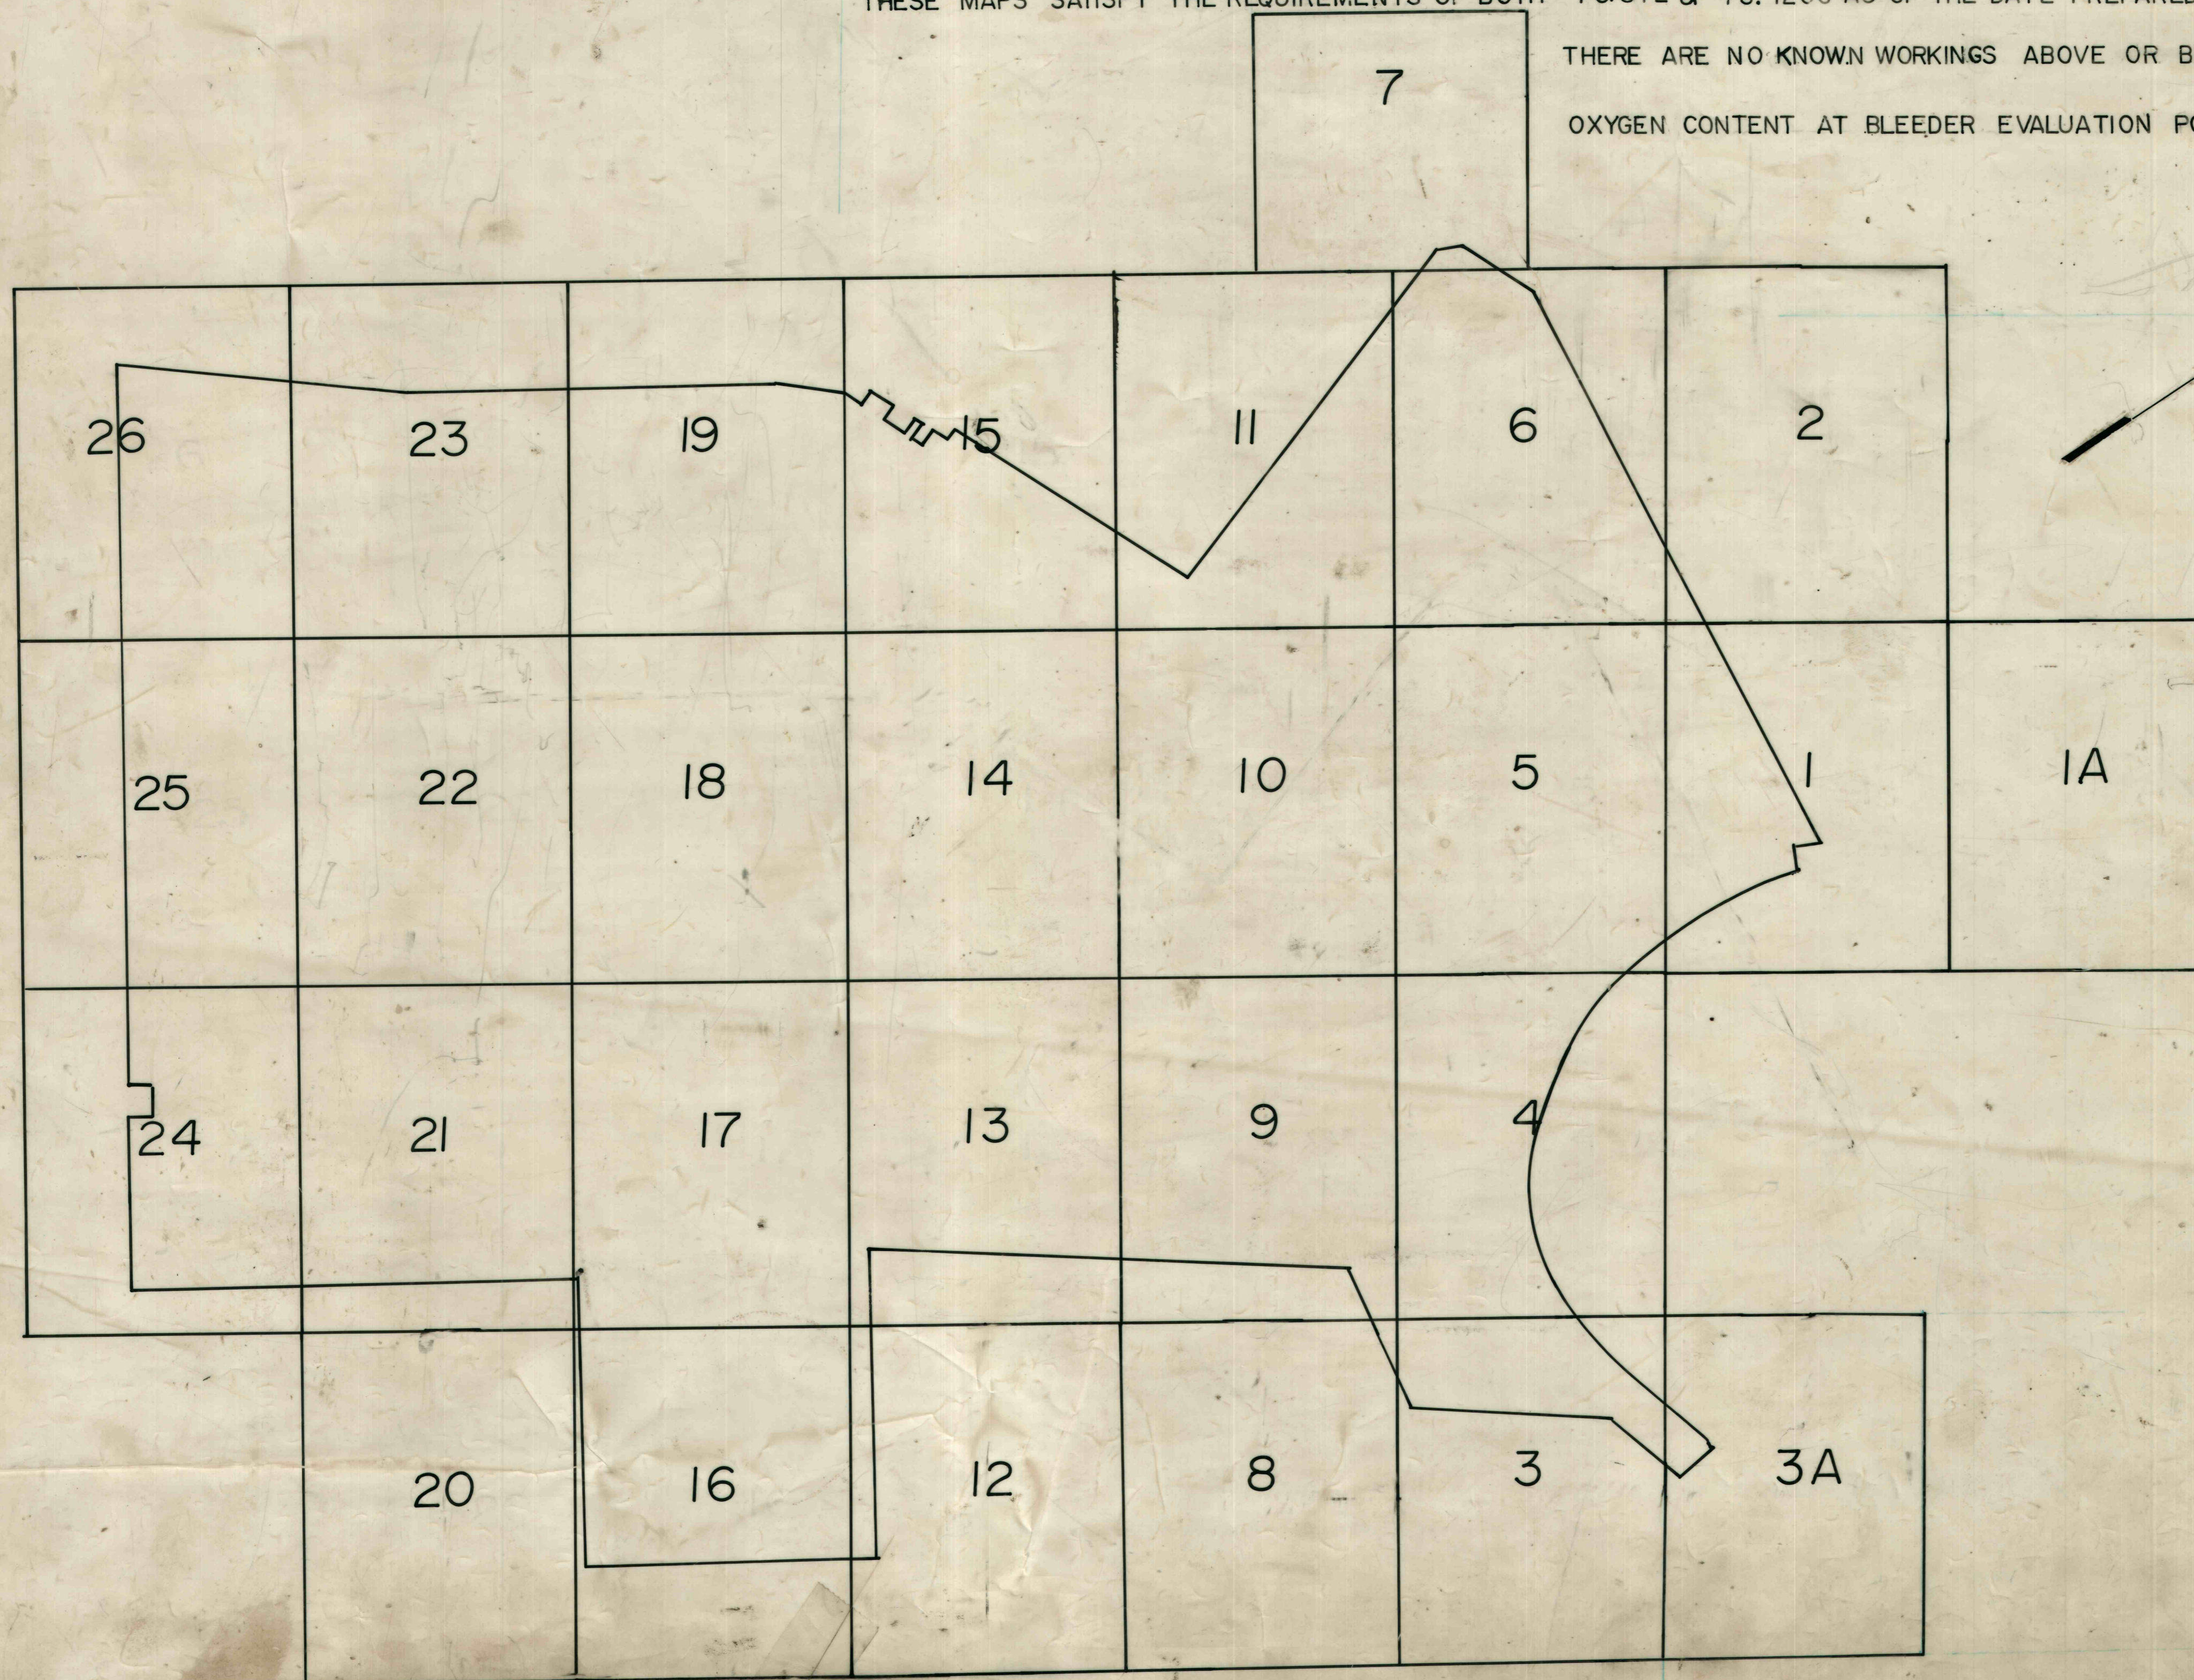

LEGEND

- 530-- BOTTOM OF COAL ELEVATION
- TD TRACK DOOR K KENNEDY STOPPING
- I, II STOPPING \$ SEAL
- ⊙ STOPPING WITH MAN DOOR
- ⊥ REGULATOR
- × OVERCAST × OVERCAST WITH MANDOOR
- INTAKE AIR DIRECTION ~ AIR LEAKAGE
← RETURN
- ▬ PRIMARY ESCAPEWAY ▬ ALTERNATE ESCAPEWAY
- ⊠ AIR LOCK SYSTEM
- ⊙ OIL OR GAS WELL
- ⌒ OVERPASS × OVERCAST WITH BLOCK OUT
- ▬ TRACK ▬ PRIMARY ESCAPEWAY & TRACK ENTRY DURING DEVELOPMENT
- ▬ BELT
- VENTILATION BOREHOLE (GOB DE-GAS HOLE)
- ⊥ CLOSED REGULATOR
- ▭ WATER AREA
- ⊥ STOPPING WITH BLOCK(S) OUT
- ⊙ STOPPING WITH MAN DOOR & BLOCK(S) OUT
- ⊥ BOX CHECK △ CO MONITOR
- ~ STREAM ~ POND
- ▨ GOB ▨ GOB ▨ GOB