


L96

COOPER COMPANY

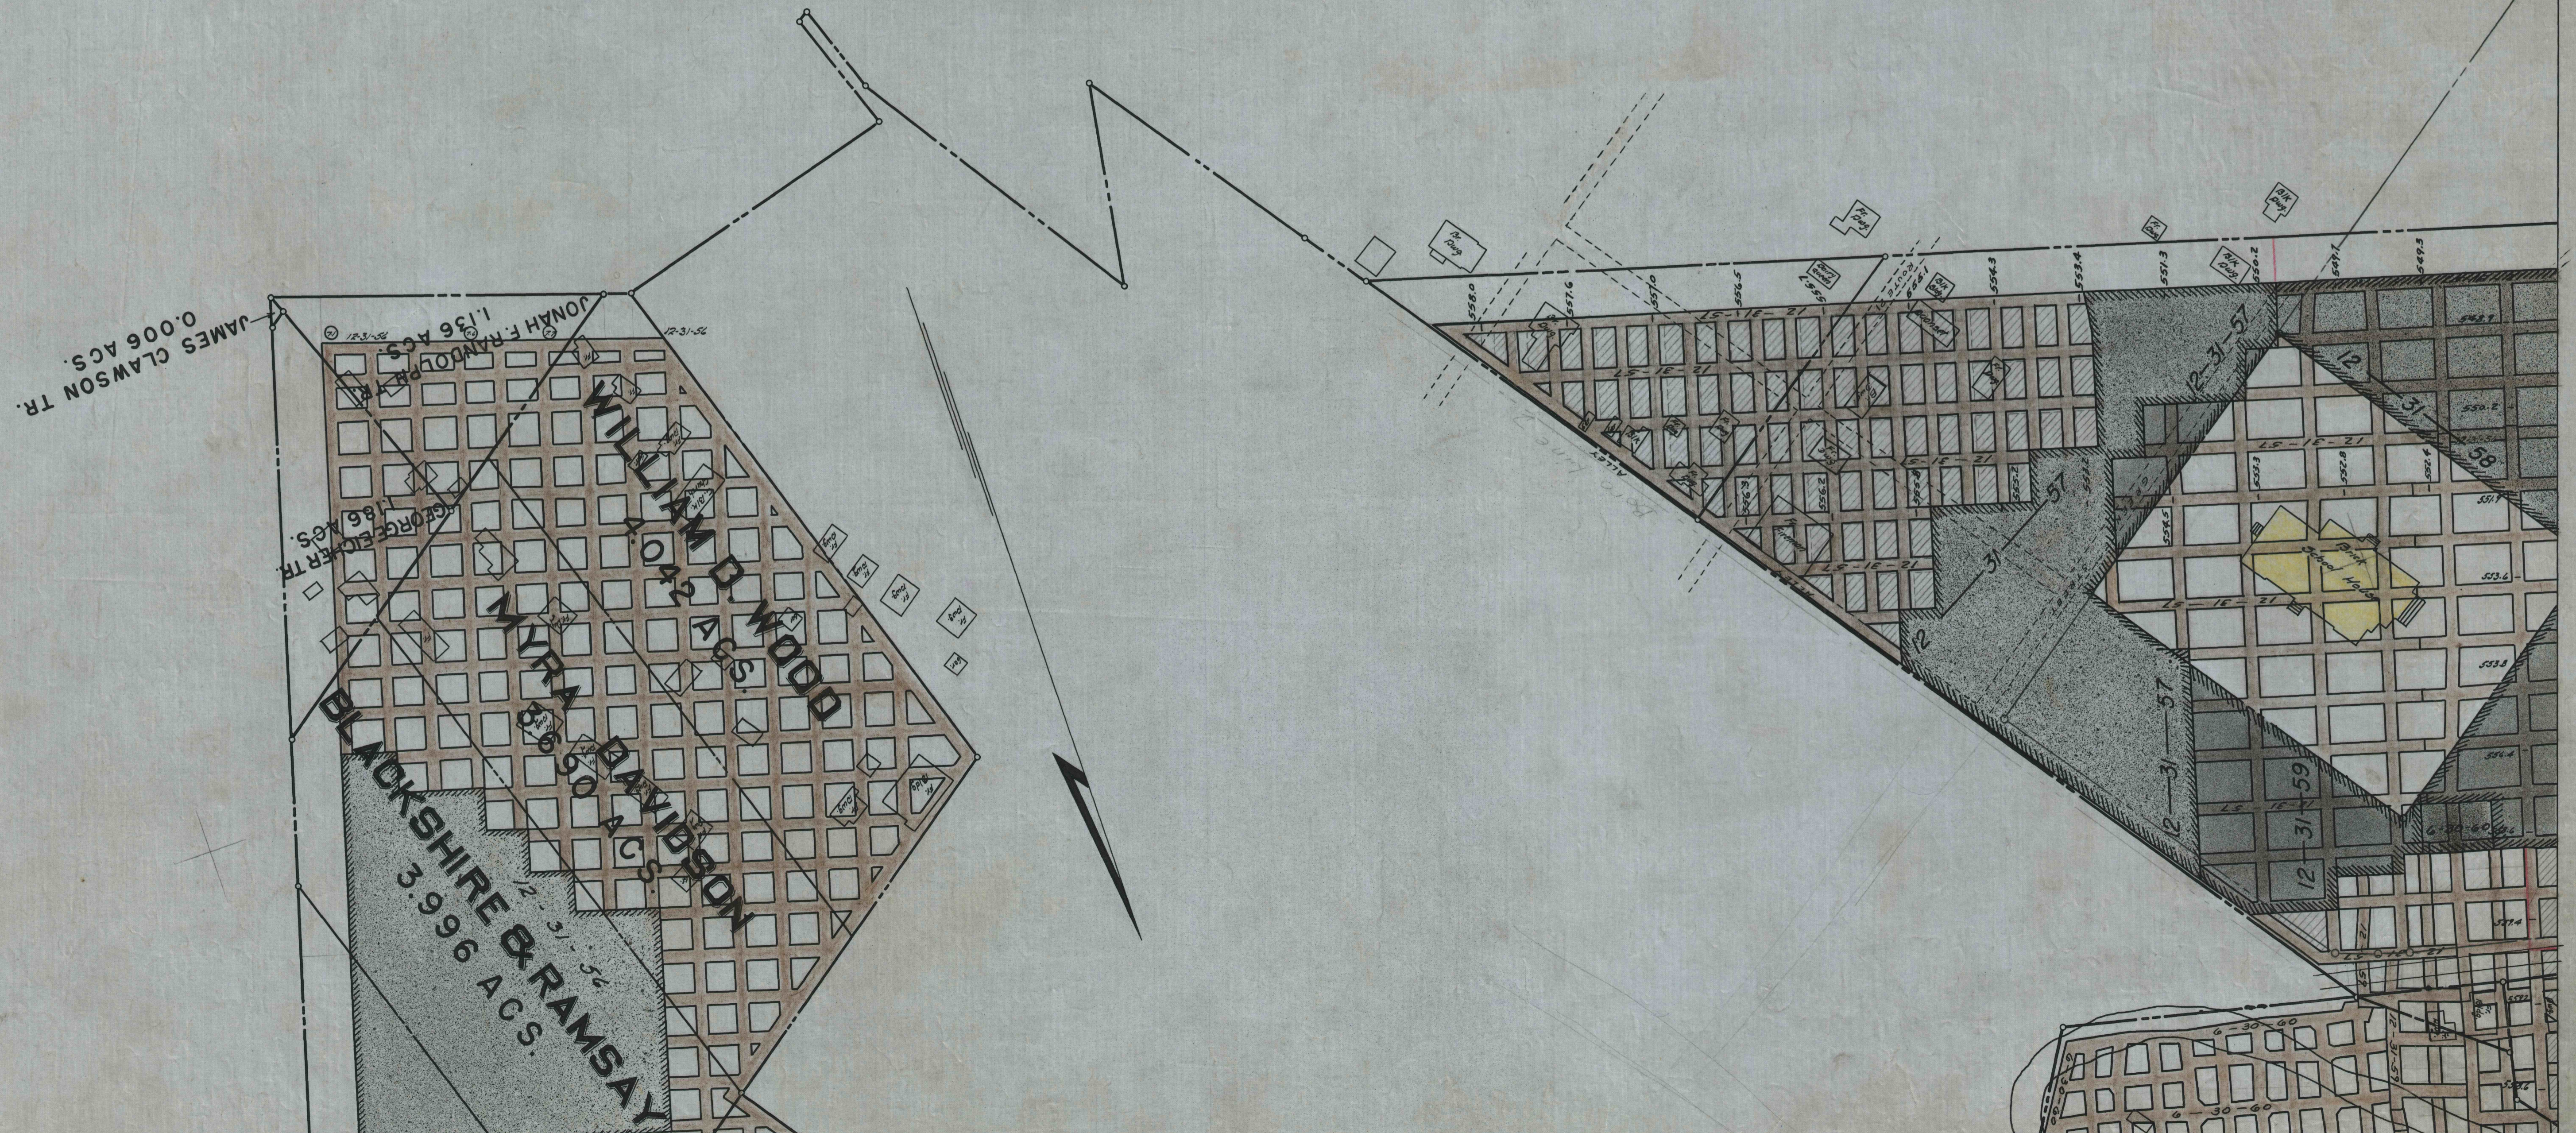

FIT TO 268

FIT TO 258

DILWORTH 267 1264