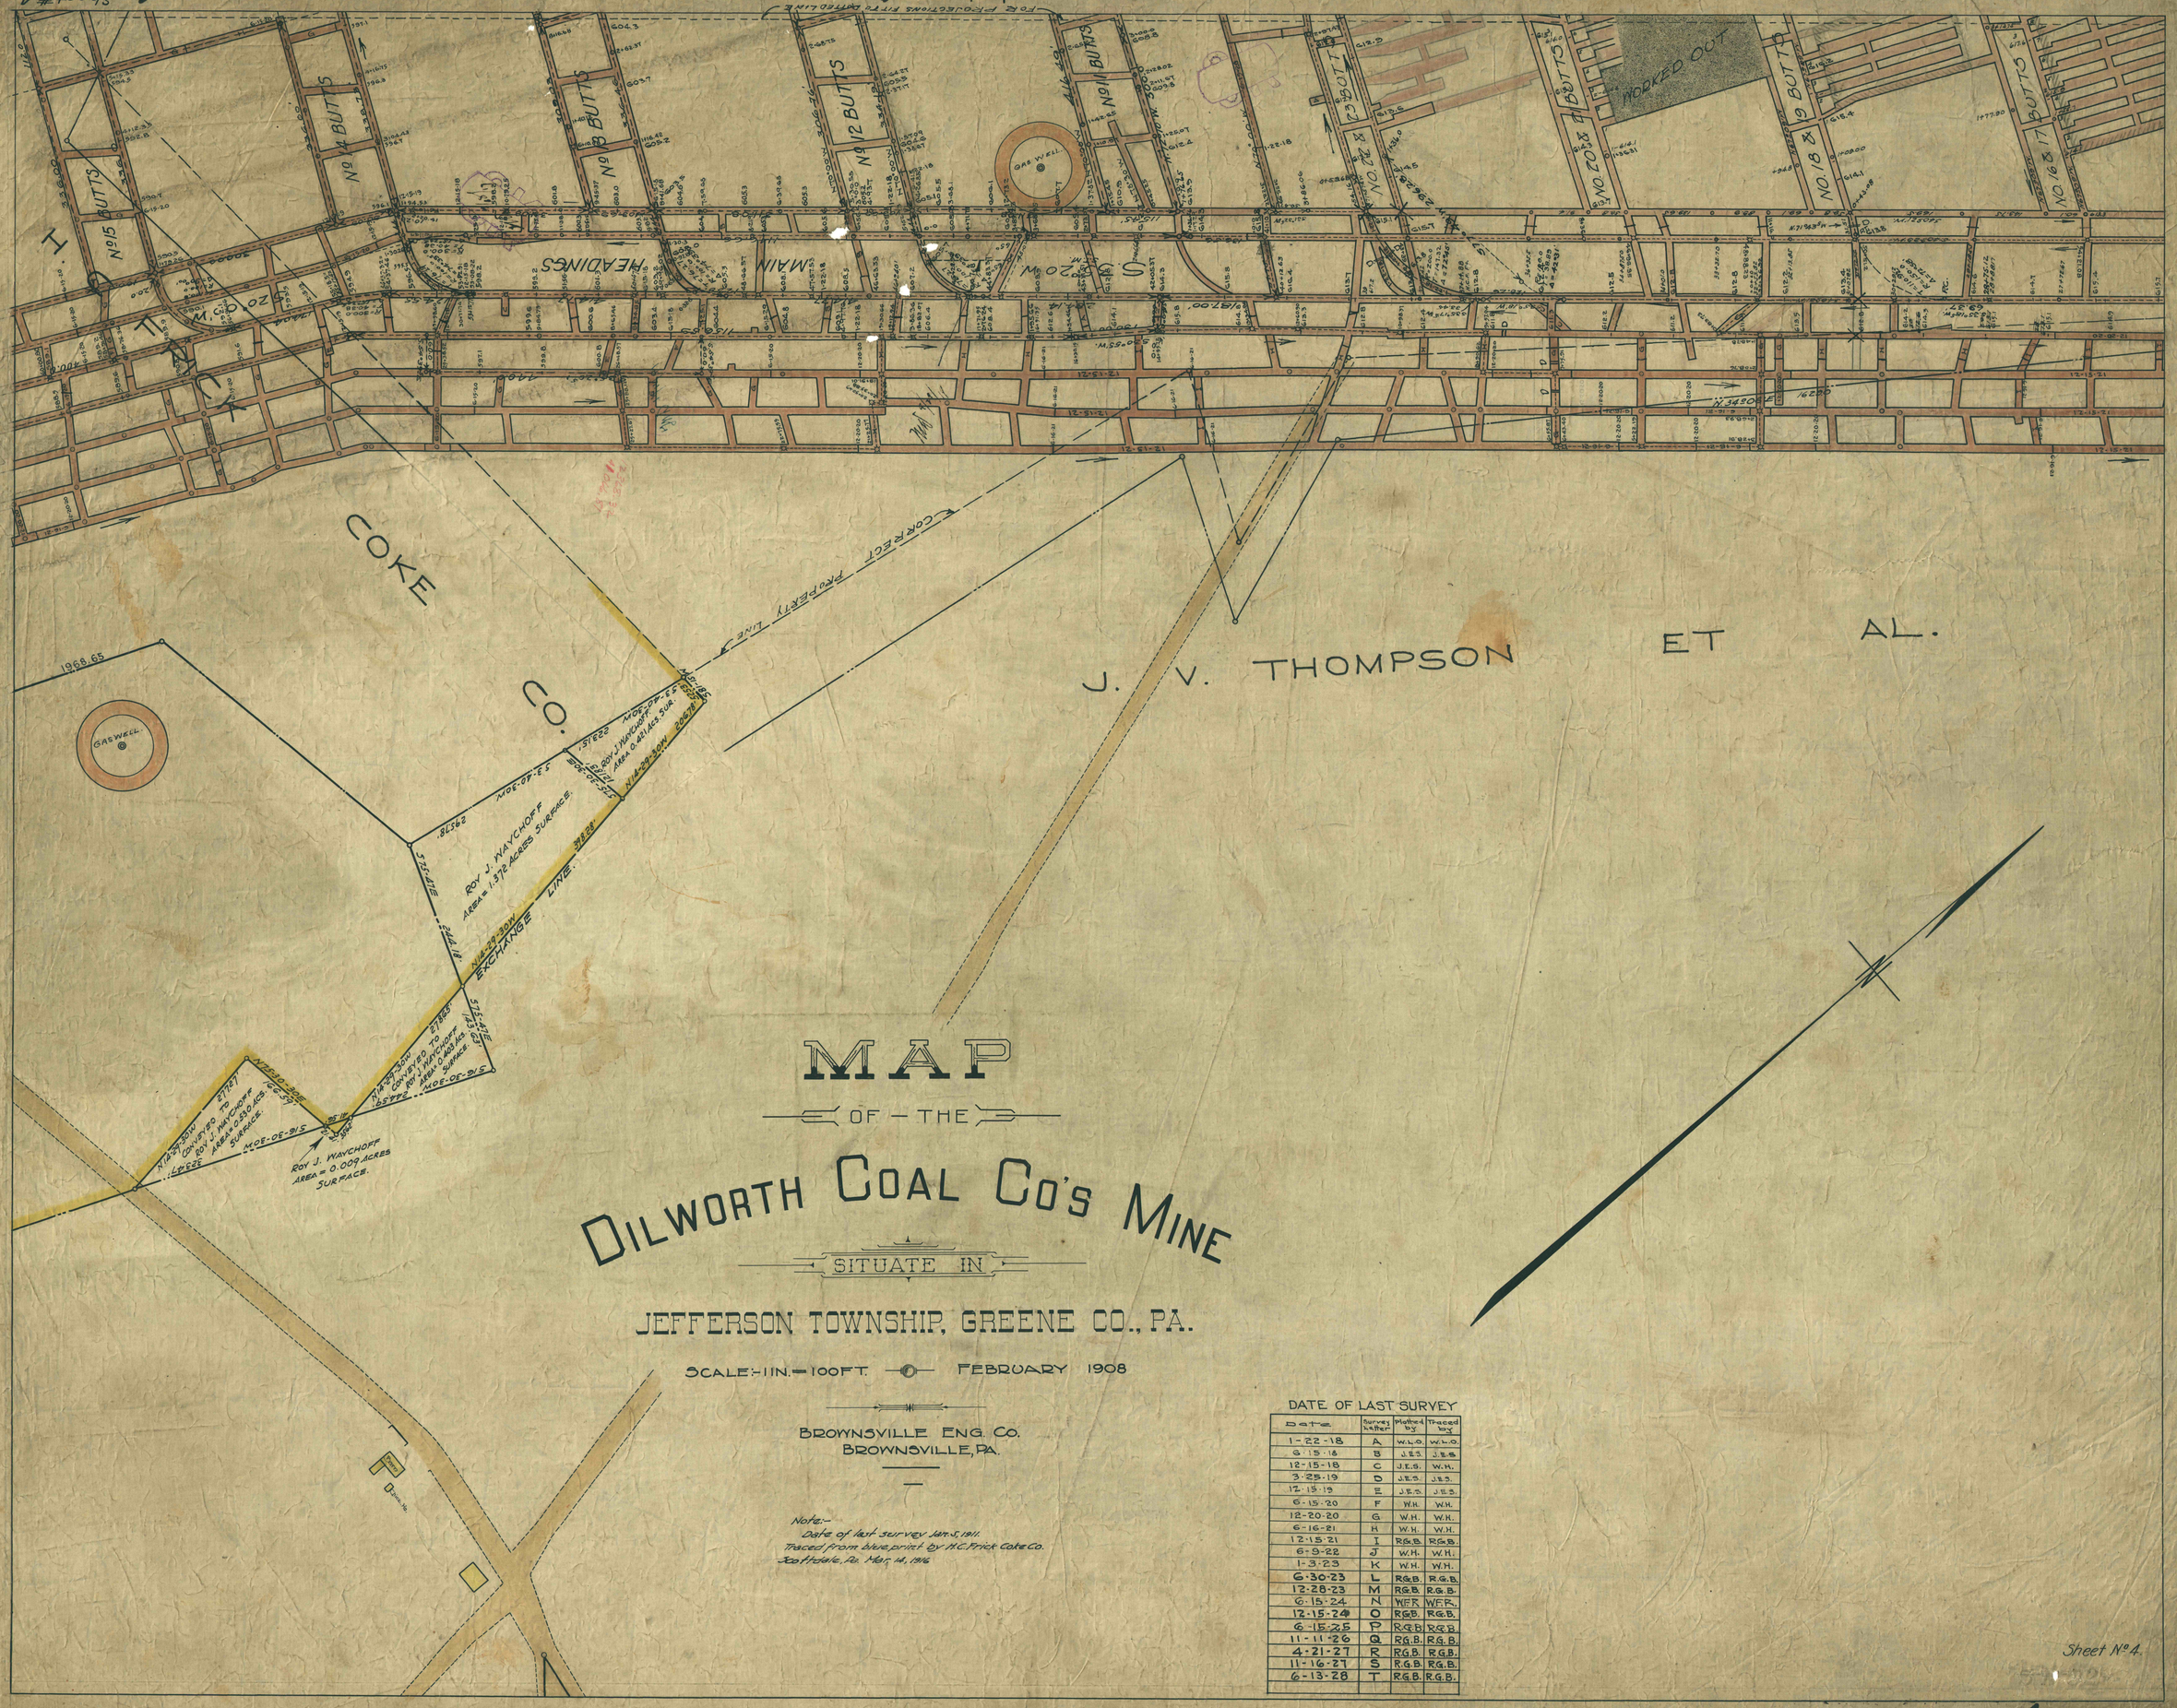

MAP

OF THE

DILWORTH COAL CO'S MINE

SITUATE IN

JEFFERSON TOWNSHIP, GREENE CO., PA.

SCALE:-1 IN. = 100 FT. FEBRUARY 1908

BROWNSVILLE ENG. CO.
BROWNSVILLE, PA.

Note:-
Date of last survey Jan. 5, 1911.
Traced from blue print by H.C. Frick Coke Co.
Scottdale, Pa. Mar. 14, 1916

DATE OF LAST SURVEY

Date	Survey Letter	Plotted by	Traced by
1-22-18	A	W.L.O.	W.L.O.
6-15-18	B	J.E.S.	J.E.S.
12-15-18	C	J.E.S.	W.H.
3-25-19	D	J.E.S.	J.E.S.
12-15-19	E	J.E.S.	J.E.S.
6-15-20	F	W.H.	W.H.
12-20-20	G	W.H.	W.H.
6-16-21	H	W.H.	W.H.
12-15-21	I	R.G.B.	R.G.B.
6-9-22	J	W.H.	W.H.
1-3-23	K	W.H.	W.H.
6-30-23	L	R.G.B.	R.G.B.
12-28-23	M	R.G.B.	R.G.B.
6-15-24	N	W.F.R.	W.F.R.
12-15-24	O	R.G.B.	R.G.B.
6-15-25	P	R.G.B.	R.G.B.
11-11-26	Q	R.G.B.	R.G.B.
4-21-27	R	R.G.B.	R.G.B.
11-16-27	S	R.G.B.	R.G.B.
6-13-28	T	R.G.B.	R.G.B.

Sheet No. 4.

11 Sheet 4 Dilworth