


VOID

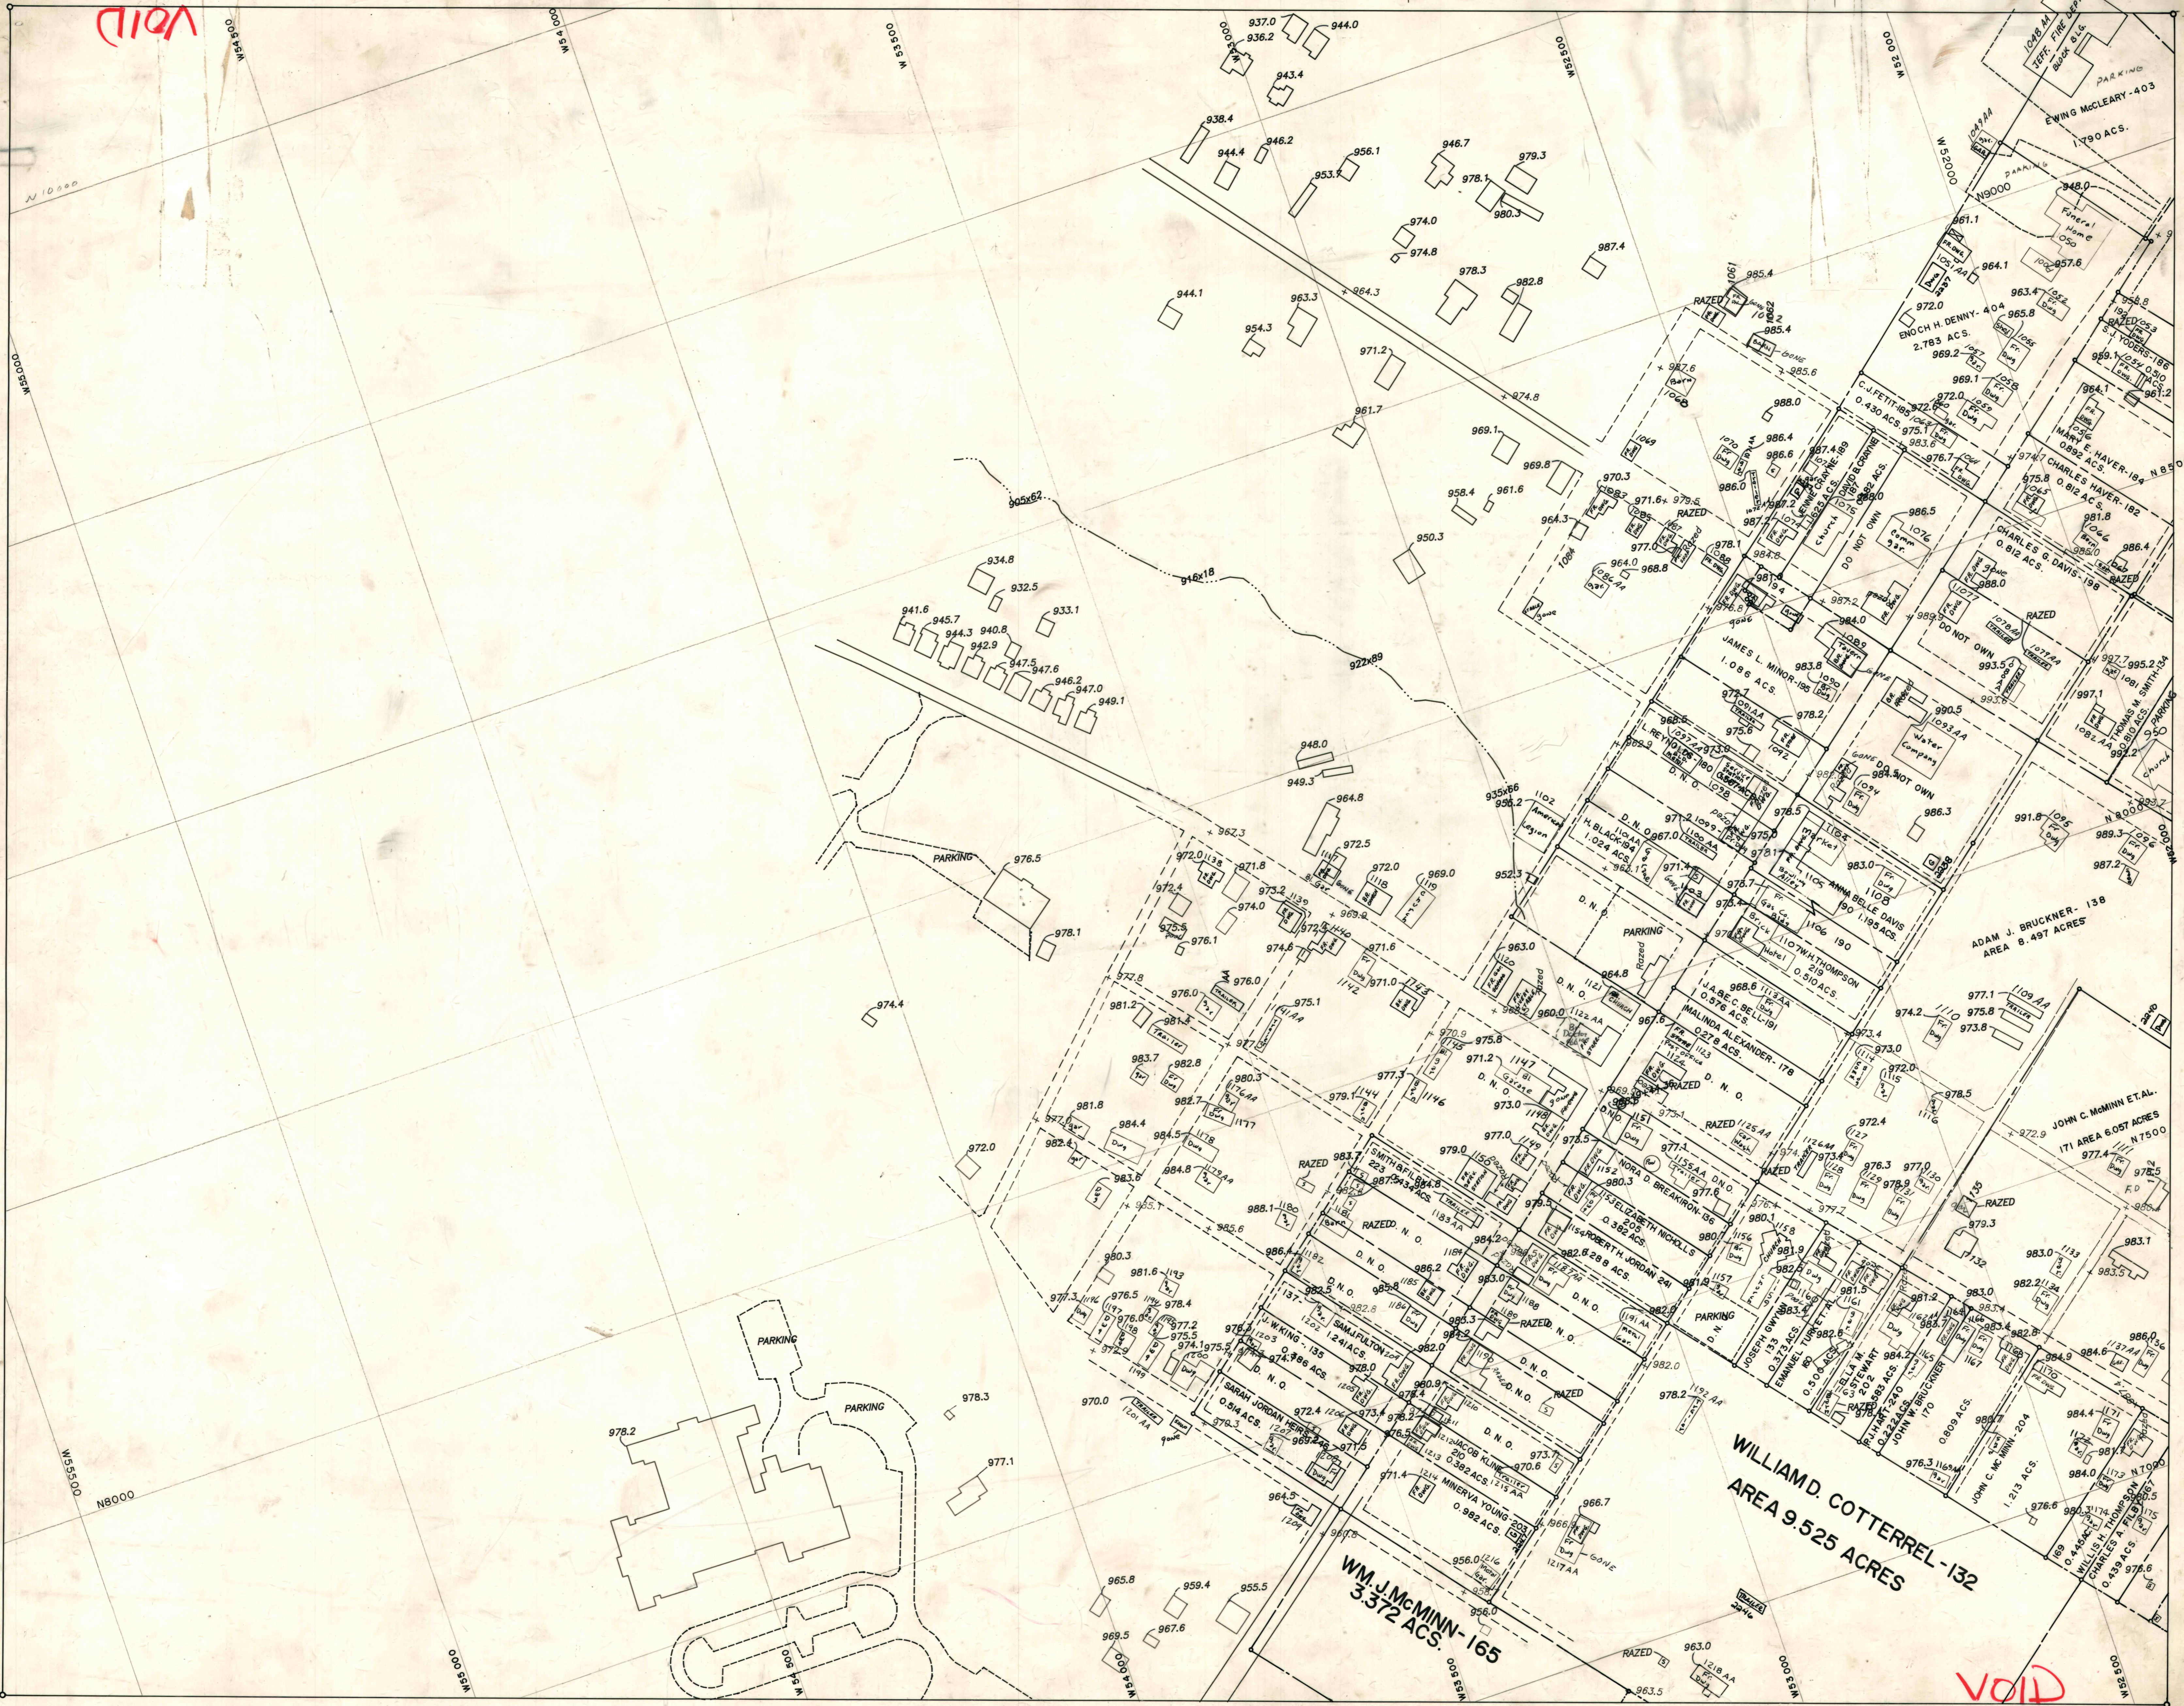

VOID