

GEORGE F LUCE-248 C  
AREA 47.439 ACRES


AIR SHAFT NO. 5 FANS

3 MAIN 38 ROOM

THOMAS B. CHRISTOPHER  
AREA 189.979 ACRES

THERESA CARAVAGGIO-SURFACE  
AREA 192.047 ACRES

3 MAIN 38 ROOM-ID WEST

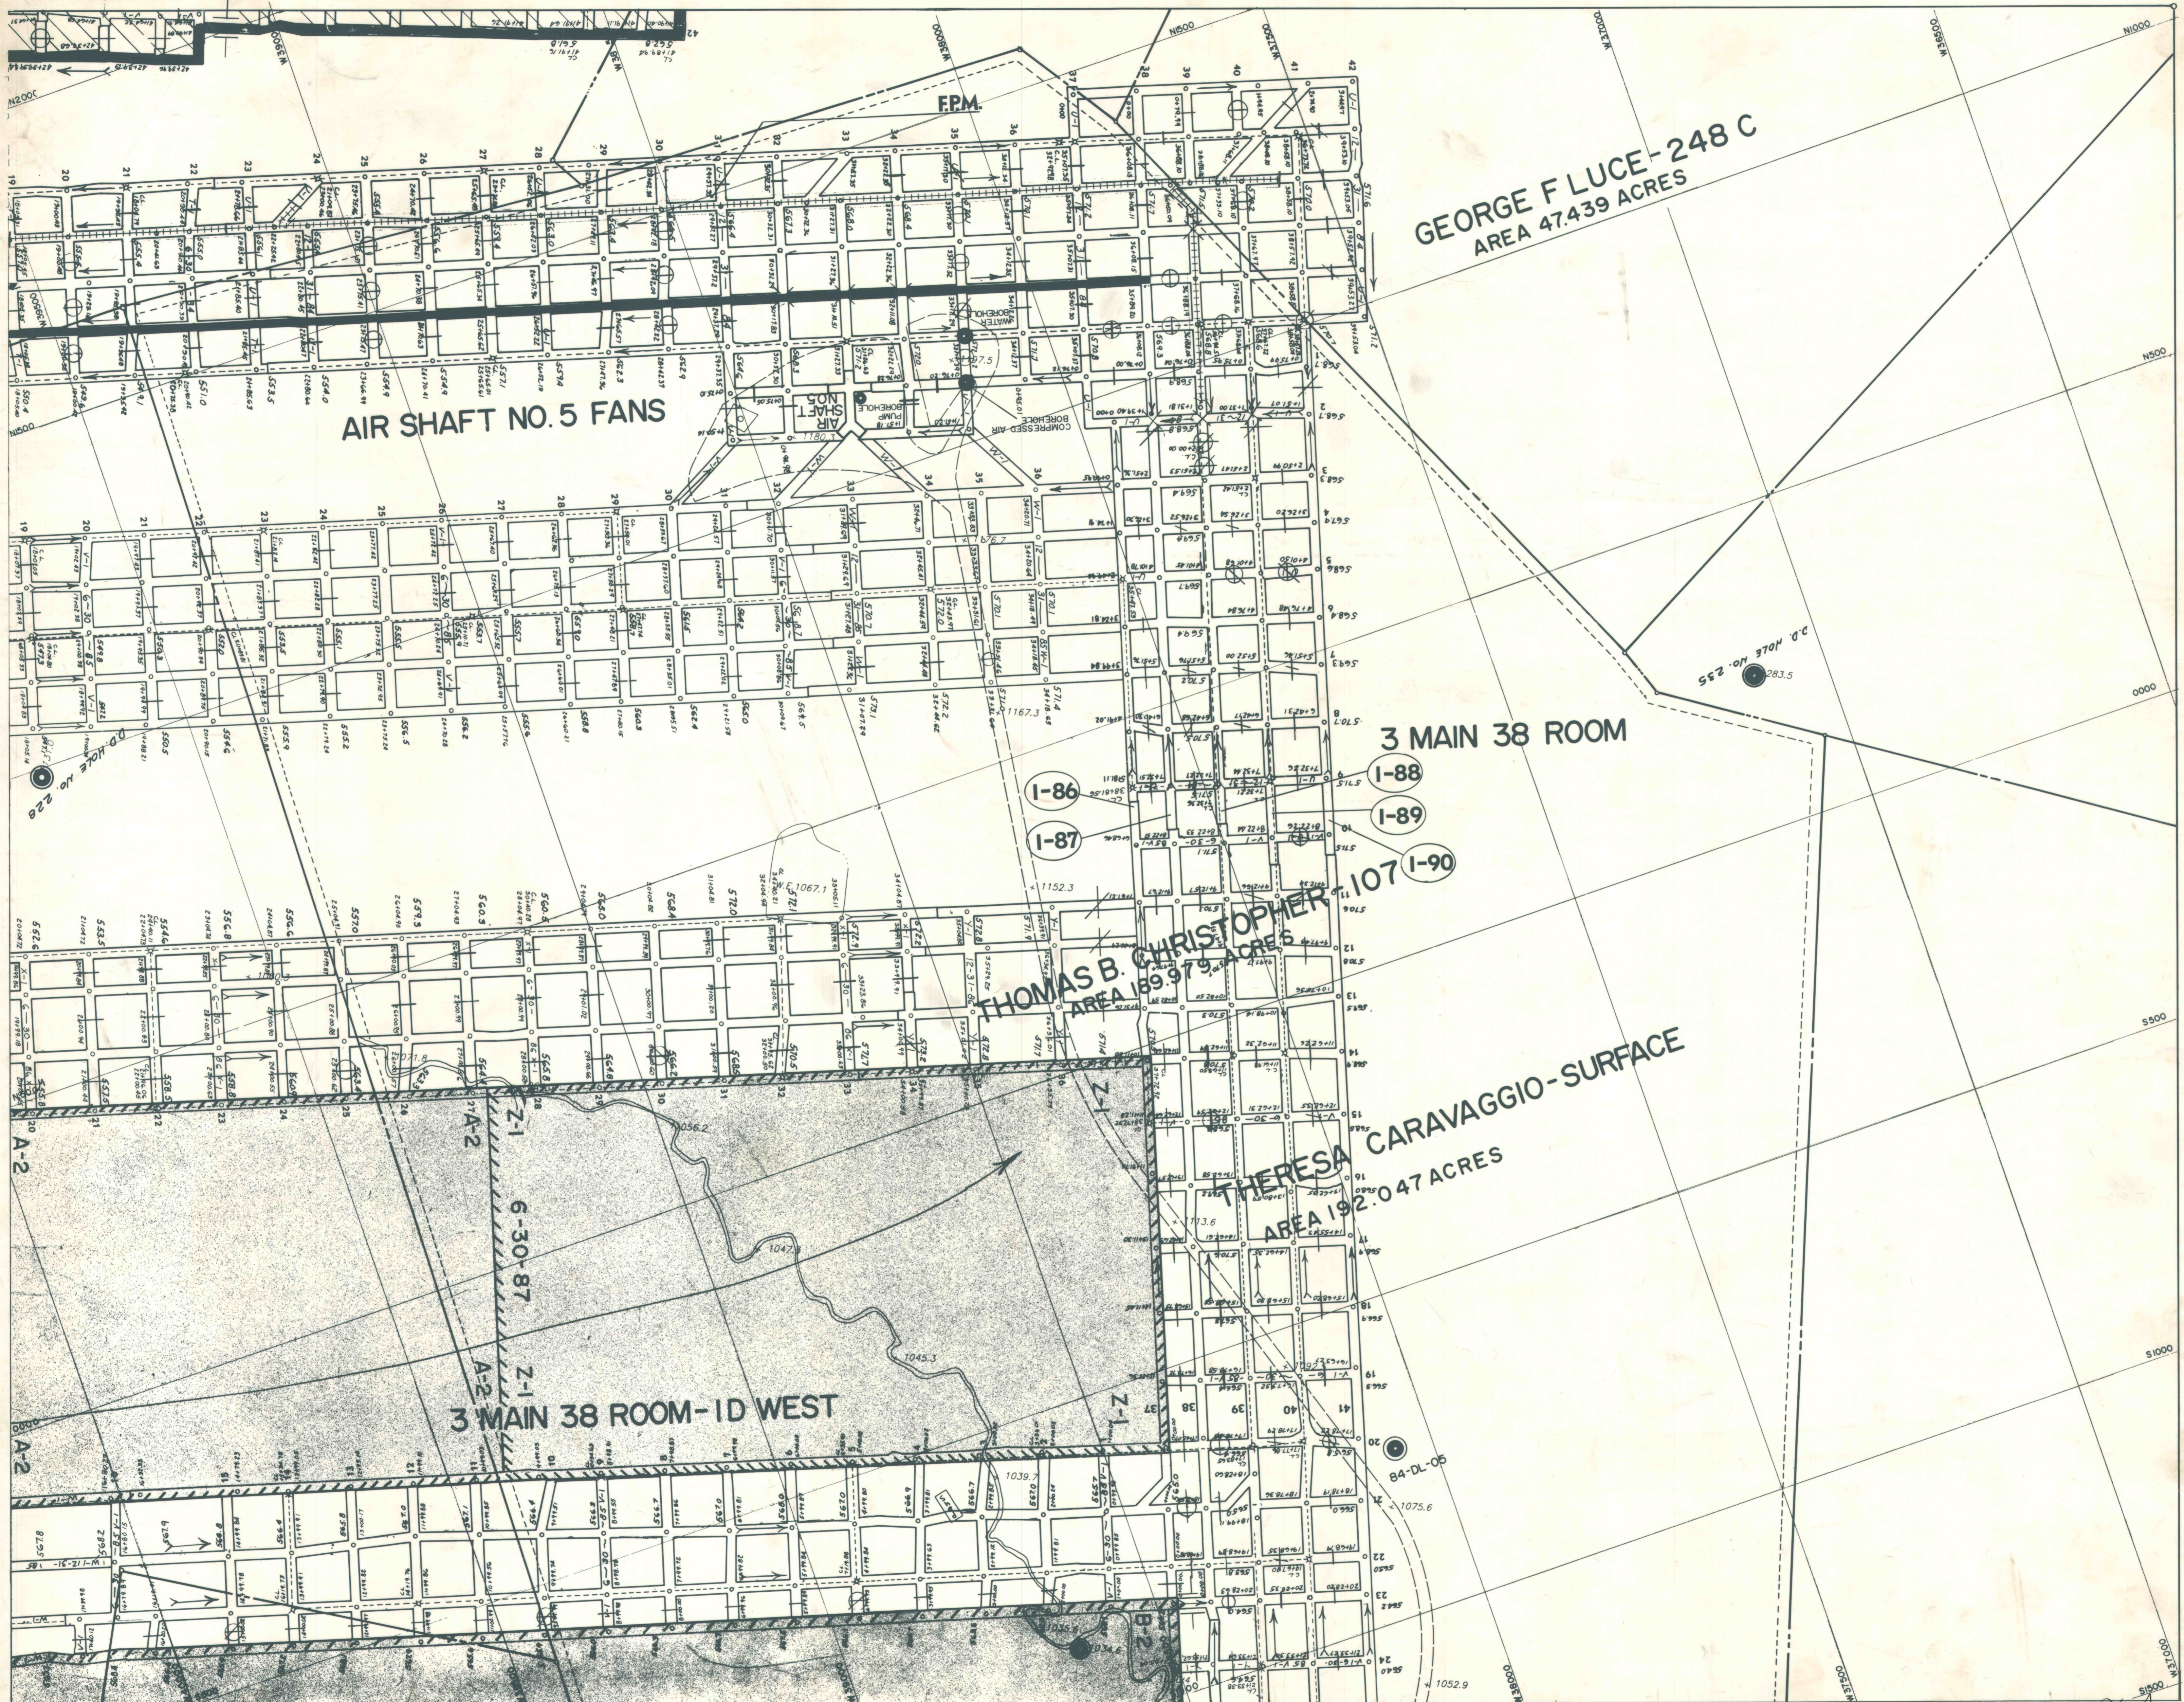

D.D. HOLE NO. 235

D.D. HOLE NO. 228

84-DL-06