
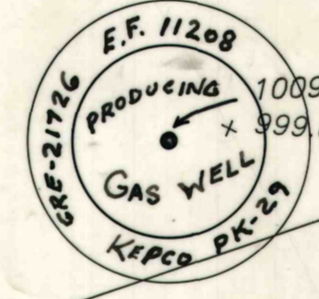


ANNA B. & G.F. LOUCE - 242
AREA 145.985 ACRES

GEORGE W. COX - 748
AREA 139.240 ACRES

J. CALVIN GWYNN - 965
AREA 24.862 ACRES

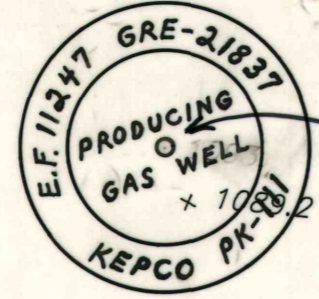

FIT TO 270

FIT TO 268

54000

FIT TO 278

DILWORTH 269

