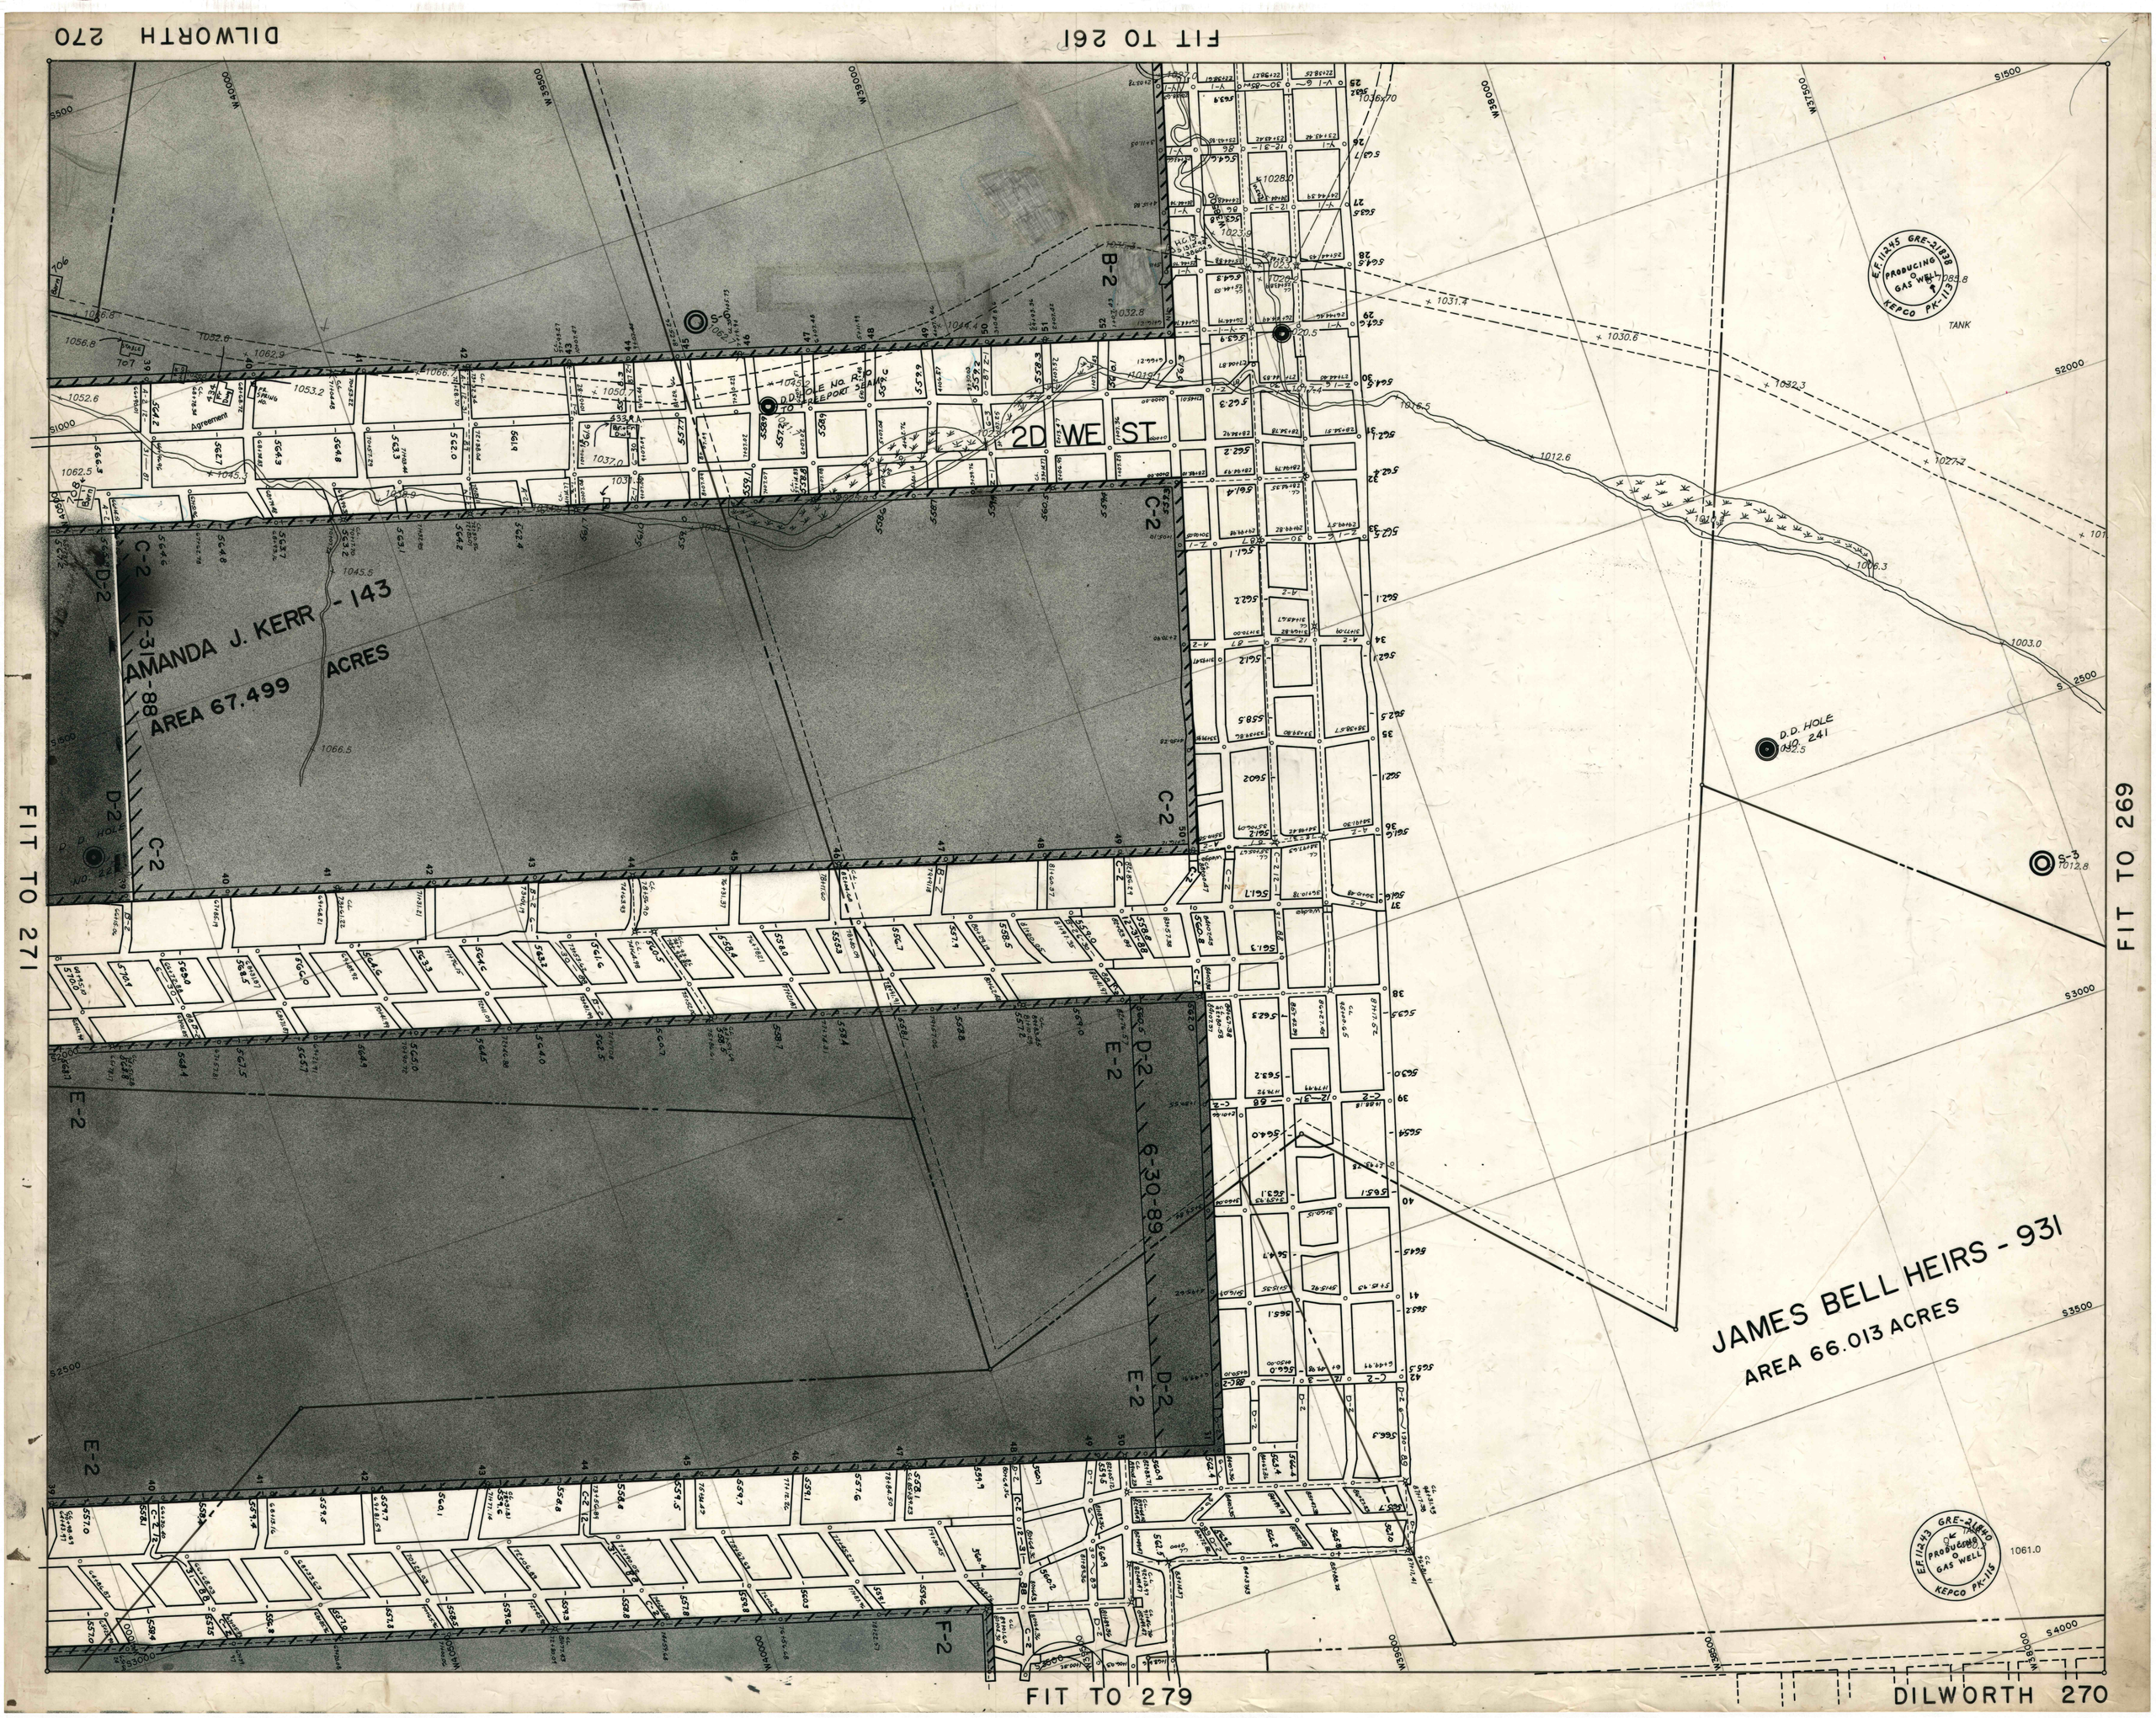

DILWORTH 270
FIT TO 261
FIT TO 271
FIT TO 269
FIT TO 279
DILWORTH 270
2D WE ST
AMANDA J. KERR - 143
AREA 67.499 ACRES
12-31-88
6-30-89
JAMES BELL HEIRS - 931
AREA 66.013 ACRES
D.D. HOLE NO. 241
TANK
PRODUCING GAS WELL
KEPCO PK-113
KEPCO PK-115