

FREEMAN KELLY - 82  
AREA 44.786 ACRES

DL-87-08  
1298.1


DL-88-09  
1230.0

1080.4  
Stone Dome  
H411A.A

W 50500  
S 85500



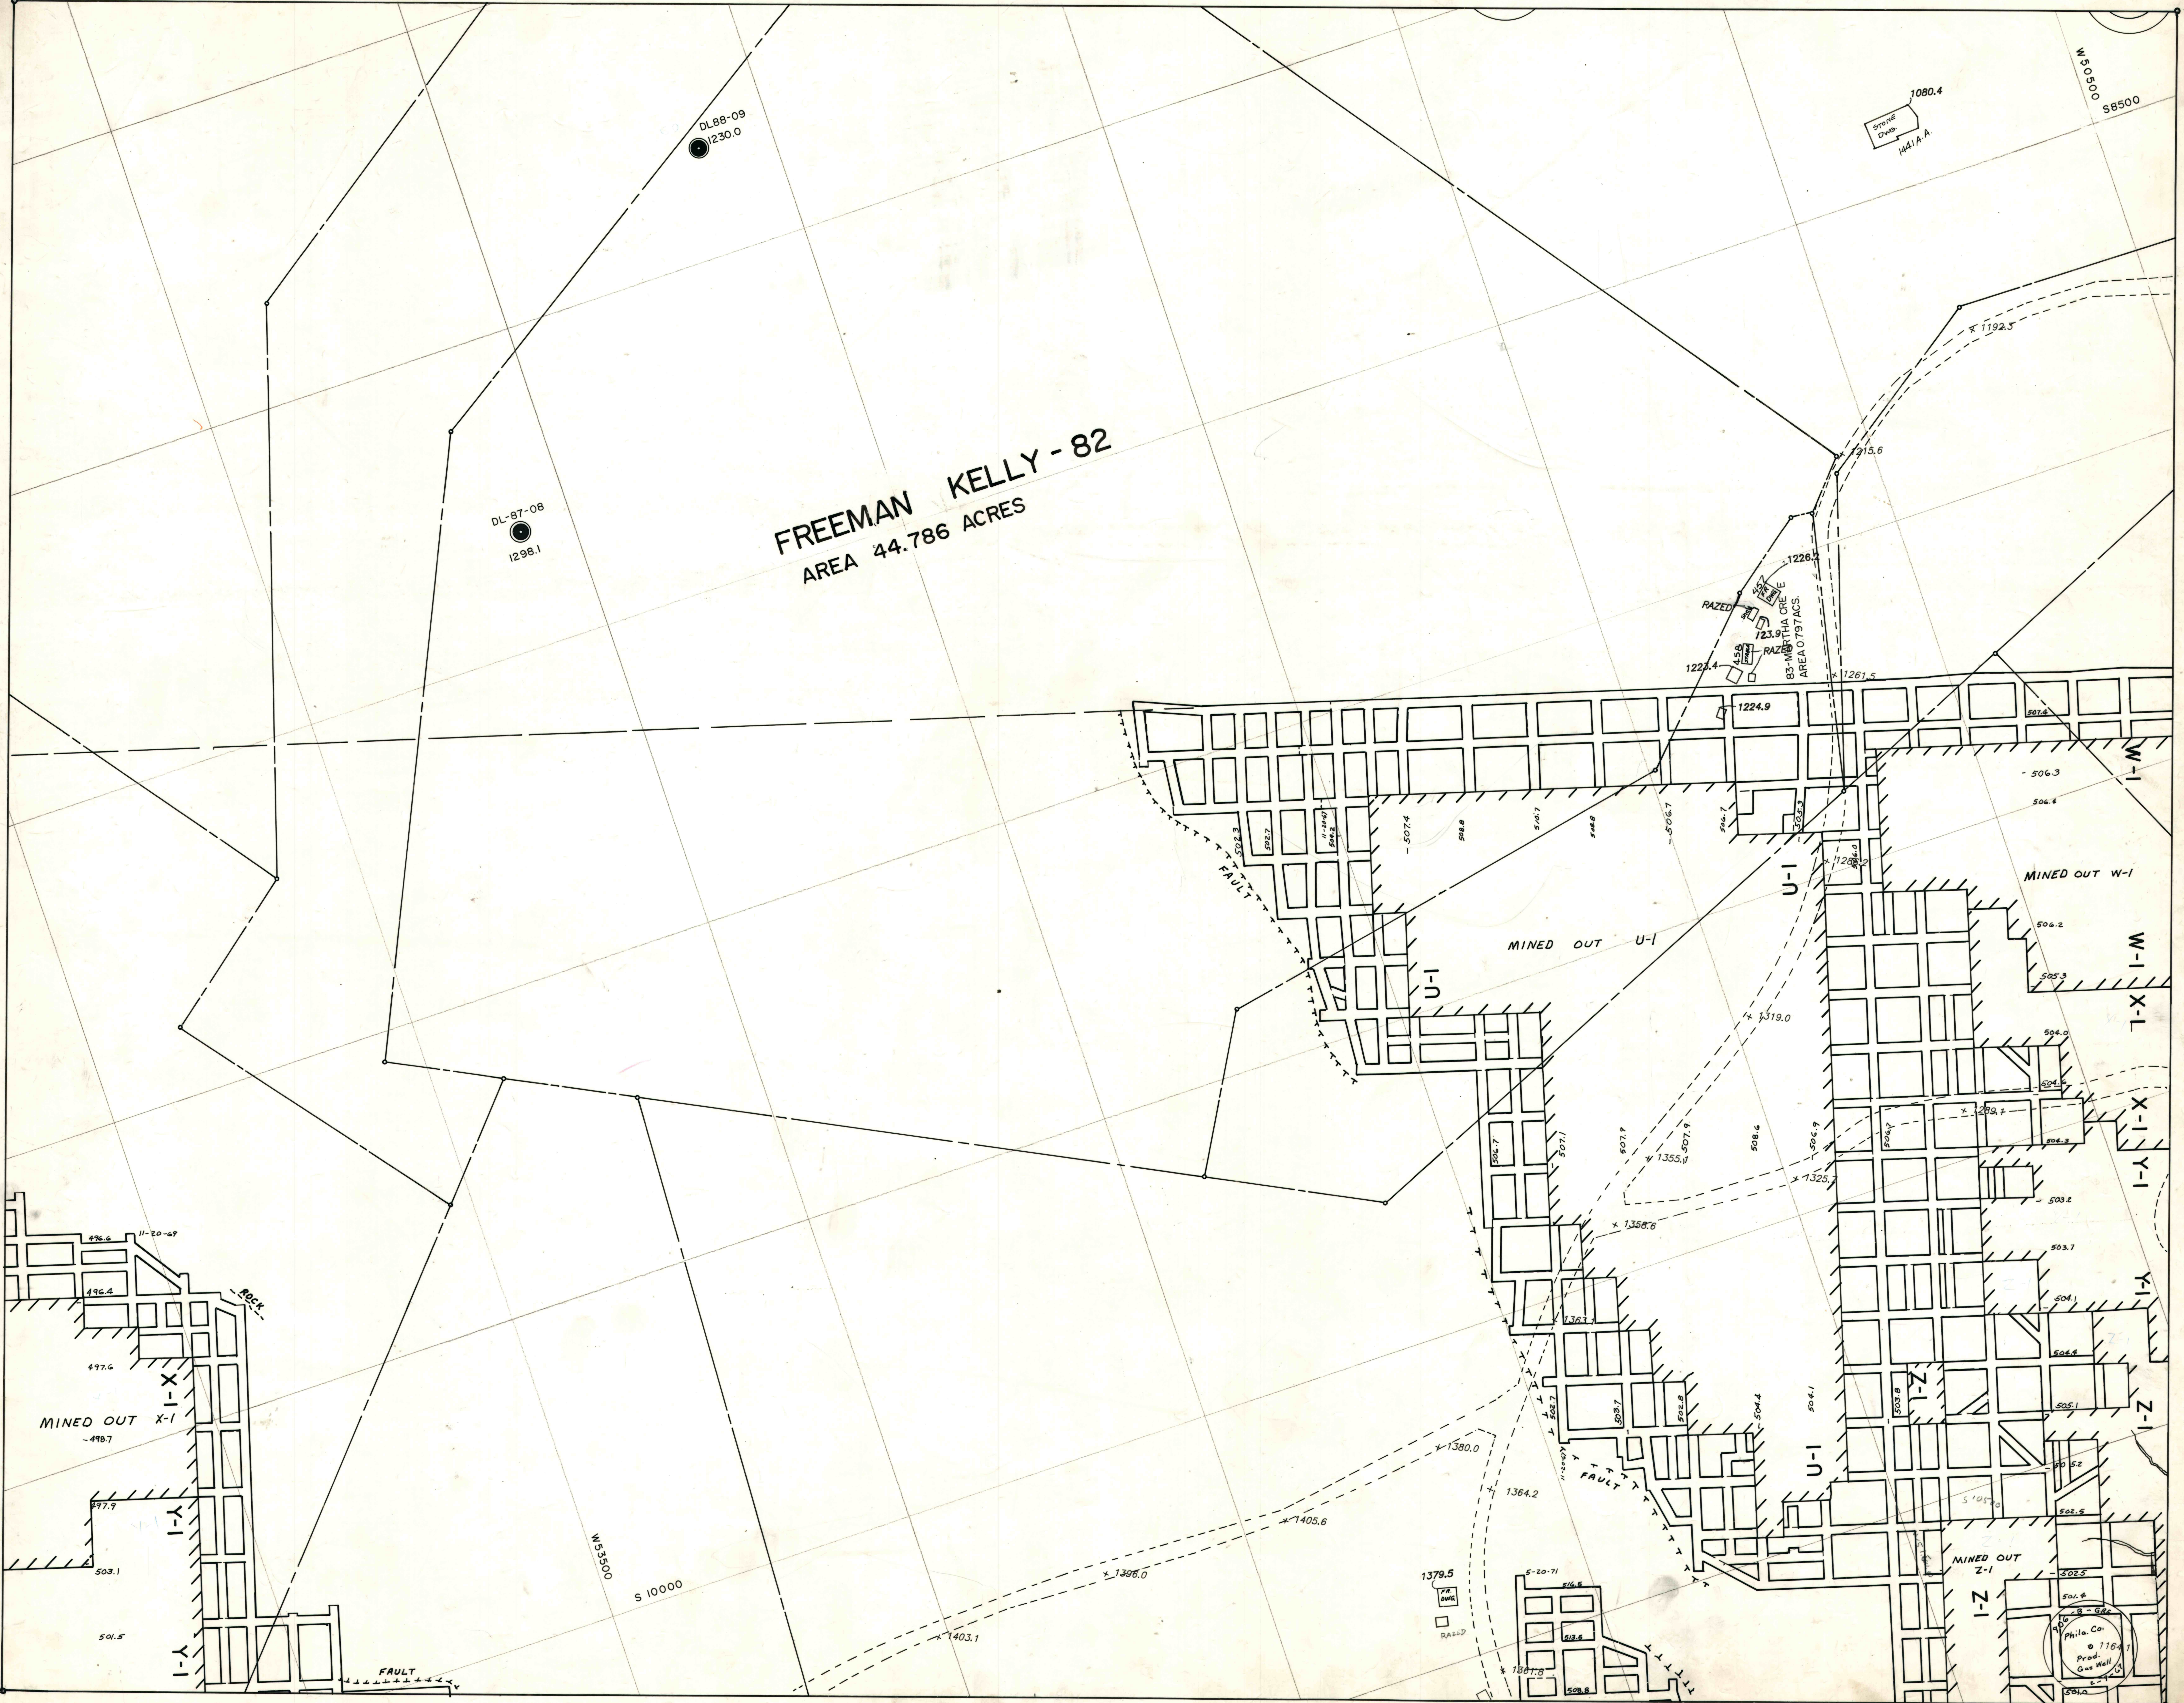

Phila. Co.  
