


M-2 12-31-93

FIT TO 306

FIT TO 304

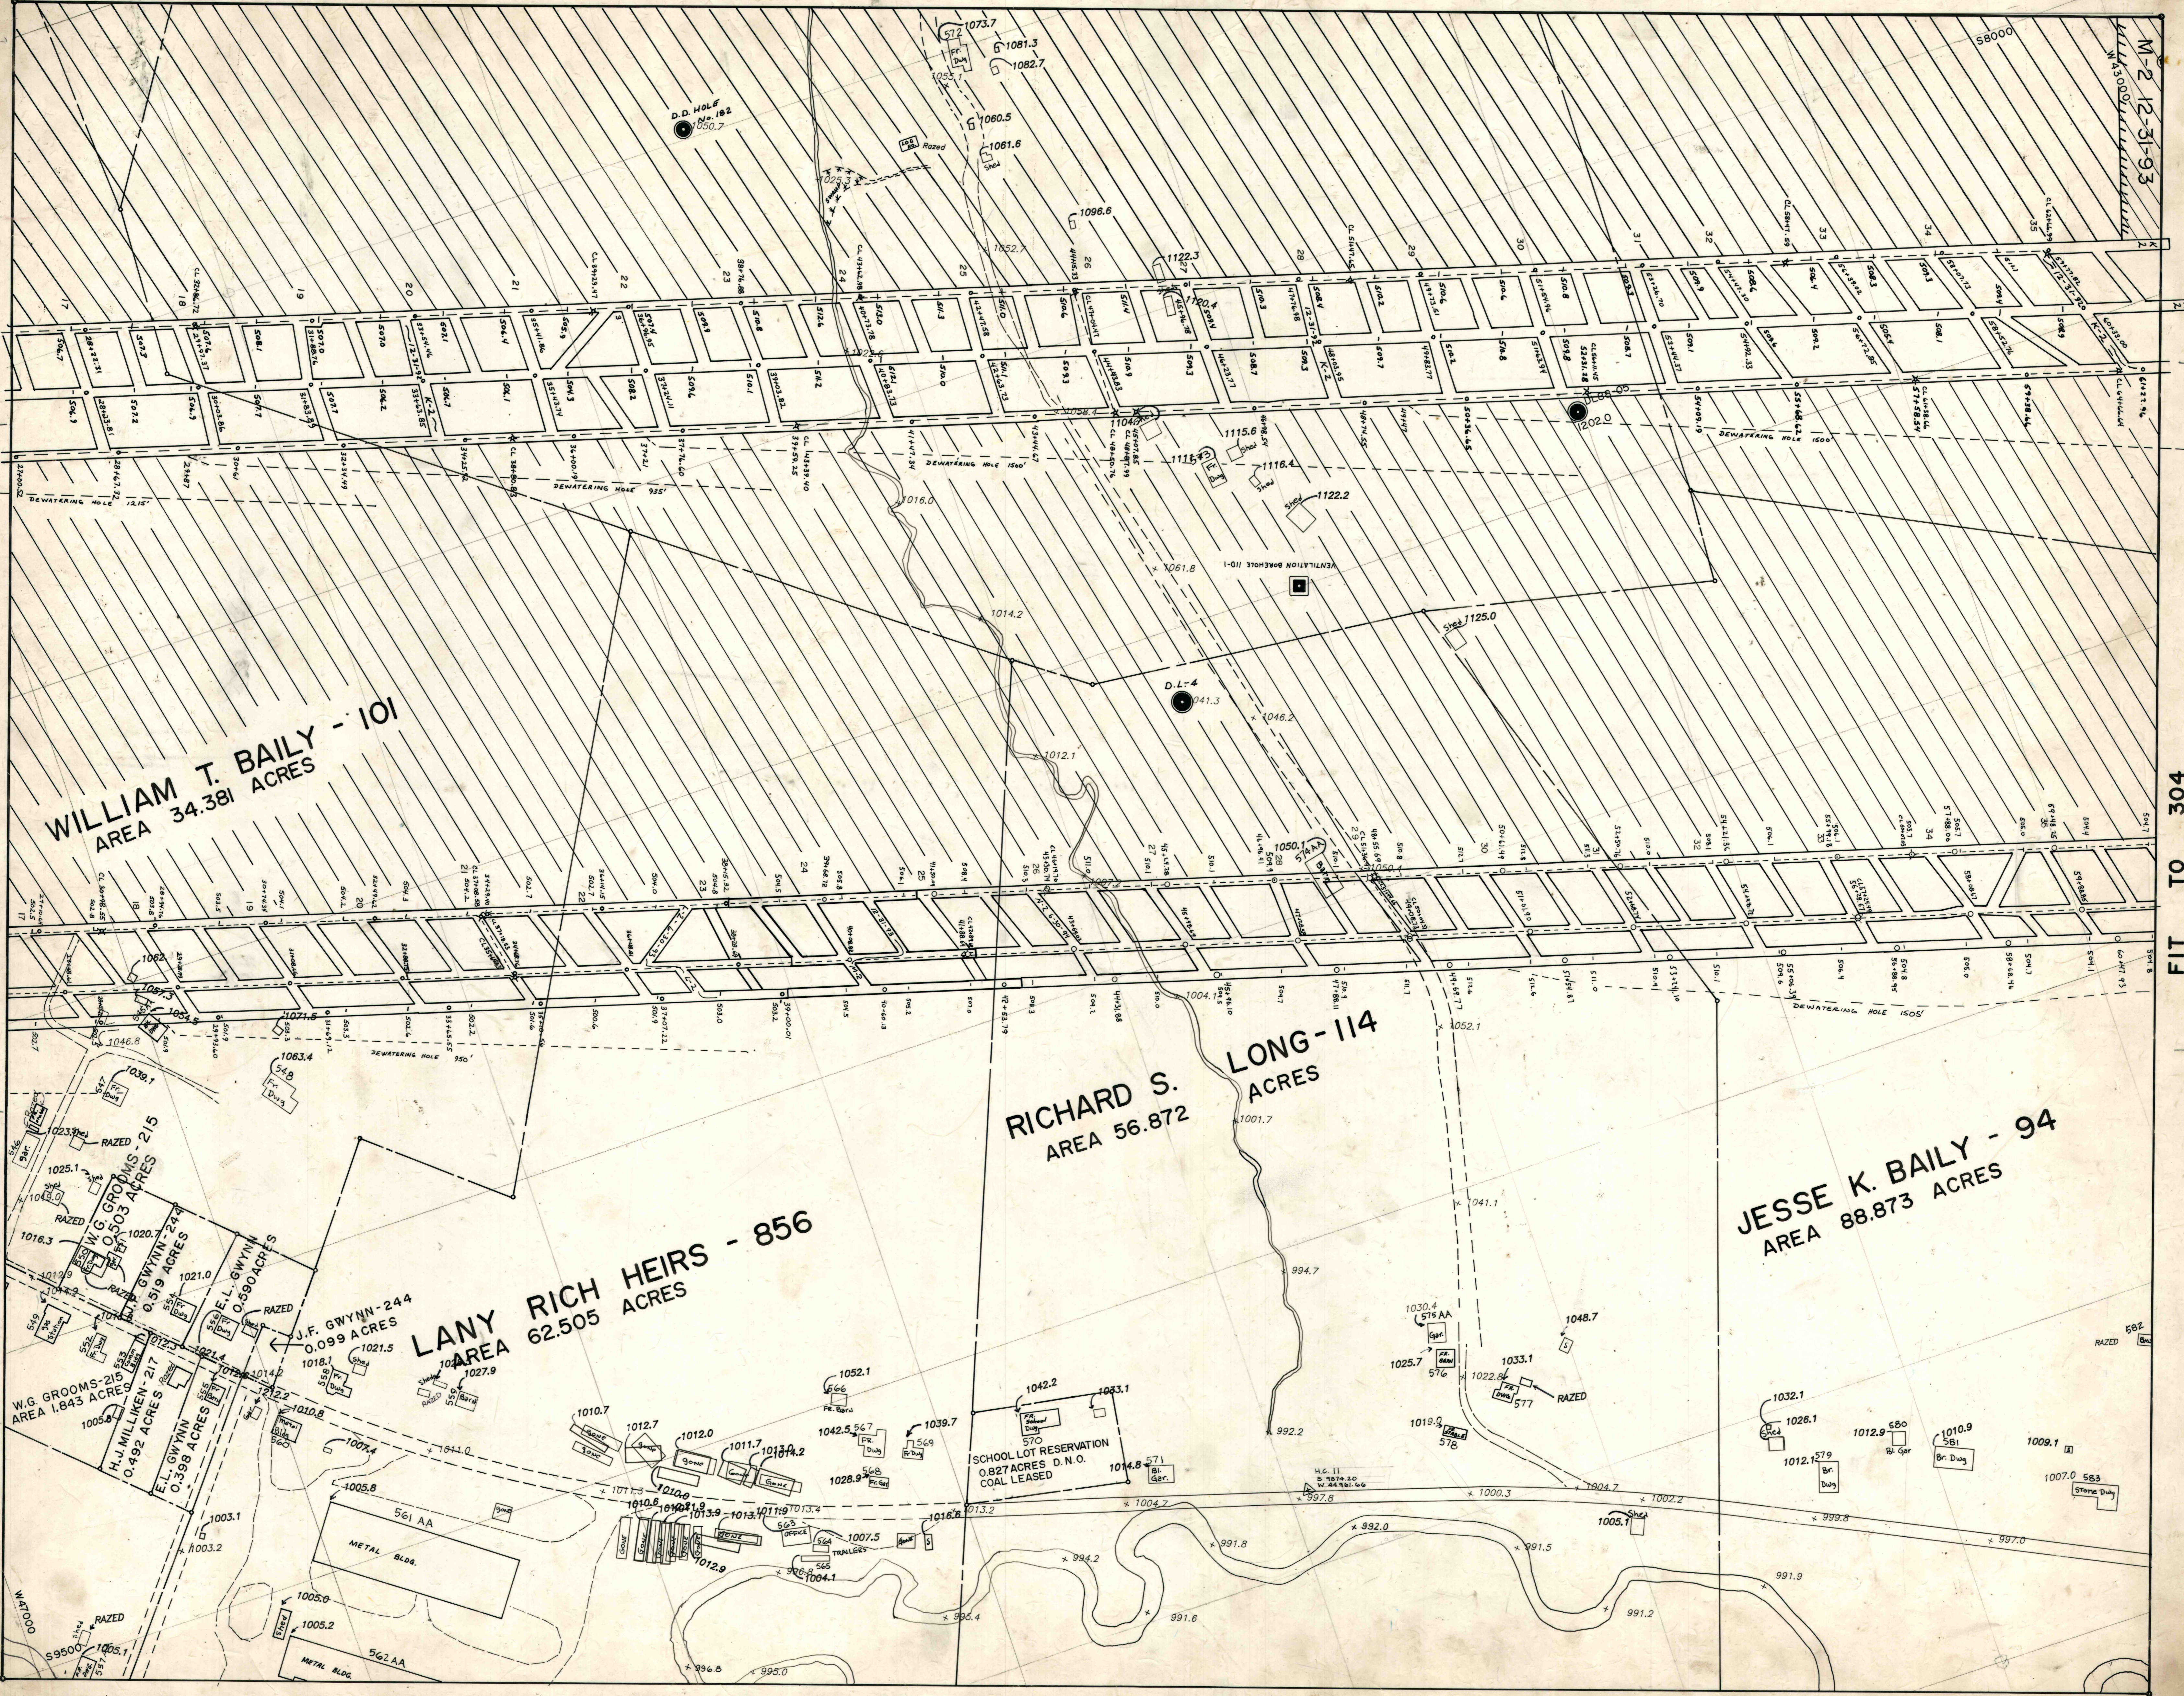

WILLIAM T. BAILY - 101
 AREA 34.381 ACRES

RICHARD S. LONG - 114
 AREA 56.872 ACRES

JESSE K. BAILY - 94
 AREA 88.873 ACRES

LANY RICH HEIRS - 856
 AREA 62.505 ACRES

W.G. GROOMS - 215
 AREA 1.843 ACRES

H.J. MILLIKEN - 217
 0.492 ACRES

E.L. GWYNN - 249
 0.519 ACRES

J.F. GWYNN - 244
 0.099 ACRES

SCHOOL LOT RESERVATION
 0.827 ACRES D.N.O.
 COAL LEASED