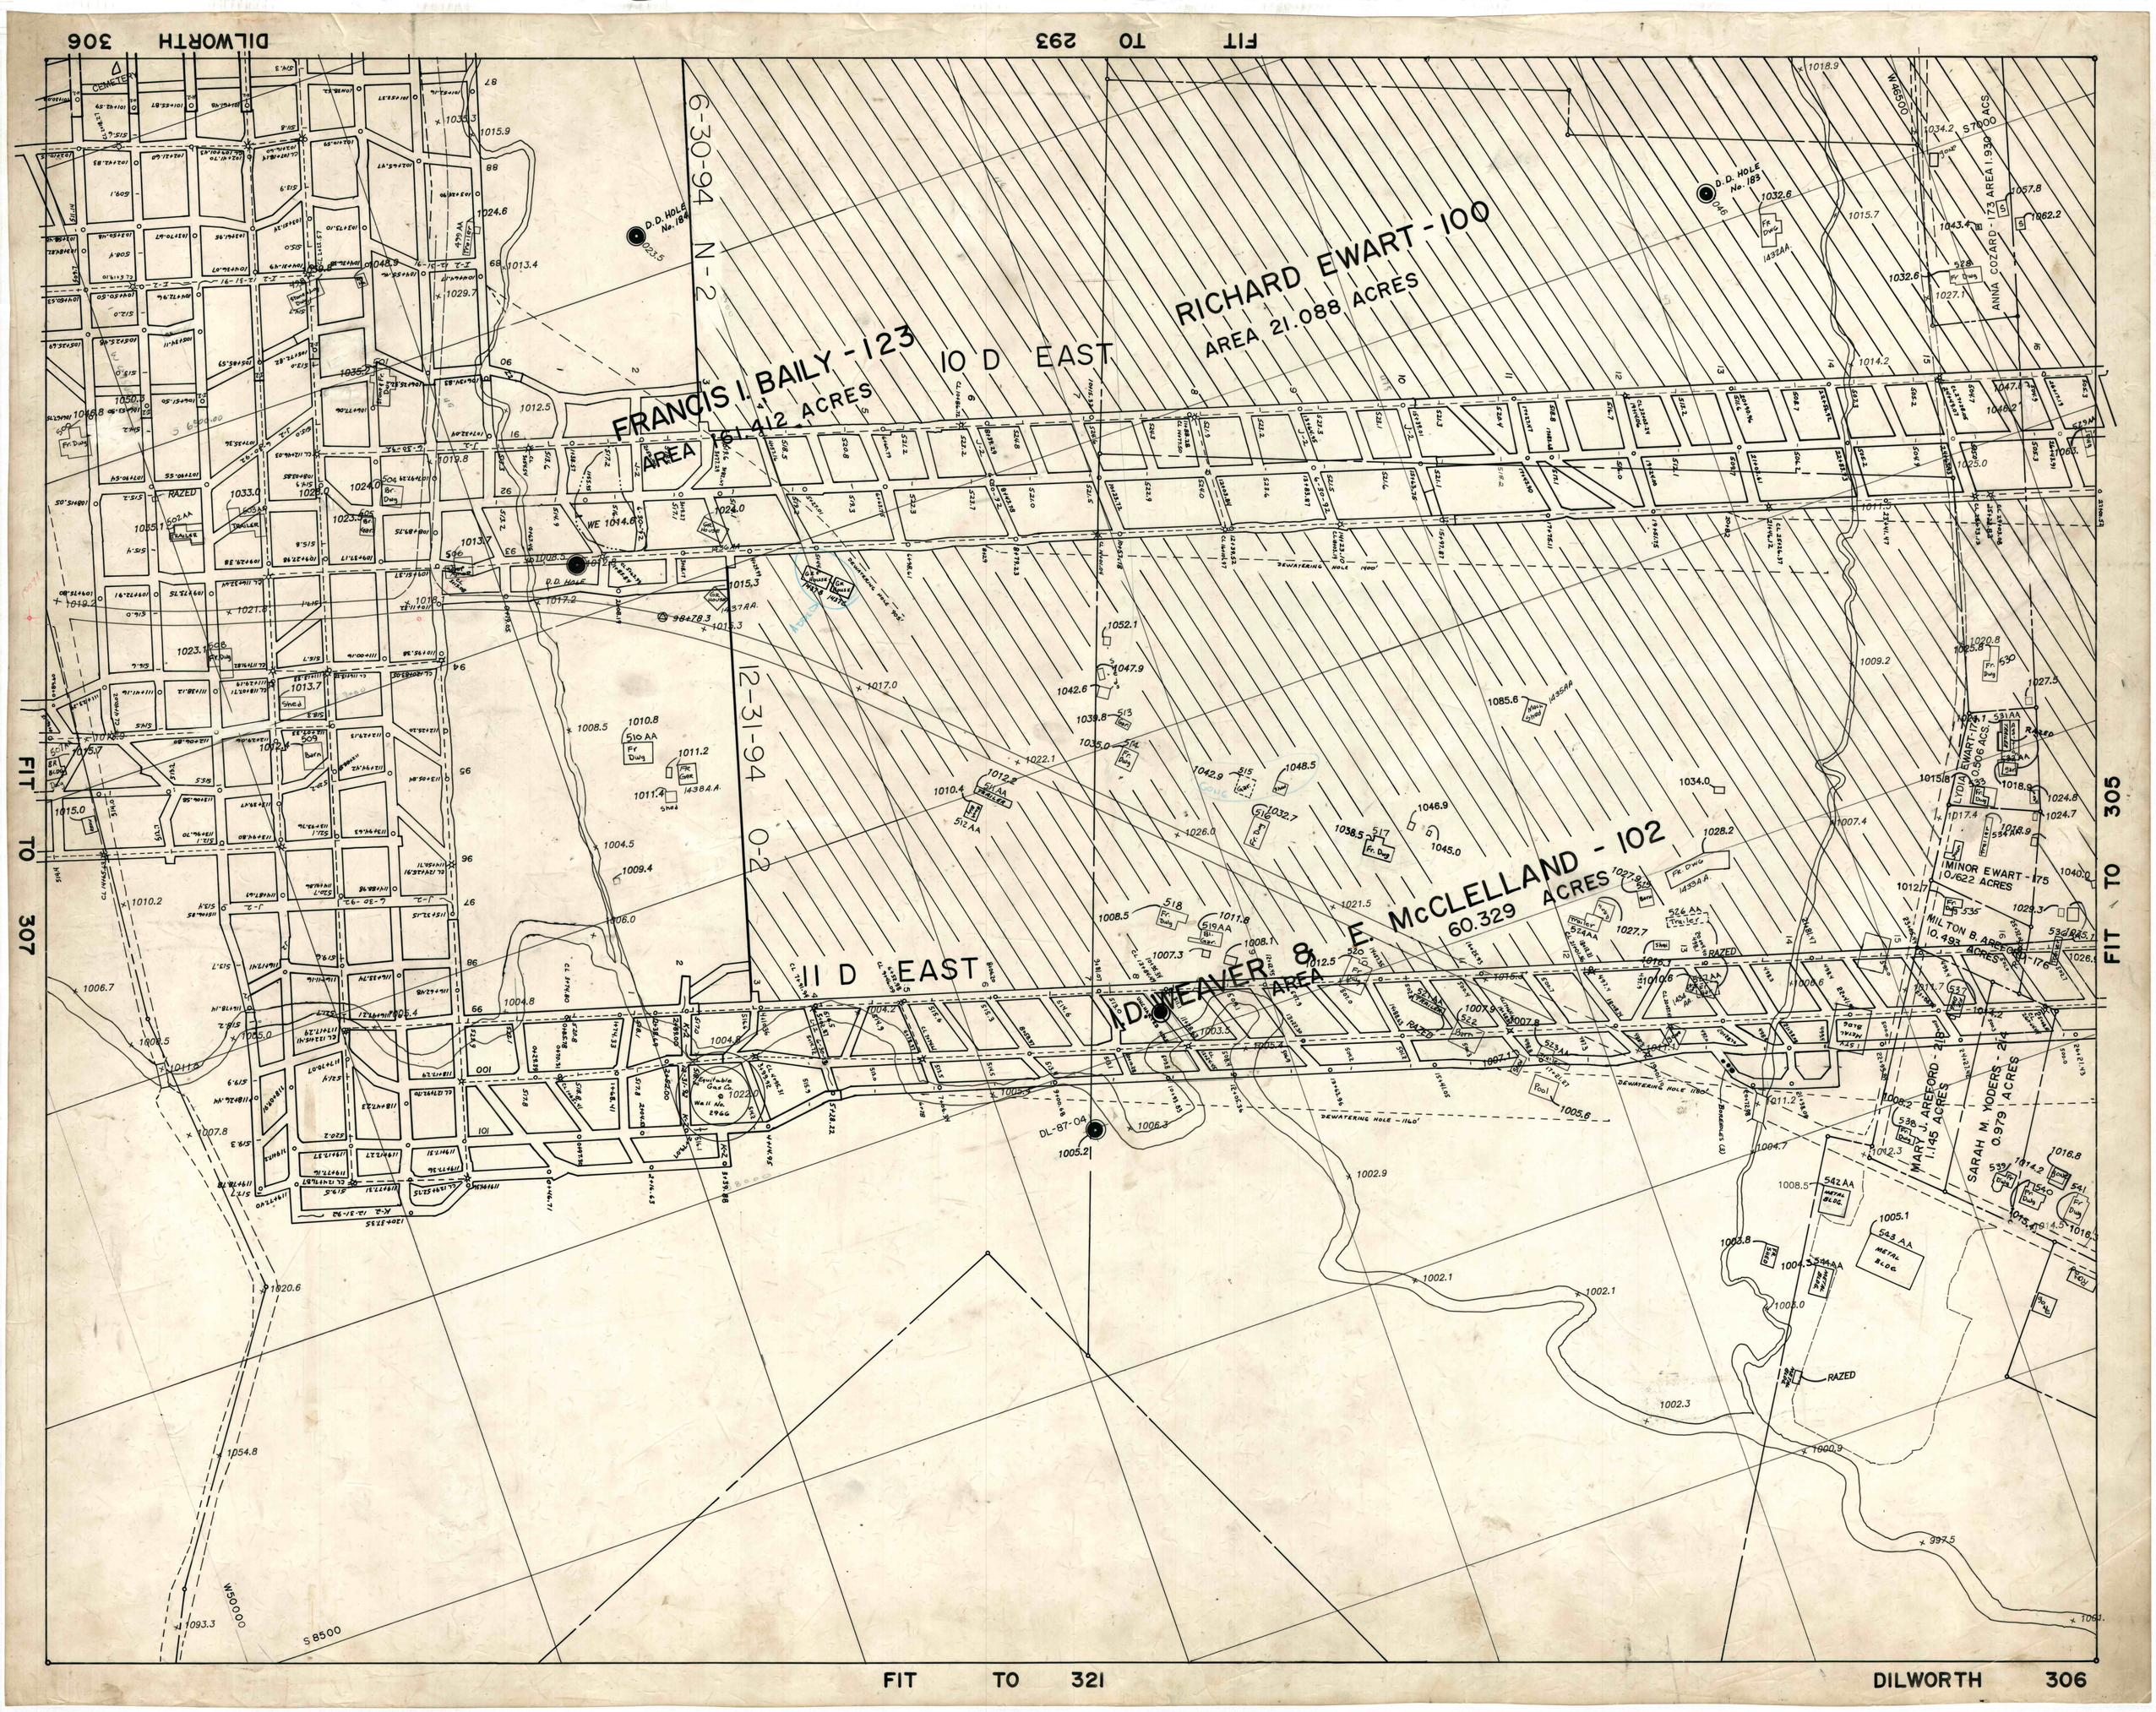

DILWORTH 306
FIT TO 293
FIT TO 307
FIT TO 305
FIT TO 321
DILWORTH 306
RICHARD EWART - 100
AREA 21.088 ACRES
FRANCIS I. BAILY - 123
AREA 161.412 ACRES
10 D EAST
11 D EAST
6-30-94 N-2
12-31-94 O-2
D.D. HOLE No. 184
D.D. HOLE No. 183
D.D. HOLE
DL-87-04
ANNA COZARD - 173 AREA 1.930 ACS
LYDIA EWART - 174 0.506 ACS
MINOR EWART - 175 0.622 ACRES
MILTON B. AREFORD - 176 10.493 ACRES
MARY J. AREFORD - 218 1.145 ACRES
SARAH M. YODERS - 214 0.979 ACRES
ID WEAVER & E. McCLELLAND - 102
AREA 60.329 ACRES
DEWATERING HOLE - 1160'
DEWATERING HOLE 1400'
RAZED
S 8500
W 50000
W 46500
S 7000