


MATHER MINE  
MATHER COLLIERIES COMPANY

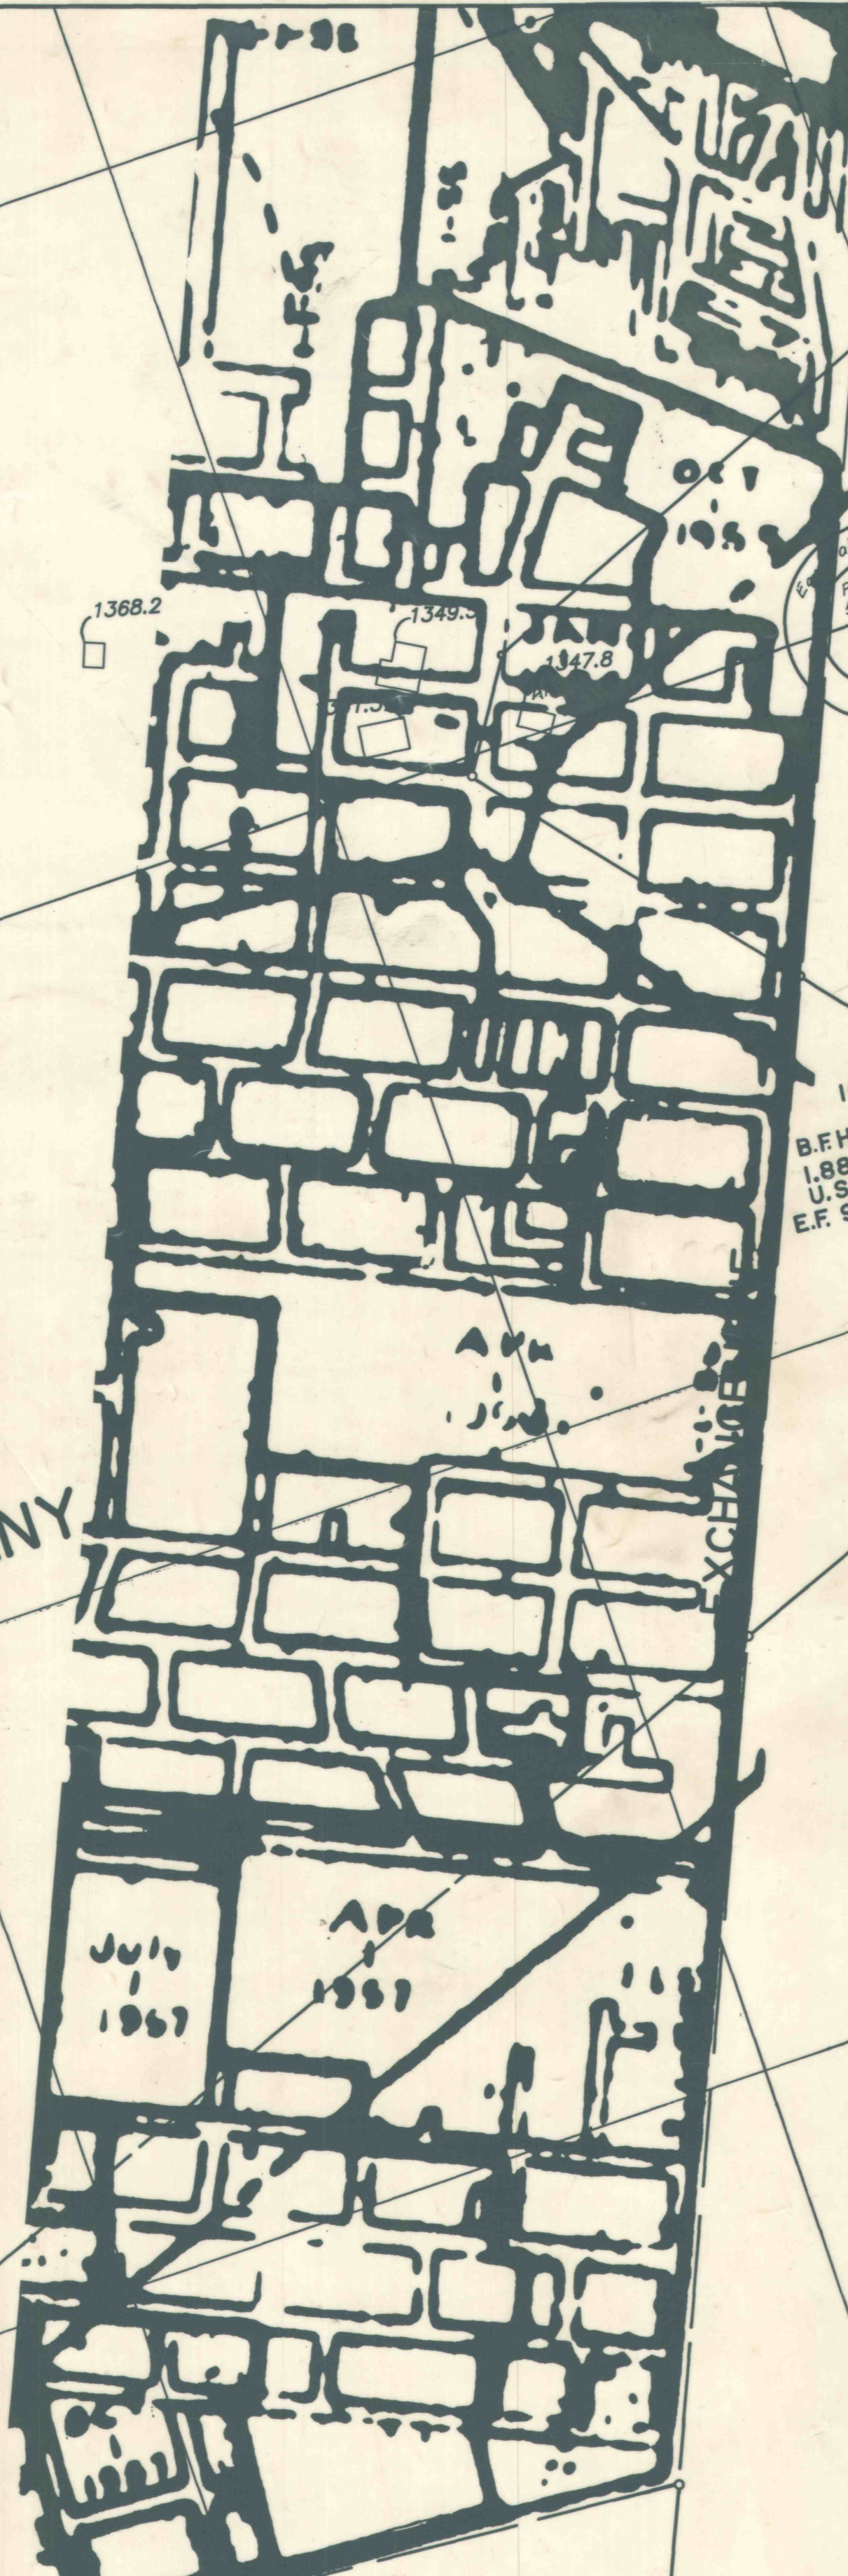

1019  
B.F. HOFFACKER  
1889 ACRES TO  
U.S. STEEL CORP.  
E.F. 9248 14-C-219  
10-18-54

COLUMBUS M. SCOTT - 200  
AREA 61.520 ACRES

Equitable Gas  
Abandoned  
1118.0  
4-22-10