


VOID

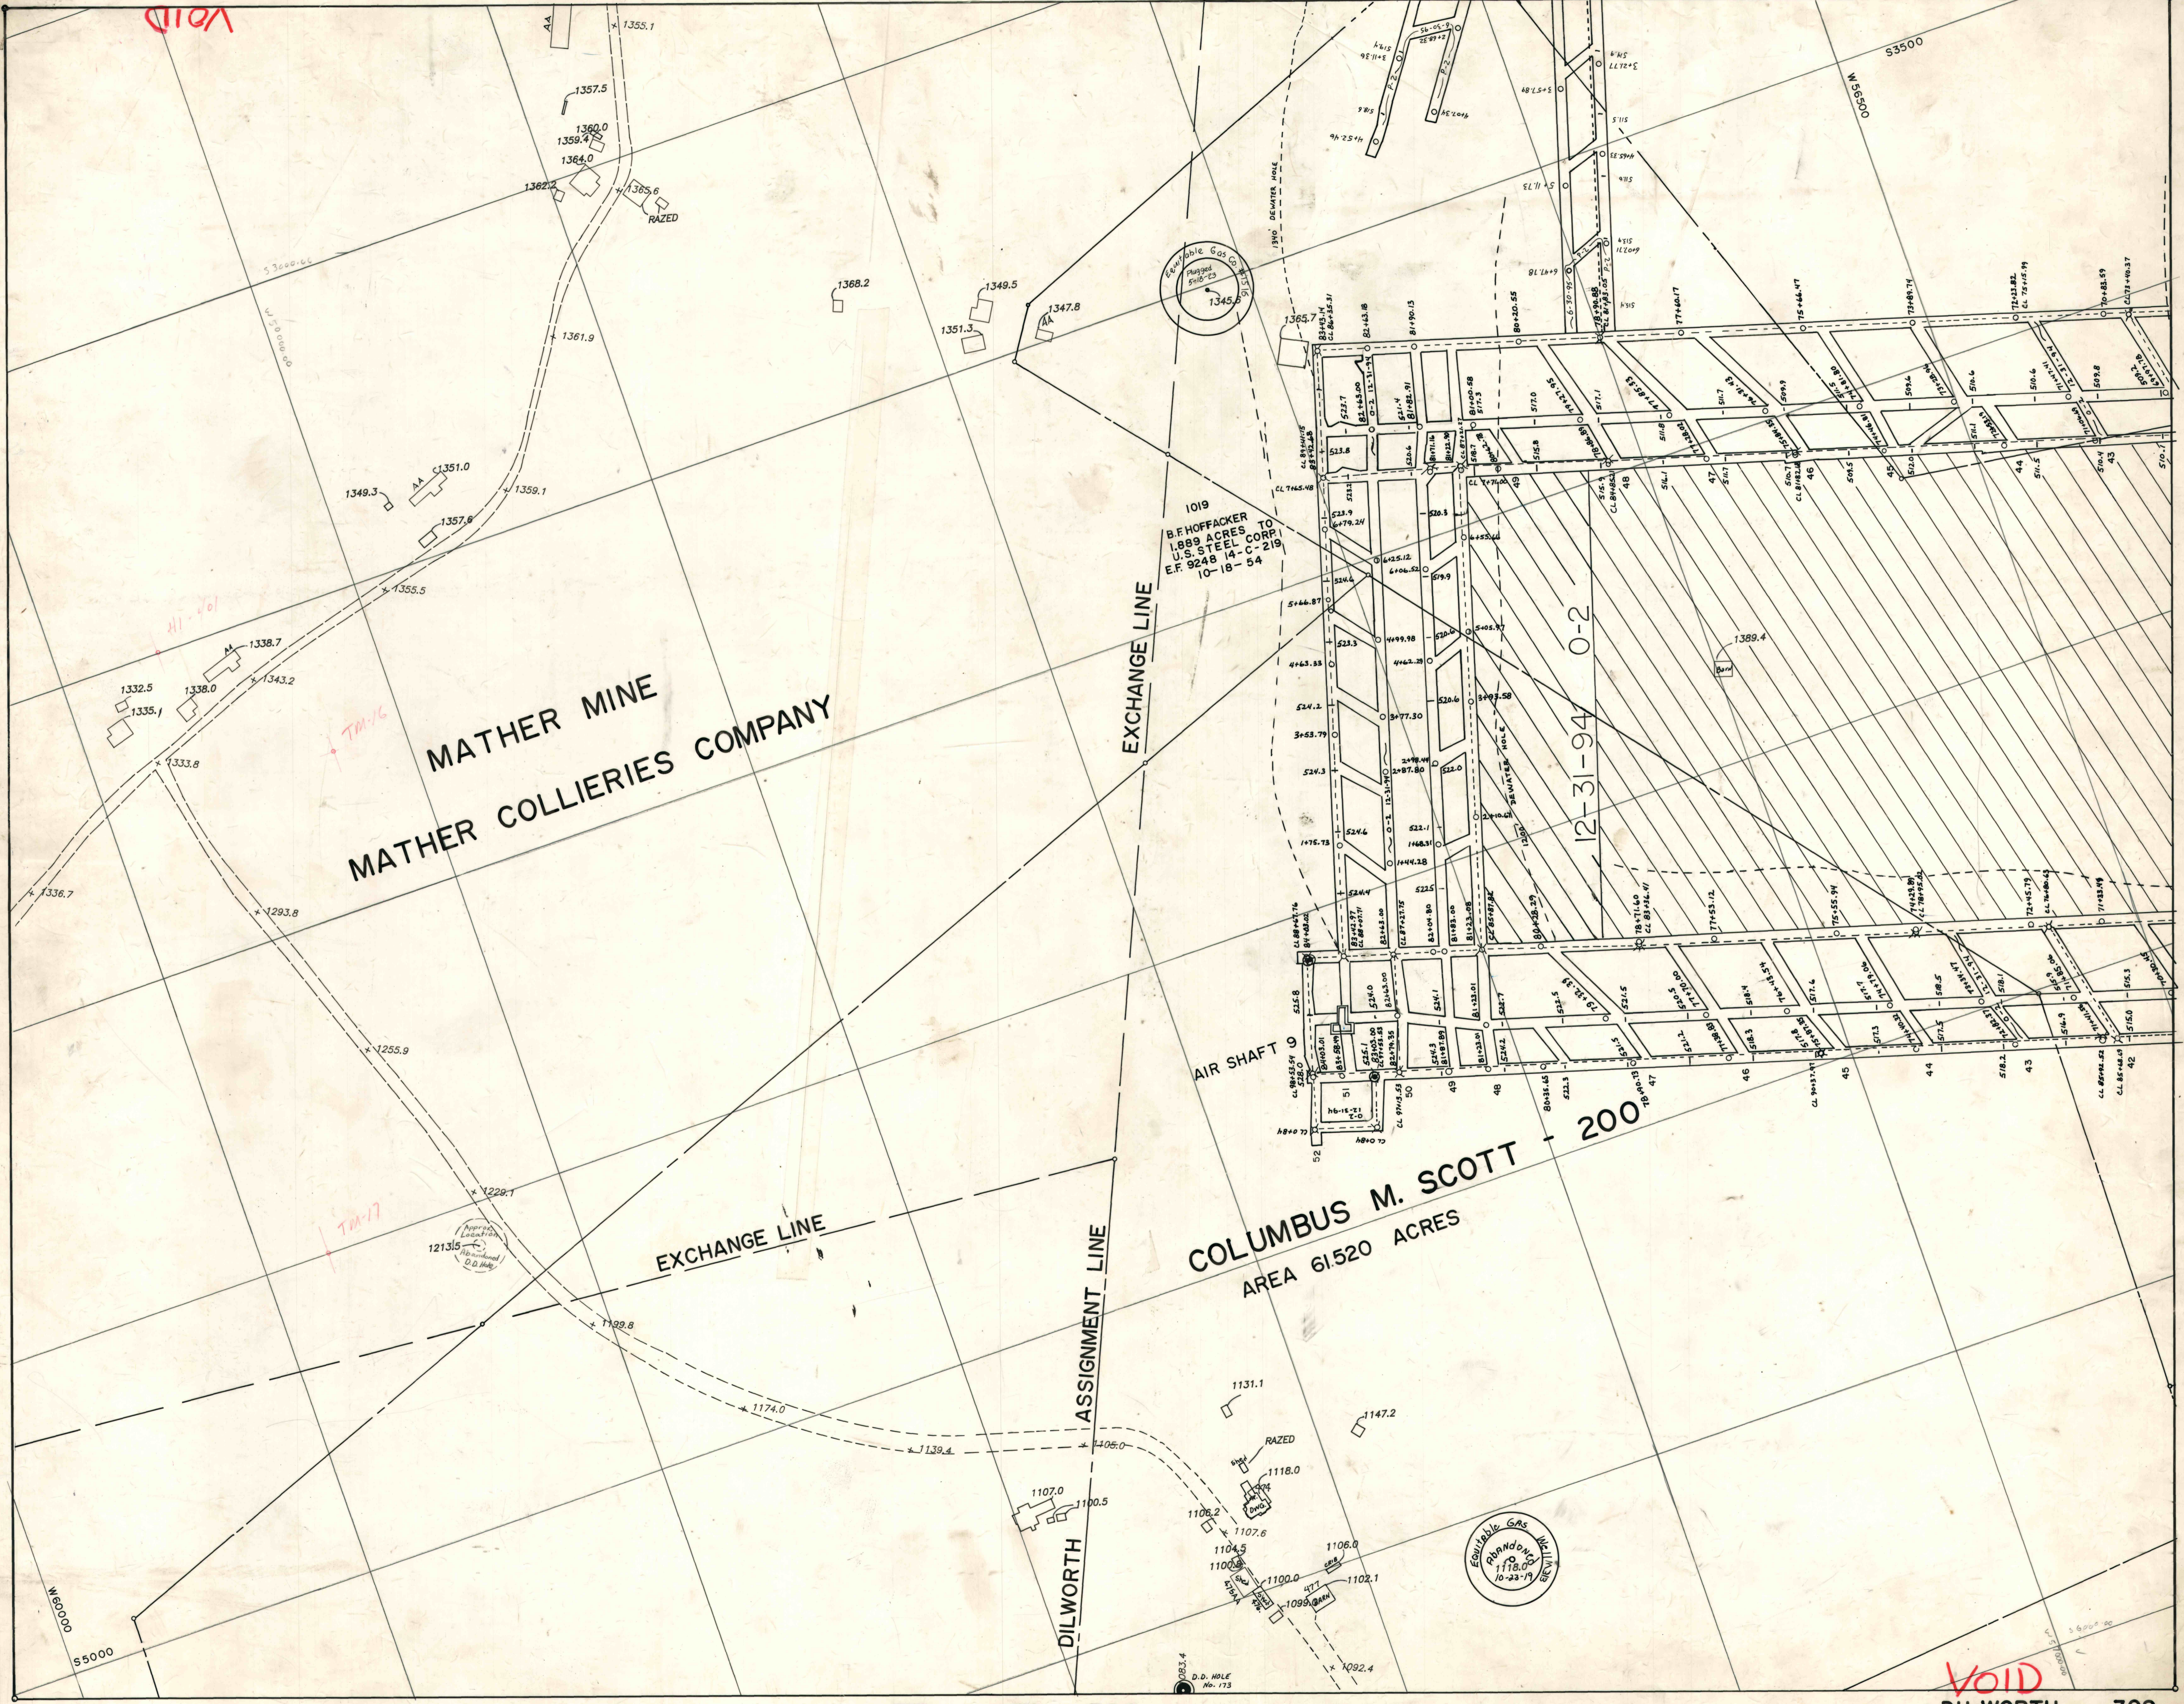

MATHER MINE
 MATHER COLLIERIES COMPANY

1019
 B.F. HOFFACKER
 1.889 ACRES TO
 U.S. STEEL CORP.
 E.F. 9248 14-C-219
 10-18-54

COLUMBUS M. SCOTT - 200
 AREA 61.520 ACRES

DILWORTH

VOID