


SAMUEL HORNER -32
AREA 21.713 ACRES

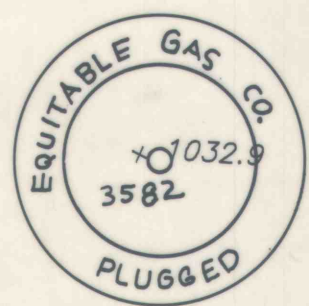

FIT TO 260B

