



WINFIELD REGISTER-28

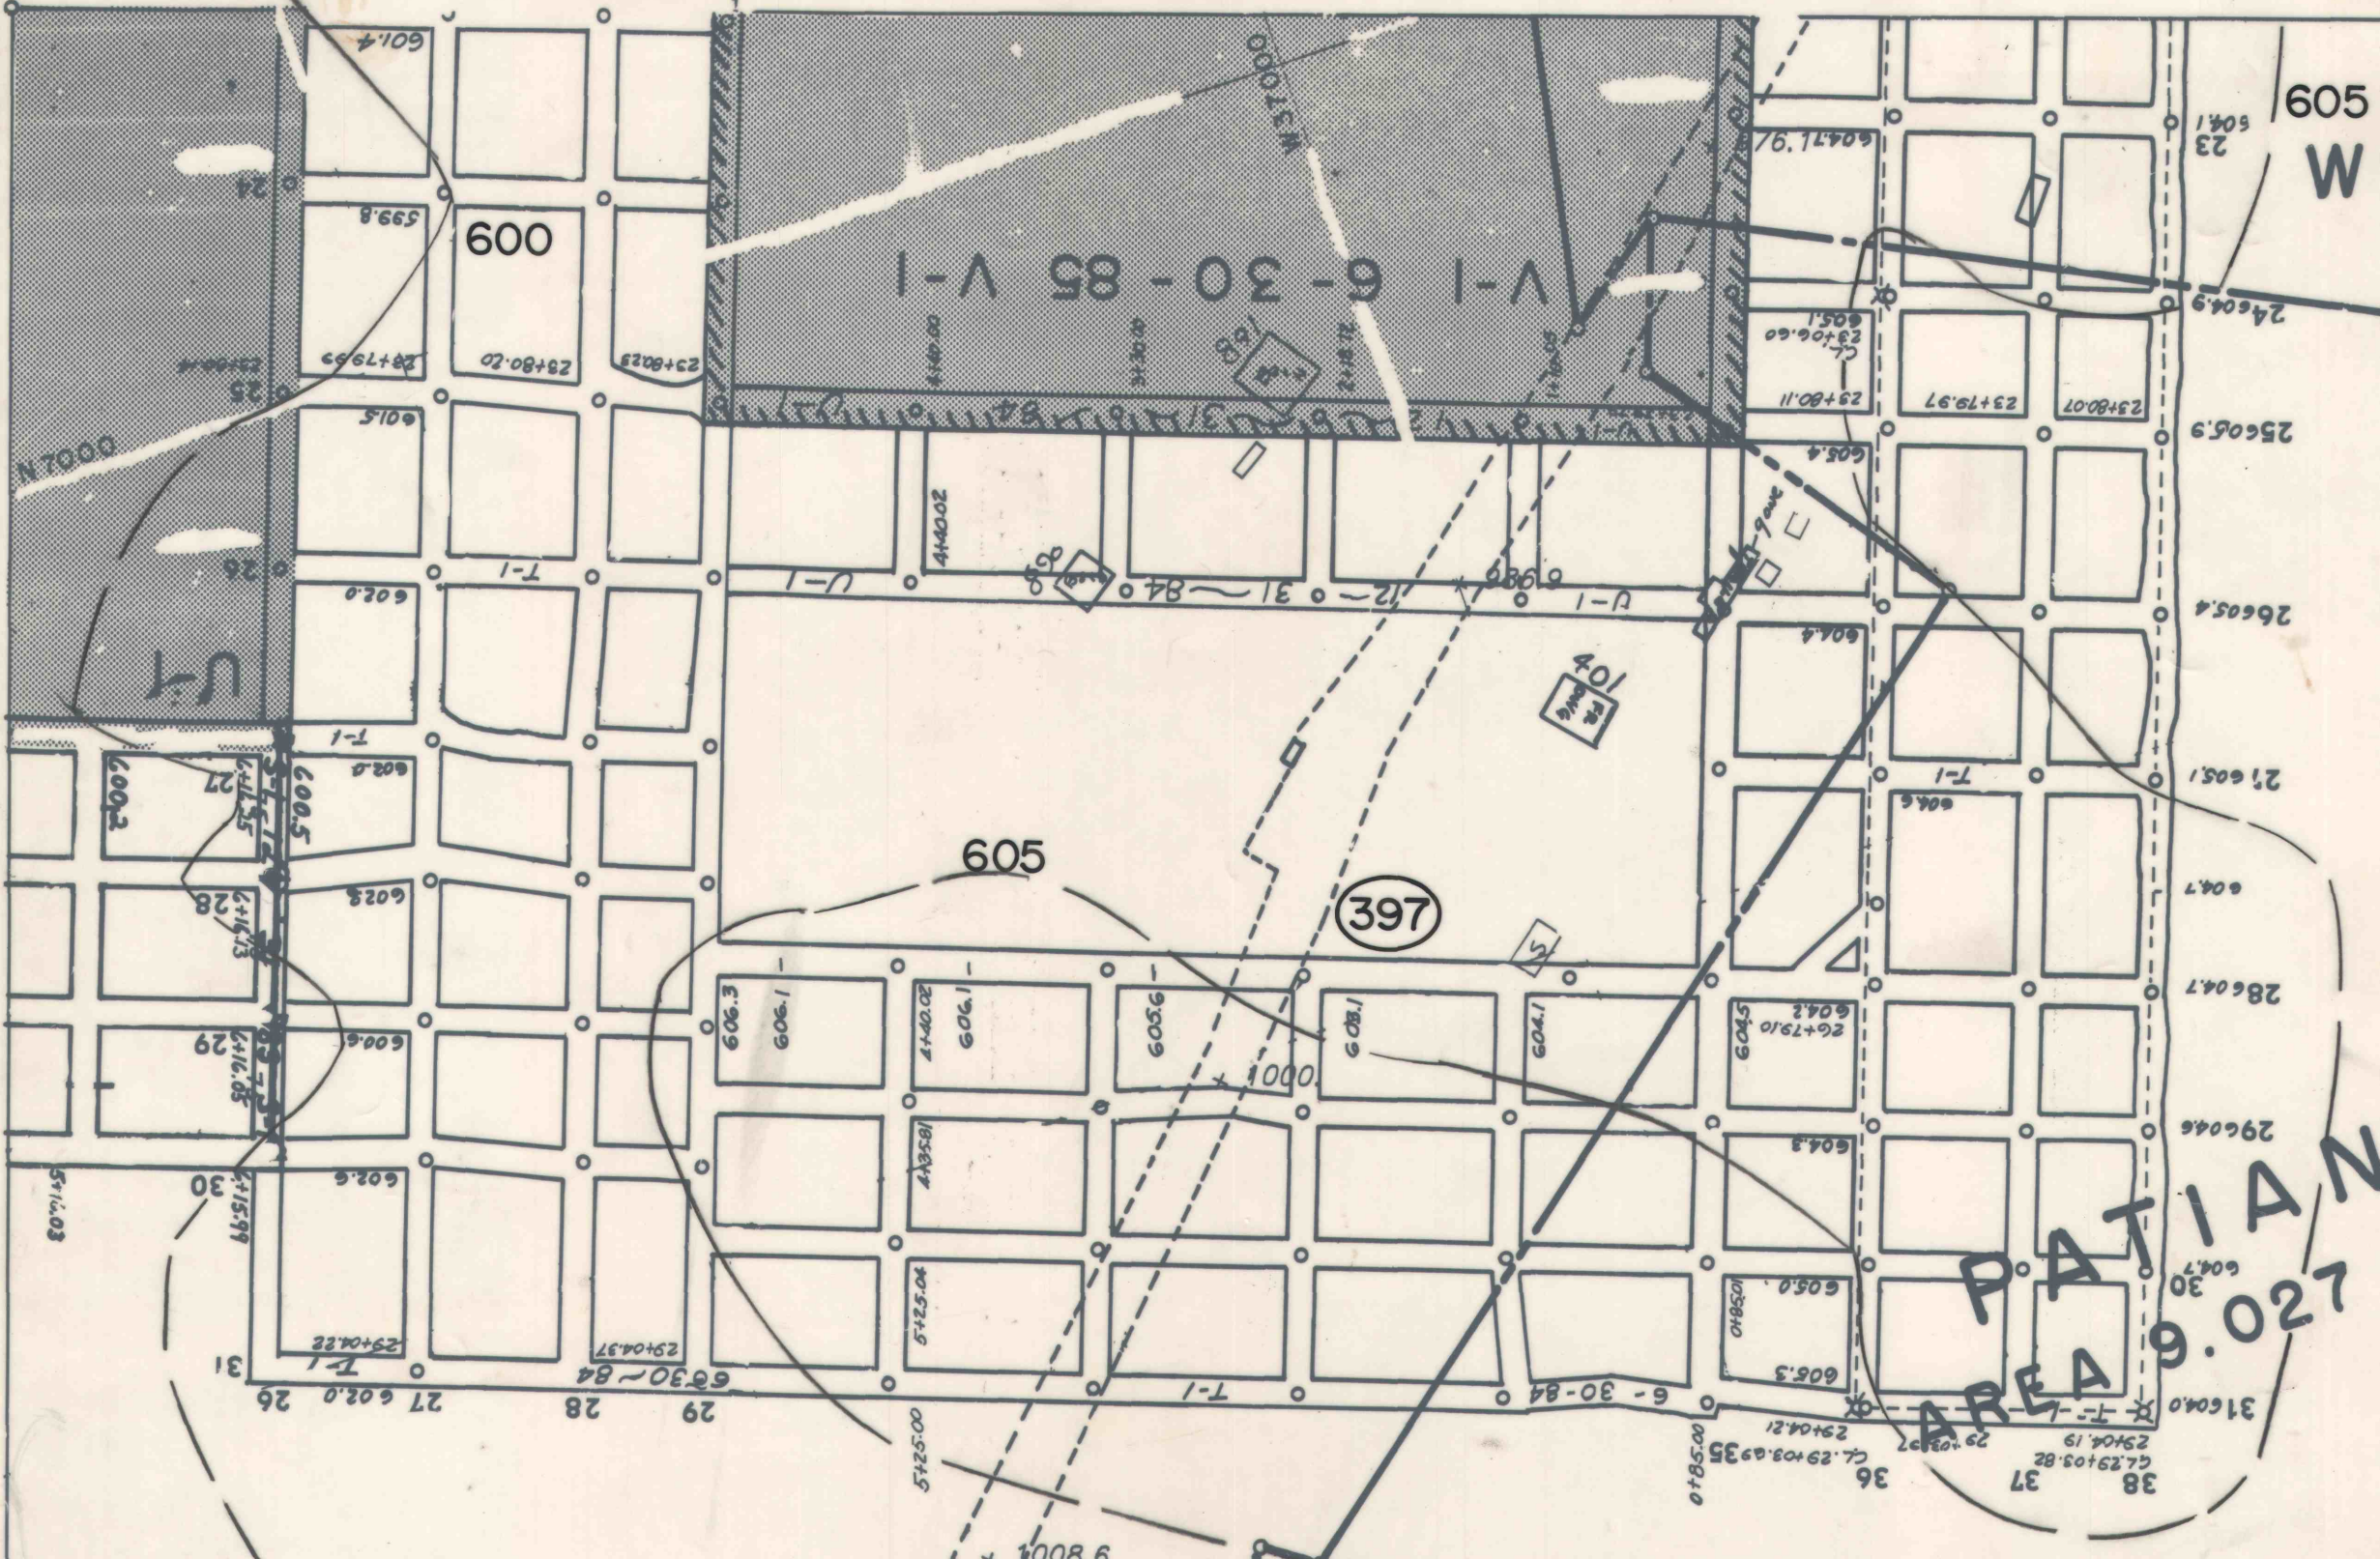

EXCHANGE LINE

SHAPE-248B

CRUCIBLE MINE
NATIONAL MINES CORP.

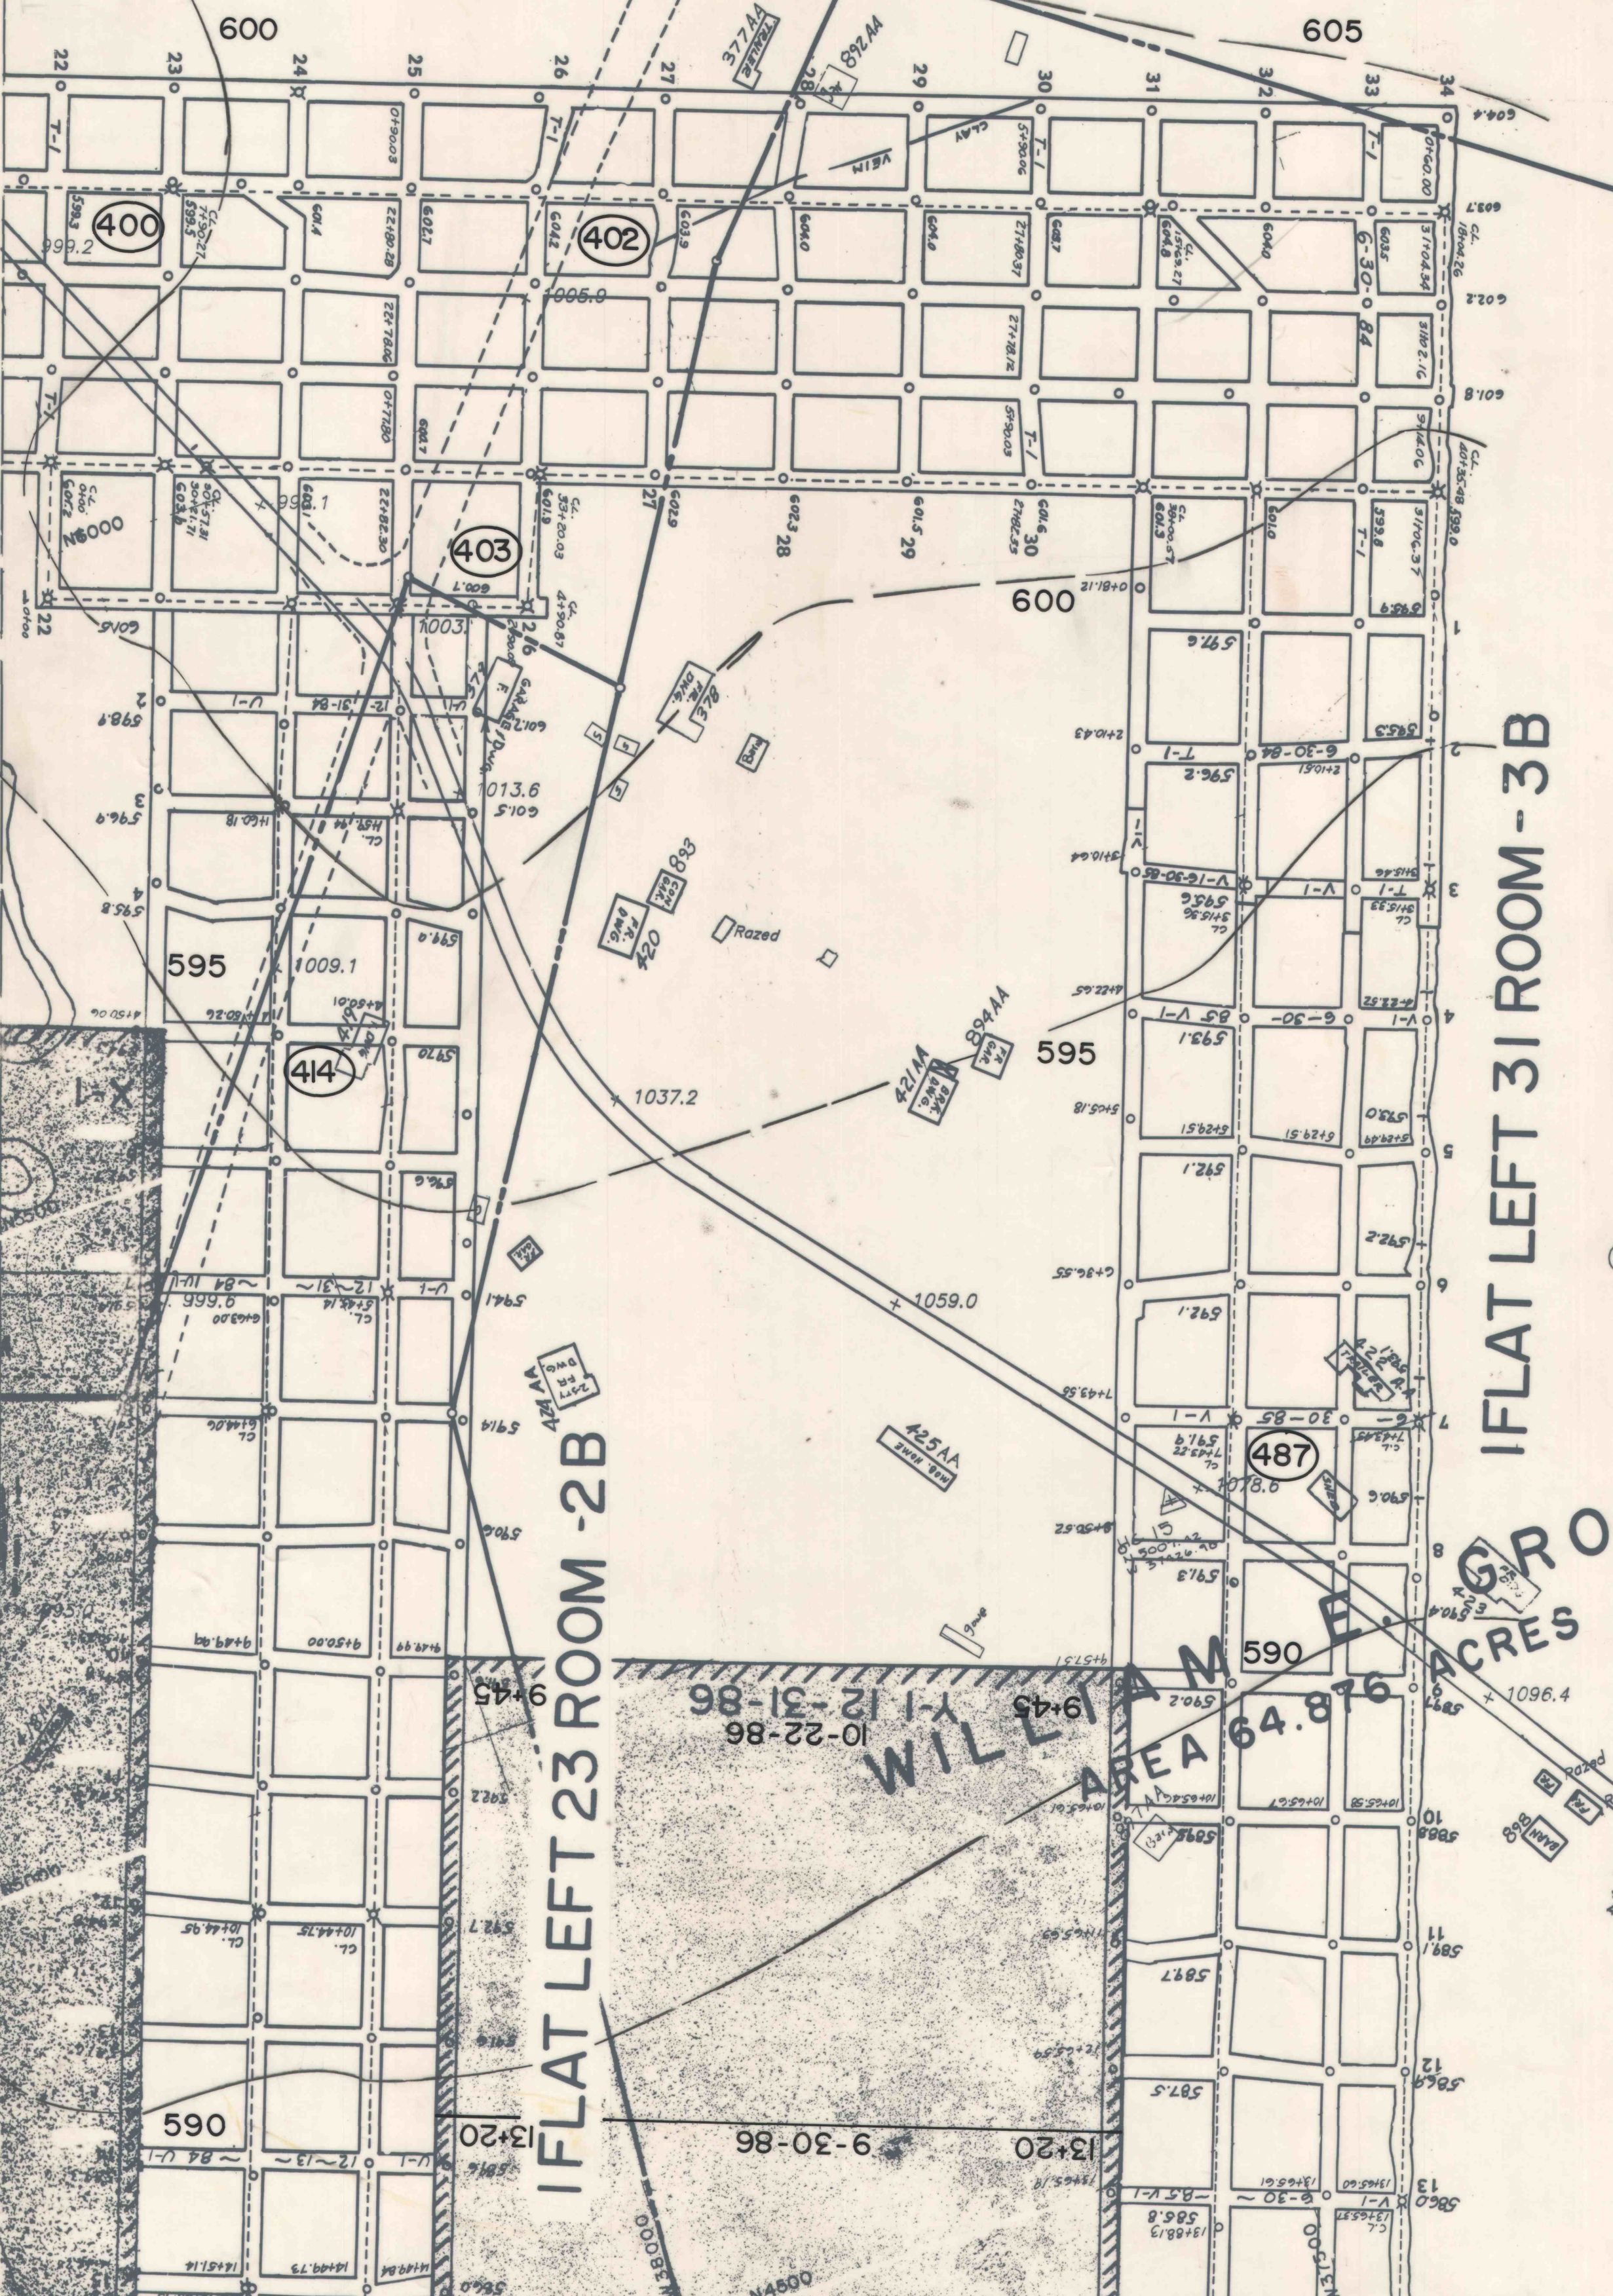

IFLAT LEFT 31 ROOM-3B

IFLAT LEFT 23 ROOM-2B

HENRY A. HUSTON-31
AREA 39.237 ACRES