
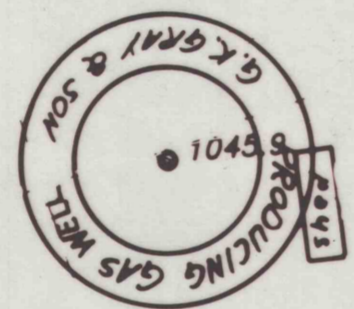


CATHARINE M. F-4
RANDOLPH
AREA 62.074 ACS

ISAAC RANDOLPH-1
AREA 74.955 ACRES

MARY E. WILLS-2
AREA 2.814 ACS.

POND
W.E.1084.4

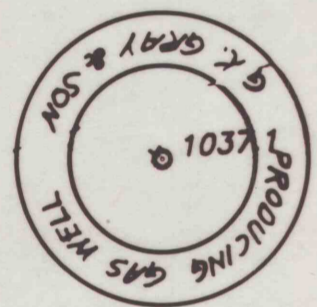

883
BARN

884
BARN

886
BARN

888AA
BARN

439

D189-15
1023.0

D.D.H.223
1003.2