


DILWORTH 272B

FIT TO 263B

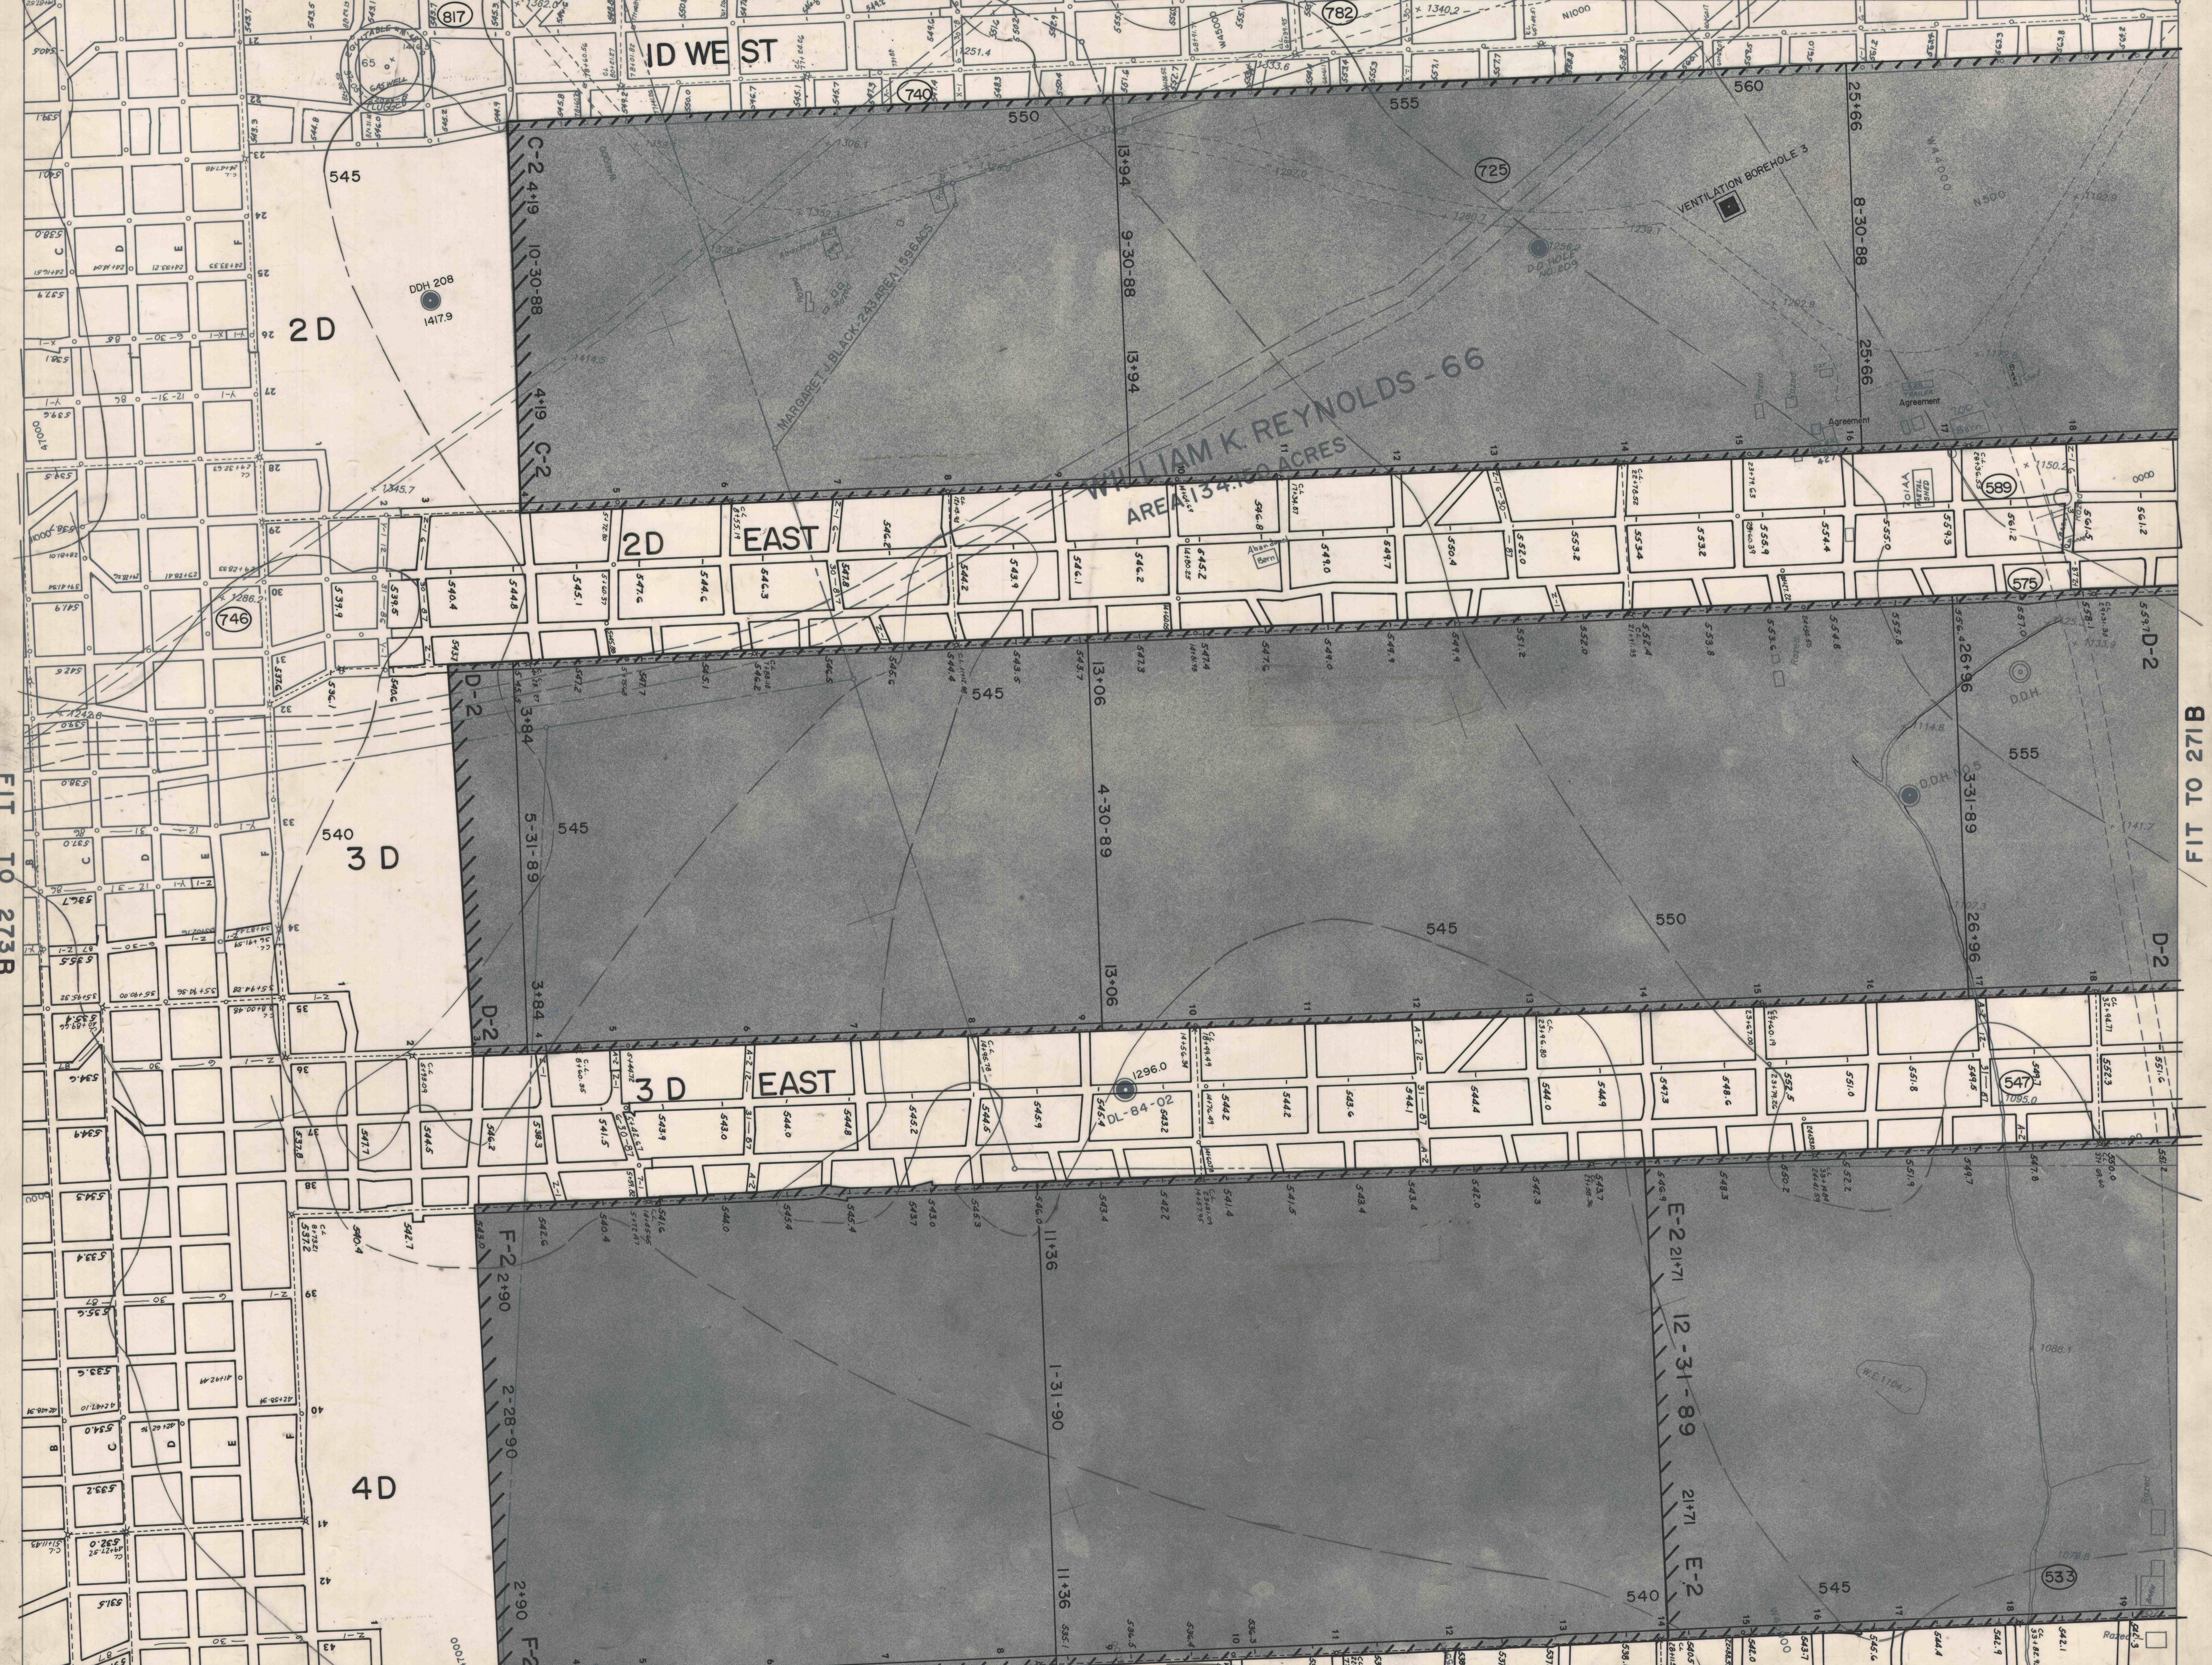

FIT TO 273B

FIT TO 281B

DILWORTH 272B

B122 01 L11