

ALLISON CREEF  
AREA 88.783 ACRES


JOHN C. CRAFT - 96  
AREA 34.713 ACRES

THOMAS J. PASCALE  
SURFACE AREA  
18.851 ACRES

FRANCIS INGHRAM BAILEY - 123  
AREA 161.412 ACRES

WILLIAM G. GROOMS - 99★  
AREA 20.659 ACRES

E.F. PENNINGTON - 21  
AREA 1.276 ACRES  
BAILEY PENNINGTON - 21  
AREA 1.999 ACRES

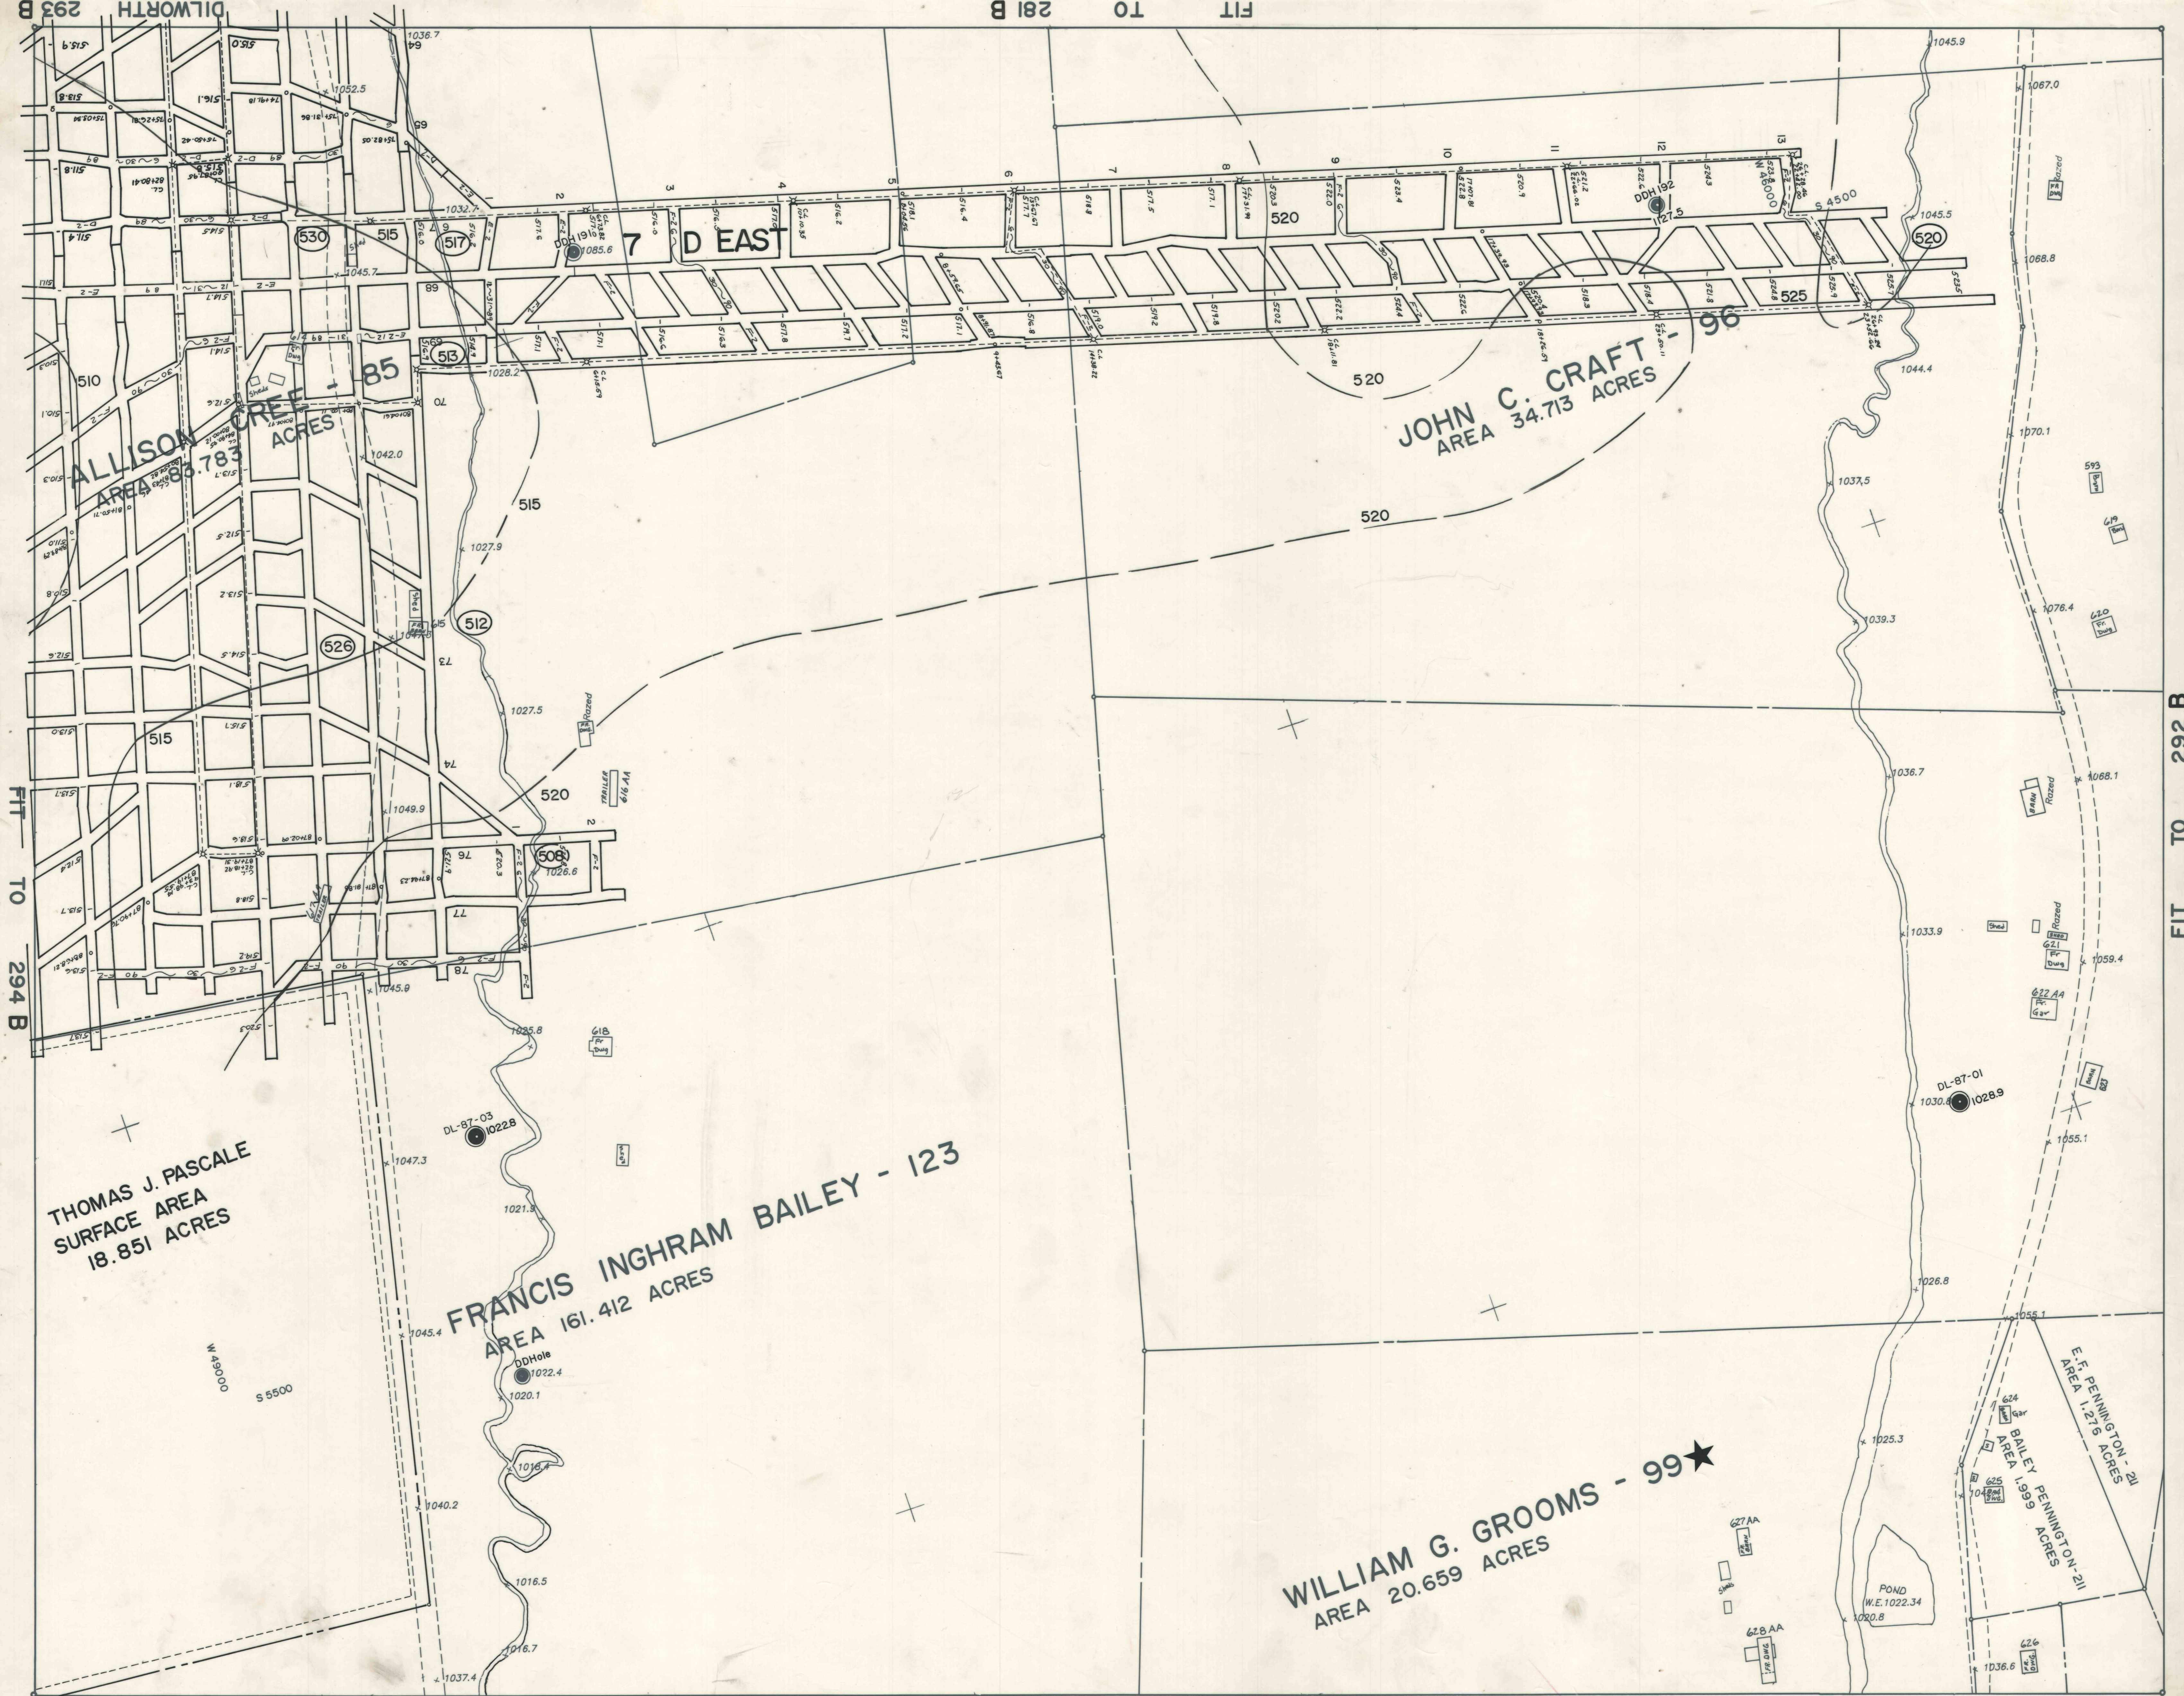

DILWORTH 293 B  
FIT TO 294 B

281 B  
FIT TO 306

292 B  
FIT TO 292 B  
DILWORTH 293 B