

Y-1 12-31-86

WATER EDGE

EXCHANGE LINE

LEWIS YOUNG 29  
AREA 66.836 ACRES

PARCEL 'A'  
4.424 ACS.


AREA 27.515 ACRES

PARCEL 'B'  
11.027 ACS

GEORGE F. LUSE-248C  
AREA 47.439 ACRES

NEW EXCHANGE LINE

Strip Conveyed To Crucible  
Fuel Co. By Deed Dated Dec  
22, 1942. Eng. File 7935

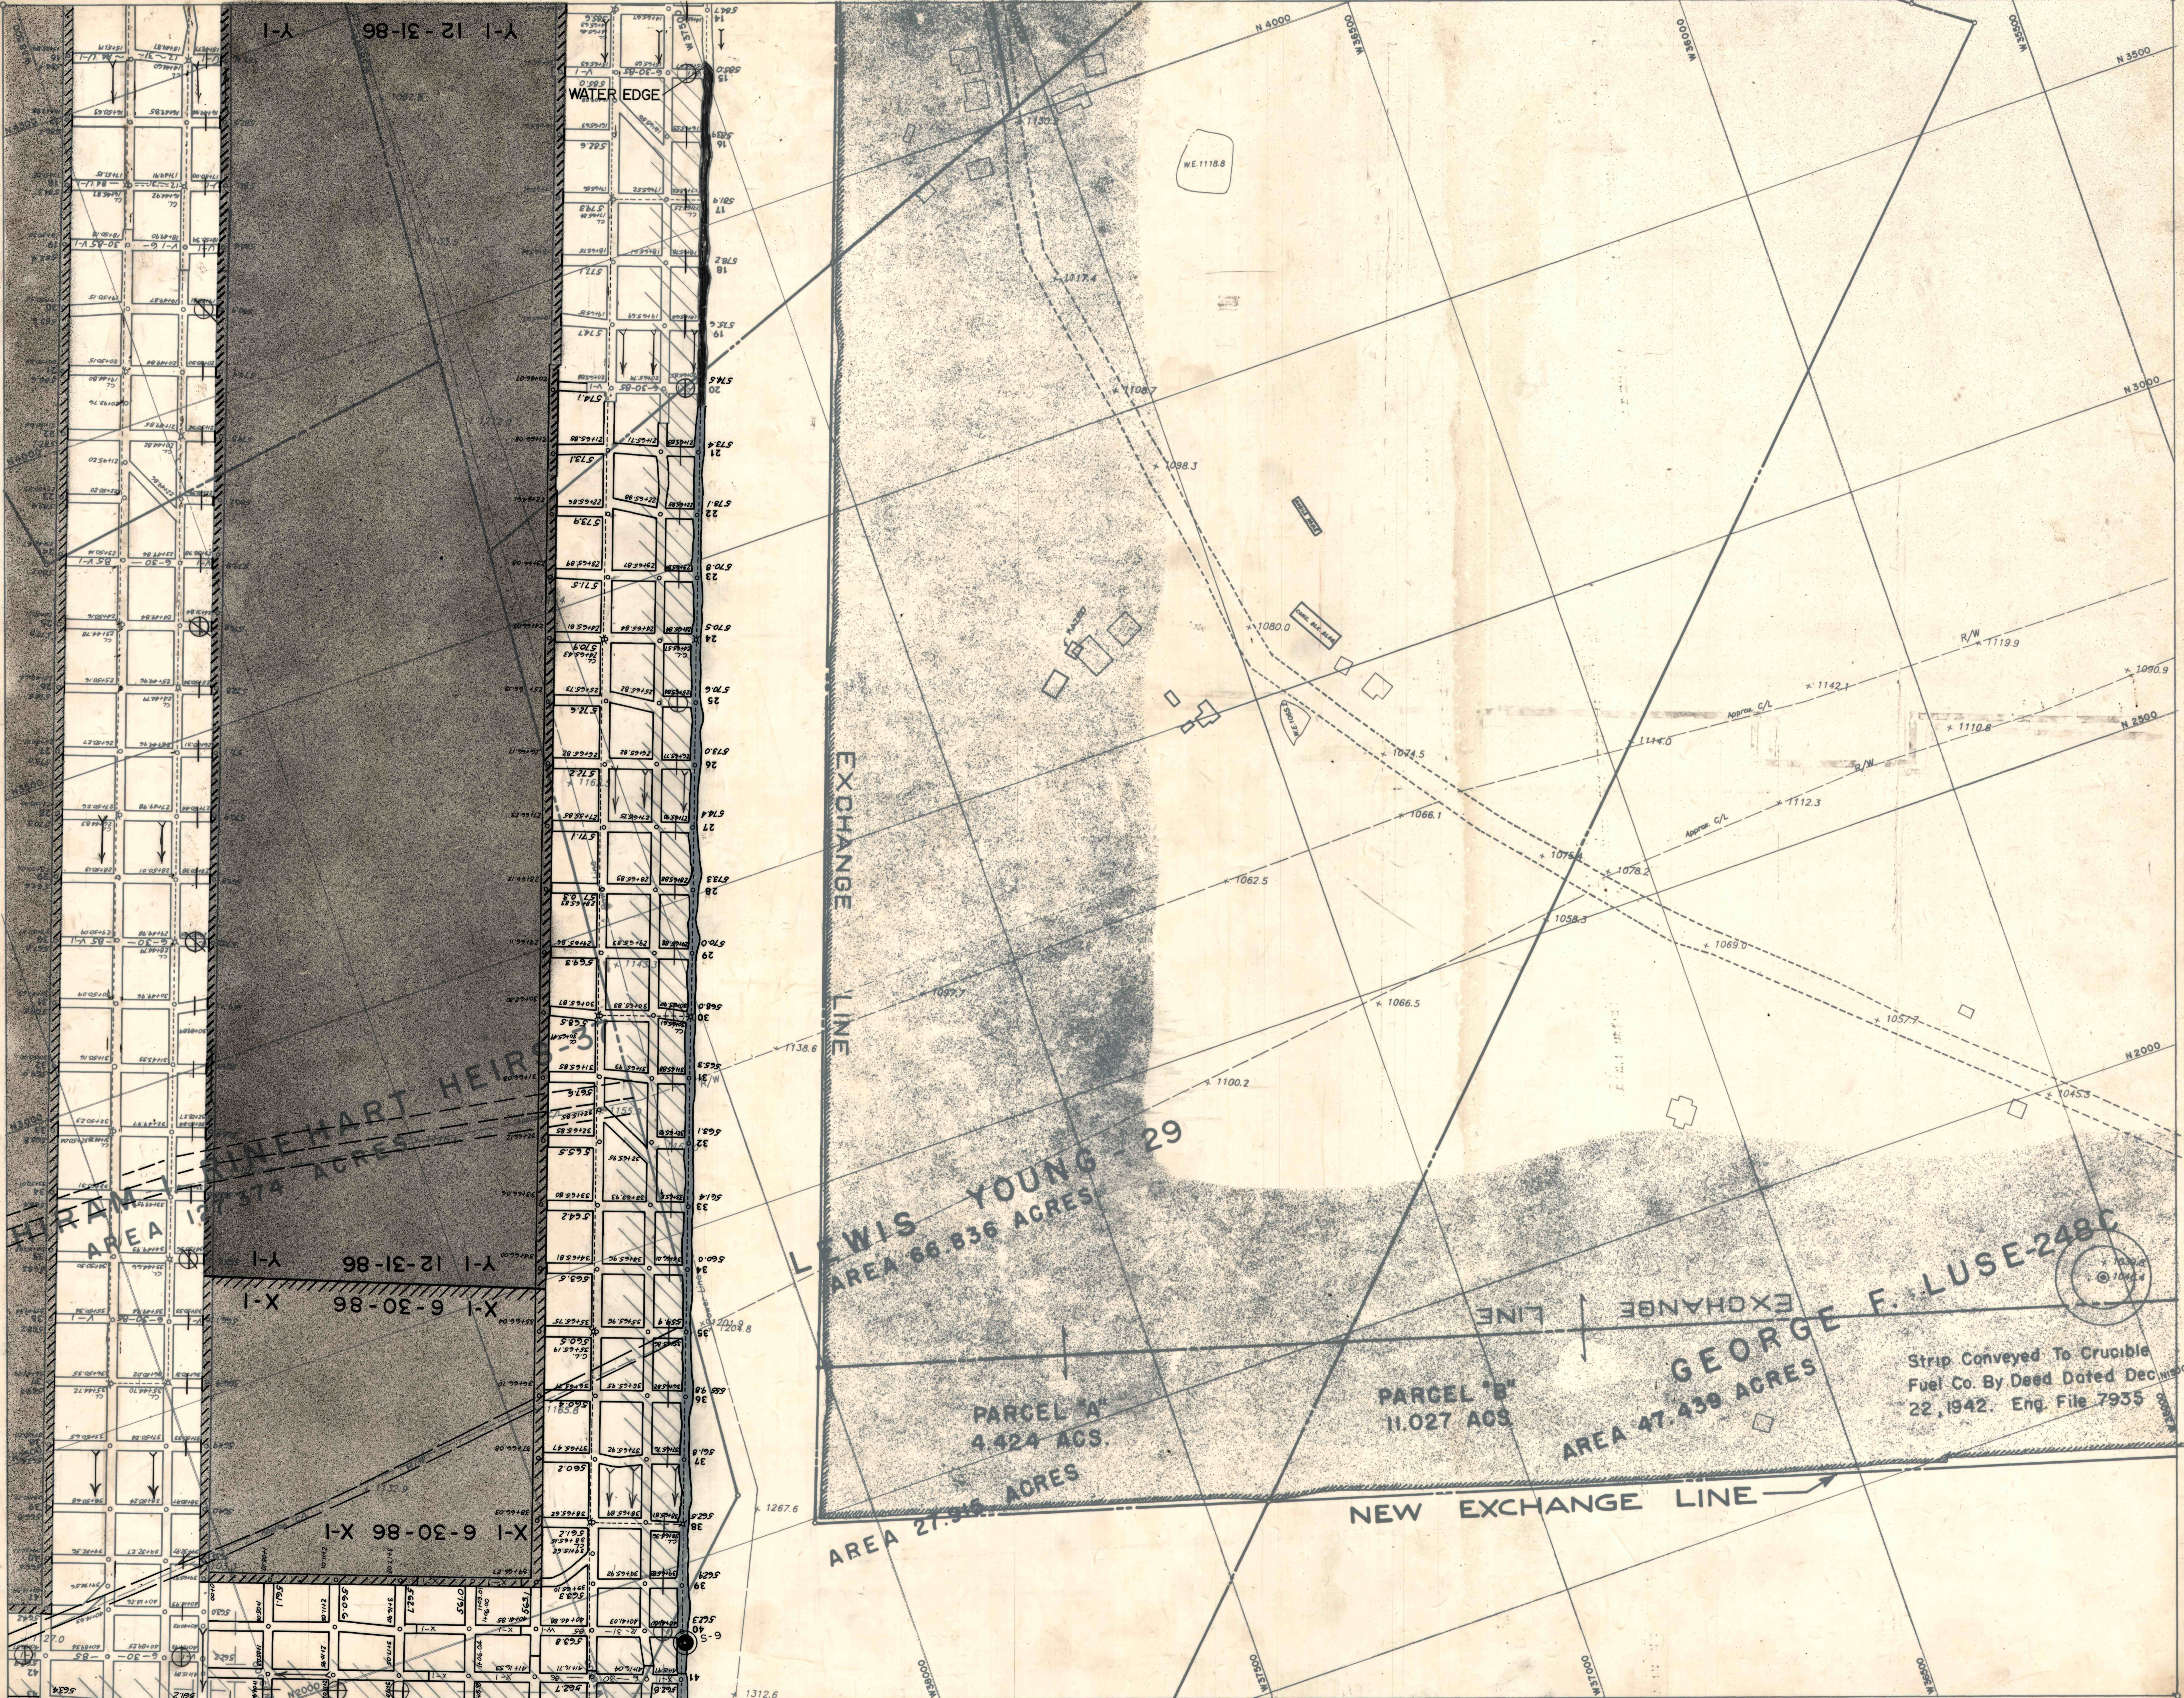


Y-1 12-31-86

X-1 6-30-86

X-1 6-30-86

X-1 6-30-86