


D.D. HOLE NO. 241

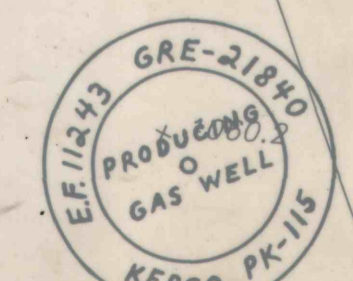

JAMES BELL HEIRS - 931  
AREA 66.013 ACRES

AMANDA J. K ERR - 143  
AREA 67.499 ACRES