

**AIR SHAFT No. 11 FANS**

**DIESEL-STANDBY**

SIZE: - 72"  
 TYPE: - CENTRIFUGAL  
 MODEL: - 8075 AFS 749  
 MANUFACTURER: - ALPHA AIR  
 OPERATING WG: - 665  
 HP: - 889  
 R.P.M.: - 889

**ELECTRIC-OPERATING**

SIZE: - 72"  
 TYPE: - CENTRIFUGAL  
 MODEL: - 8075 AFS 749  
 MANUFACTURER: - ALPHA AIR  
 R.P.M.: - 889  
 EXHAUSTING: - 221.465 CFM  
 CH: - 0.4%  
 FAN: - 90% OPEN

**TOP OF COPING ELEVATION: - 1139.0'**  
**BOTTOM OF COAL ELEVATION: - 542.7'**  
**CIRCULAR SHAPE: 6.0' I.D.**

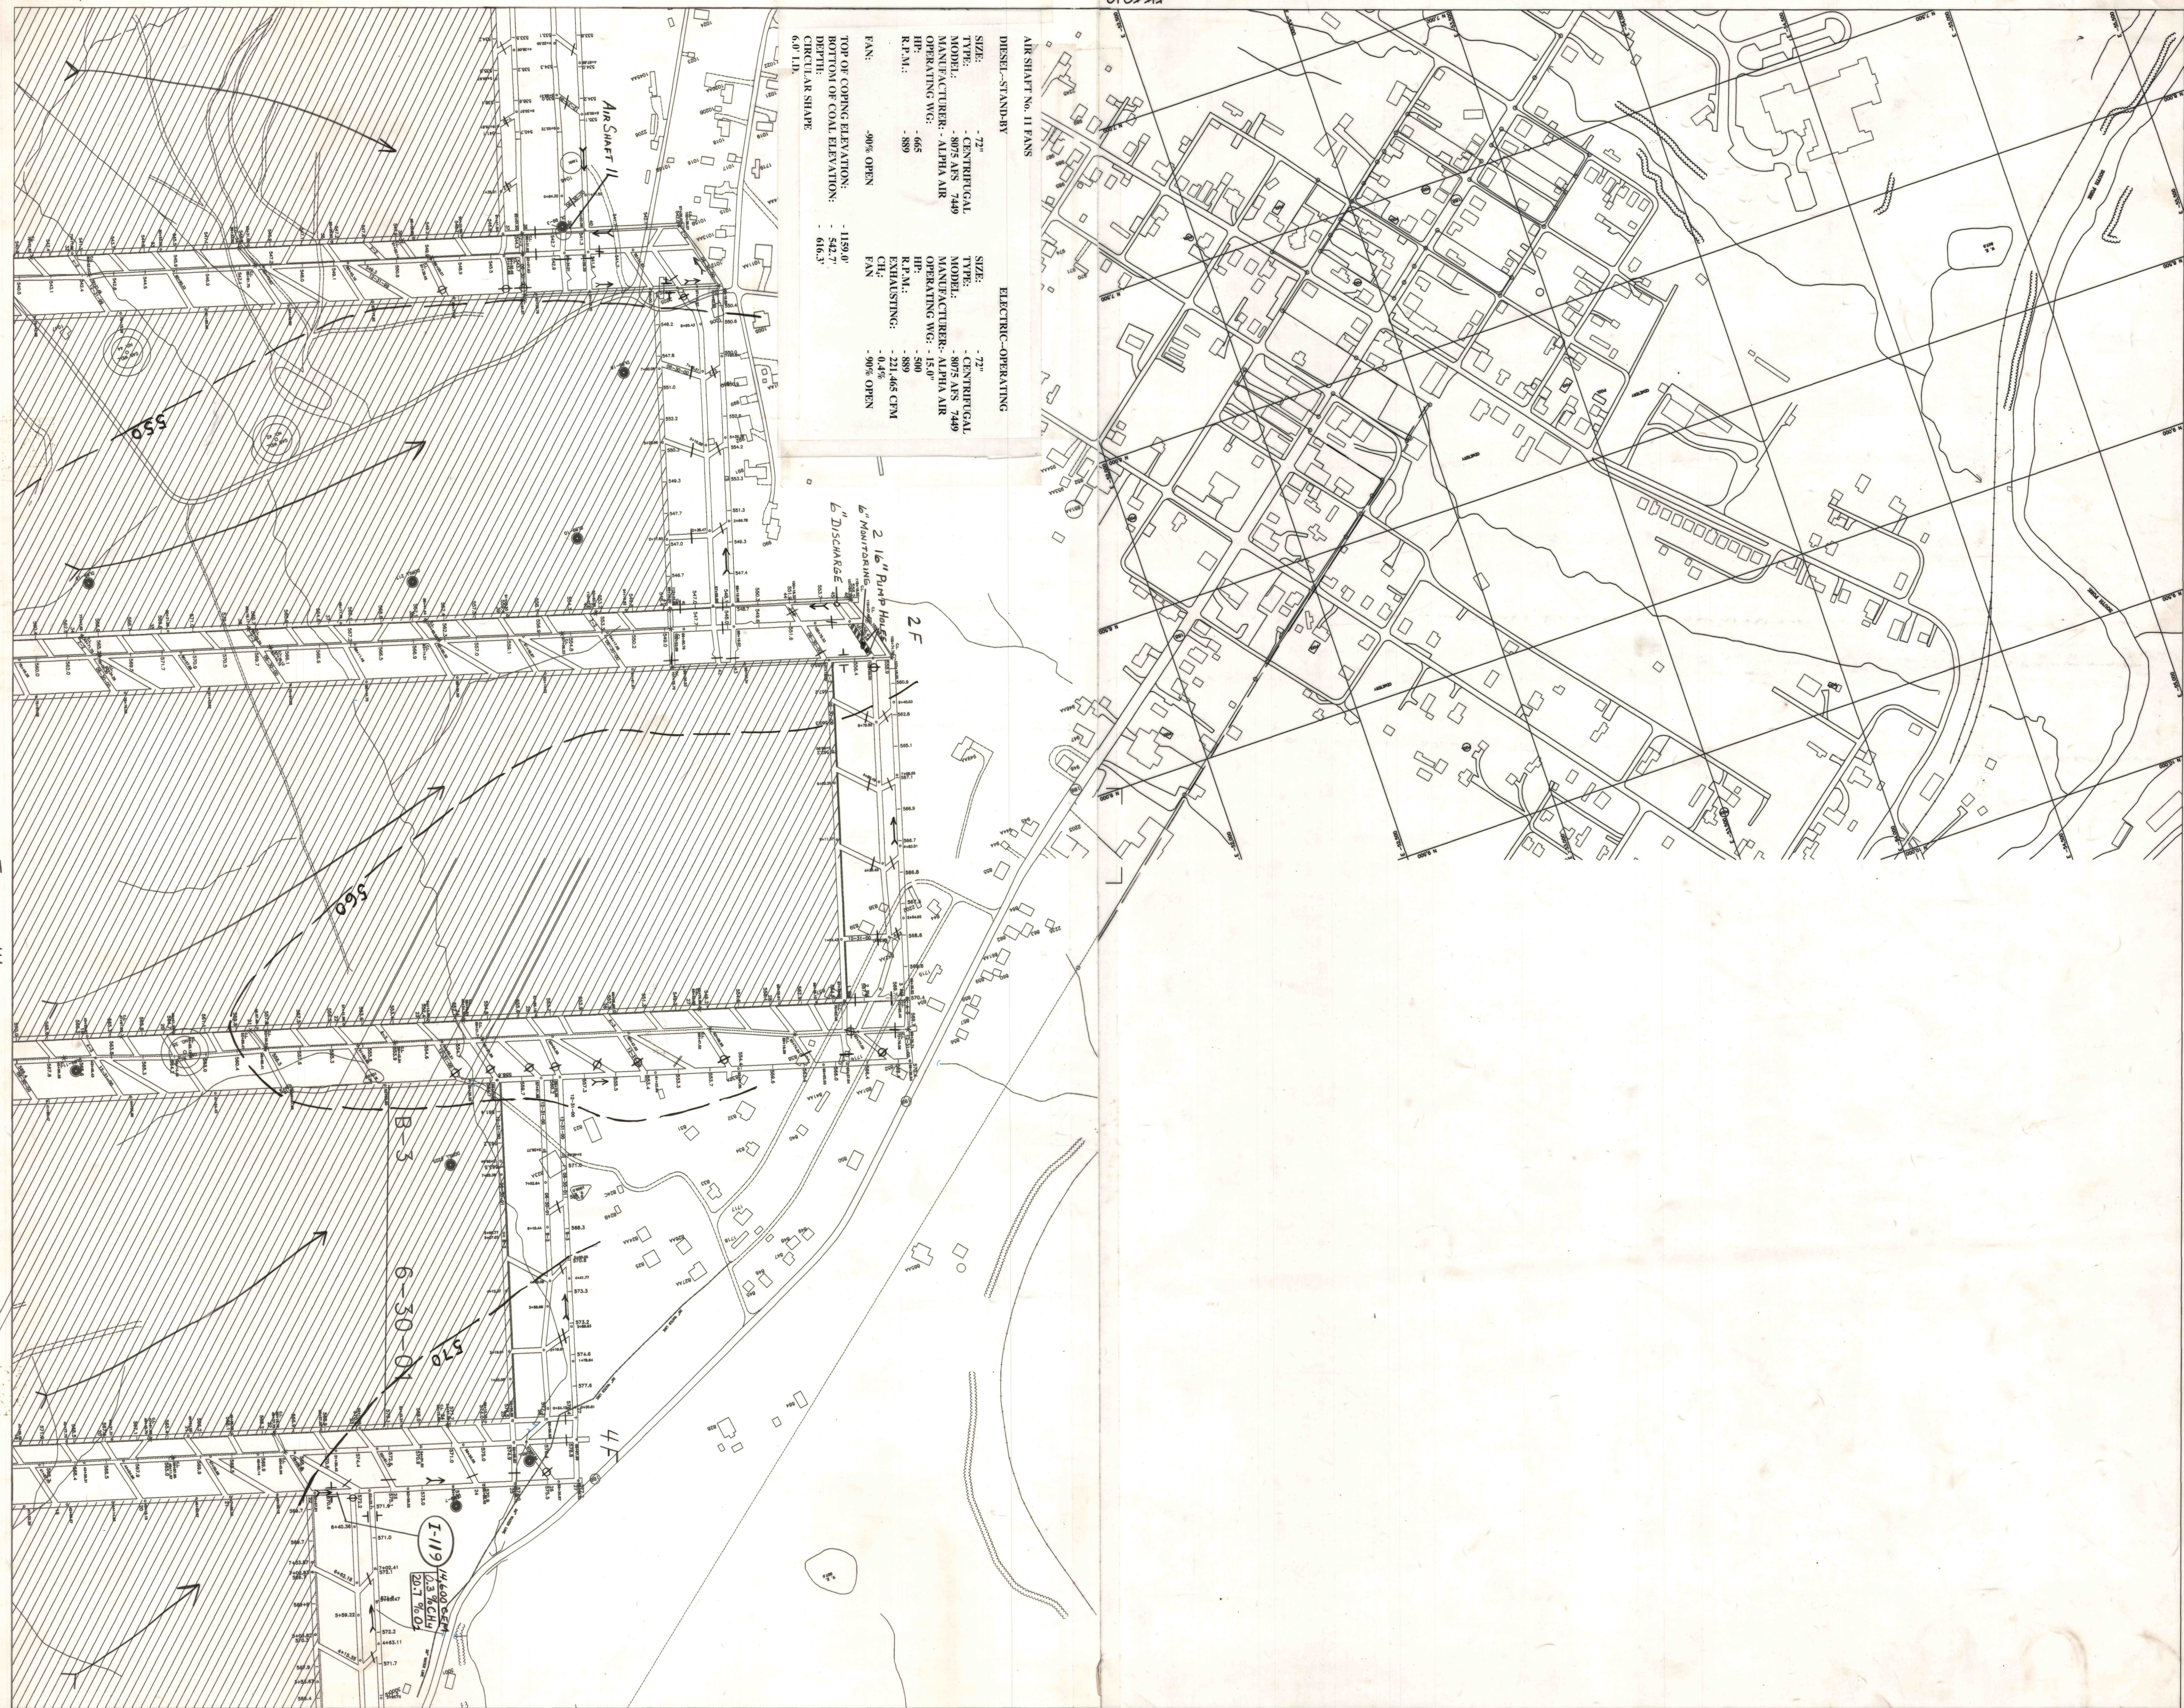


FIG TO 14