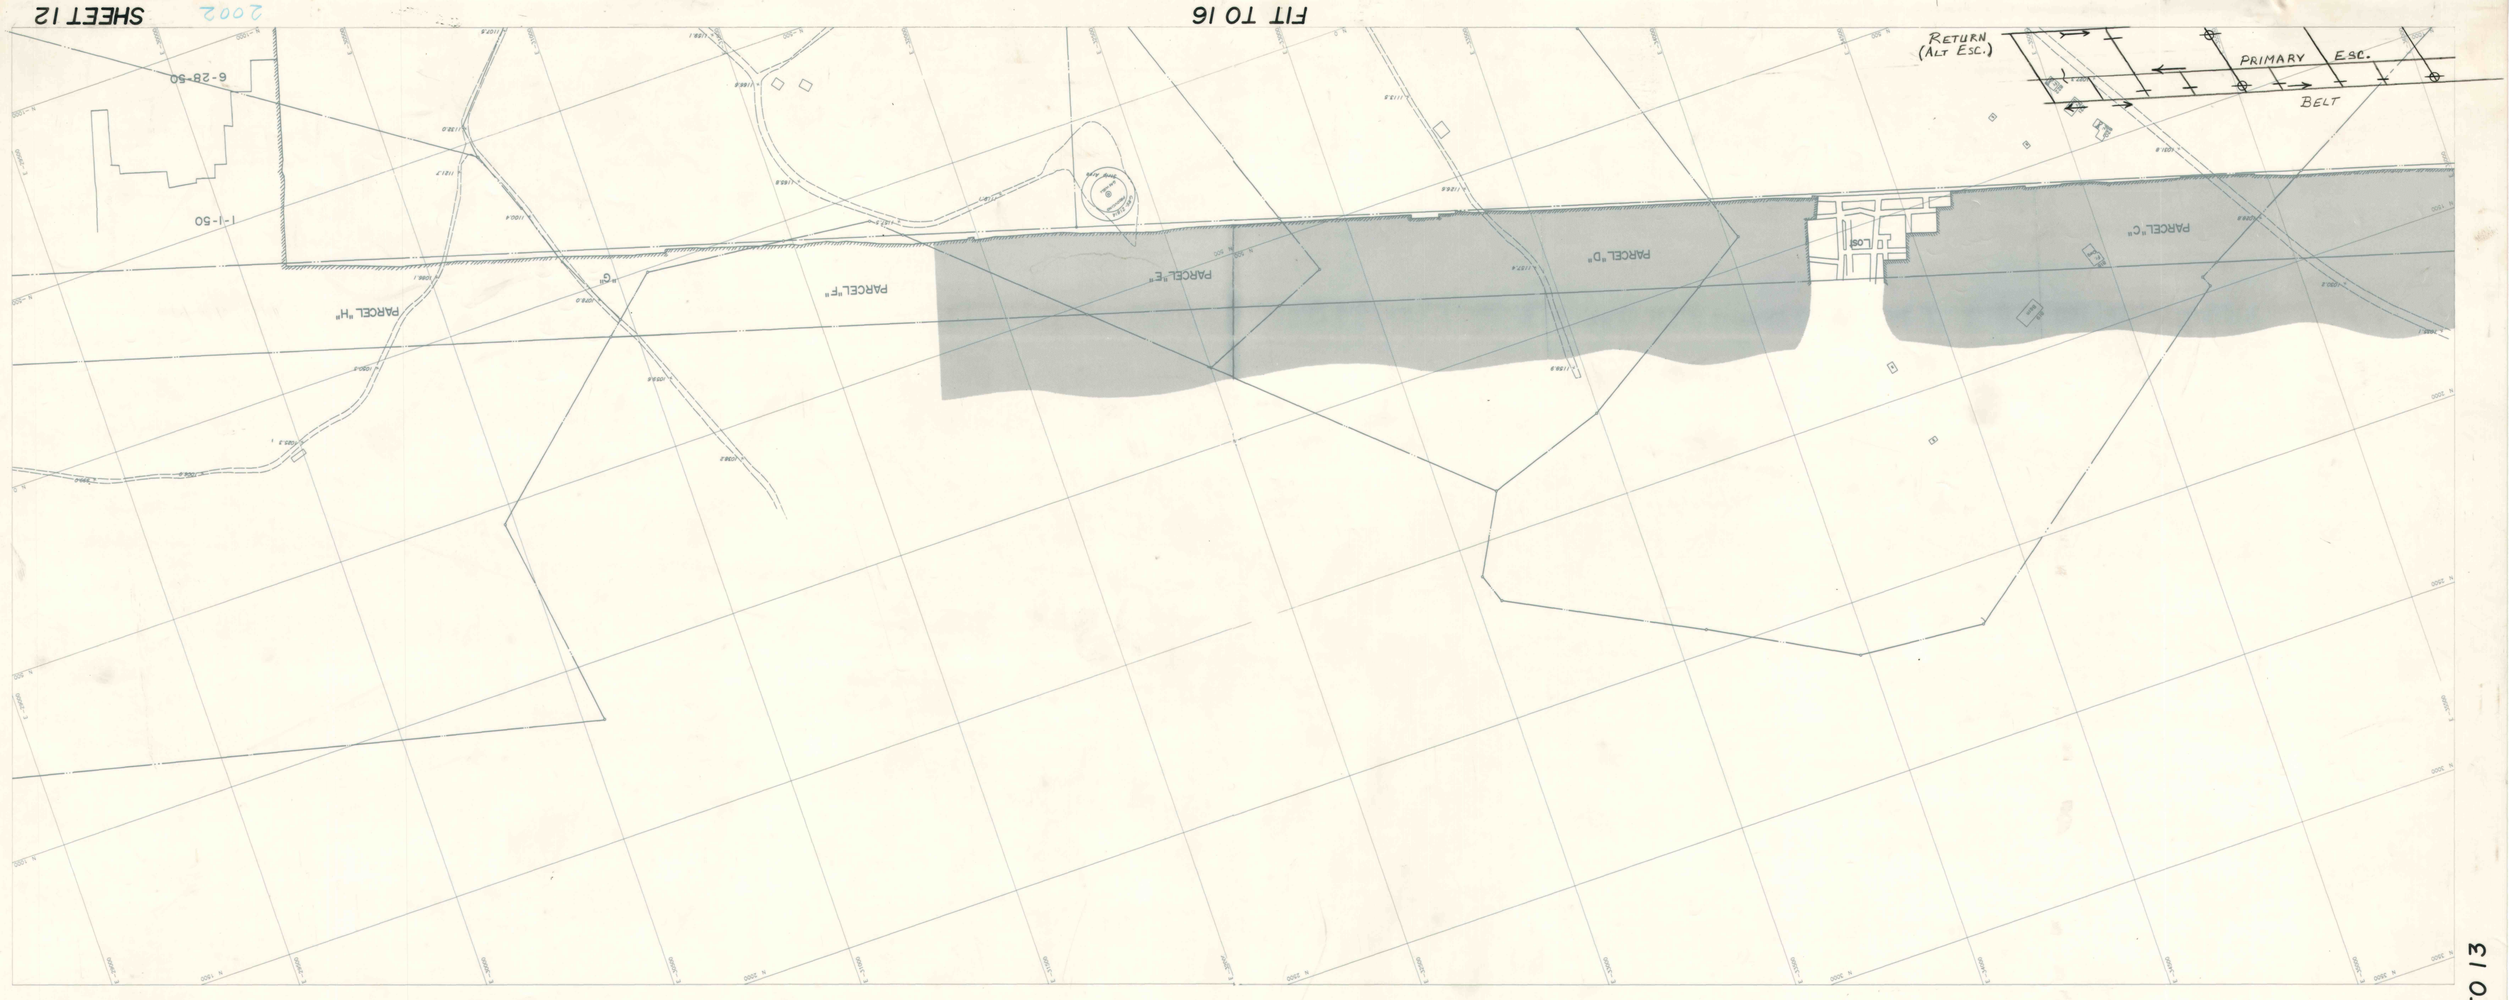

FIT TO 16

SHEET 12

2002

FIT TO 16

2002 SHEET 12