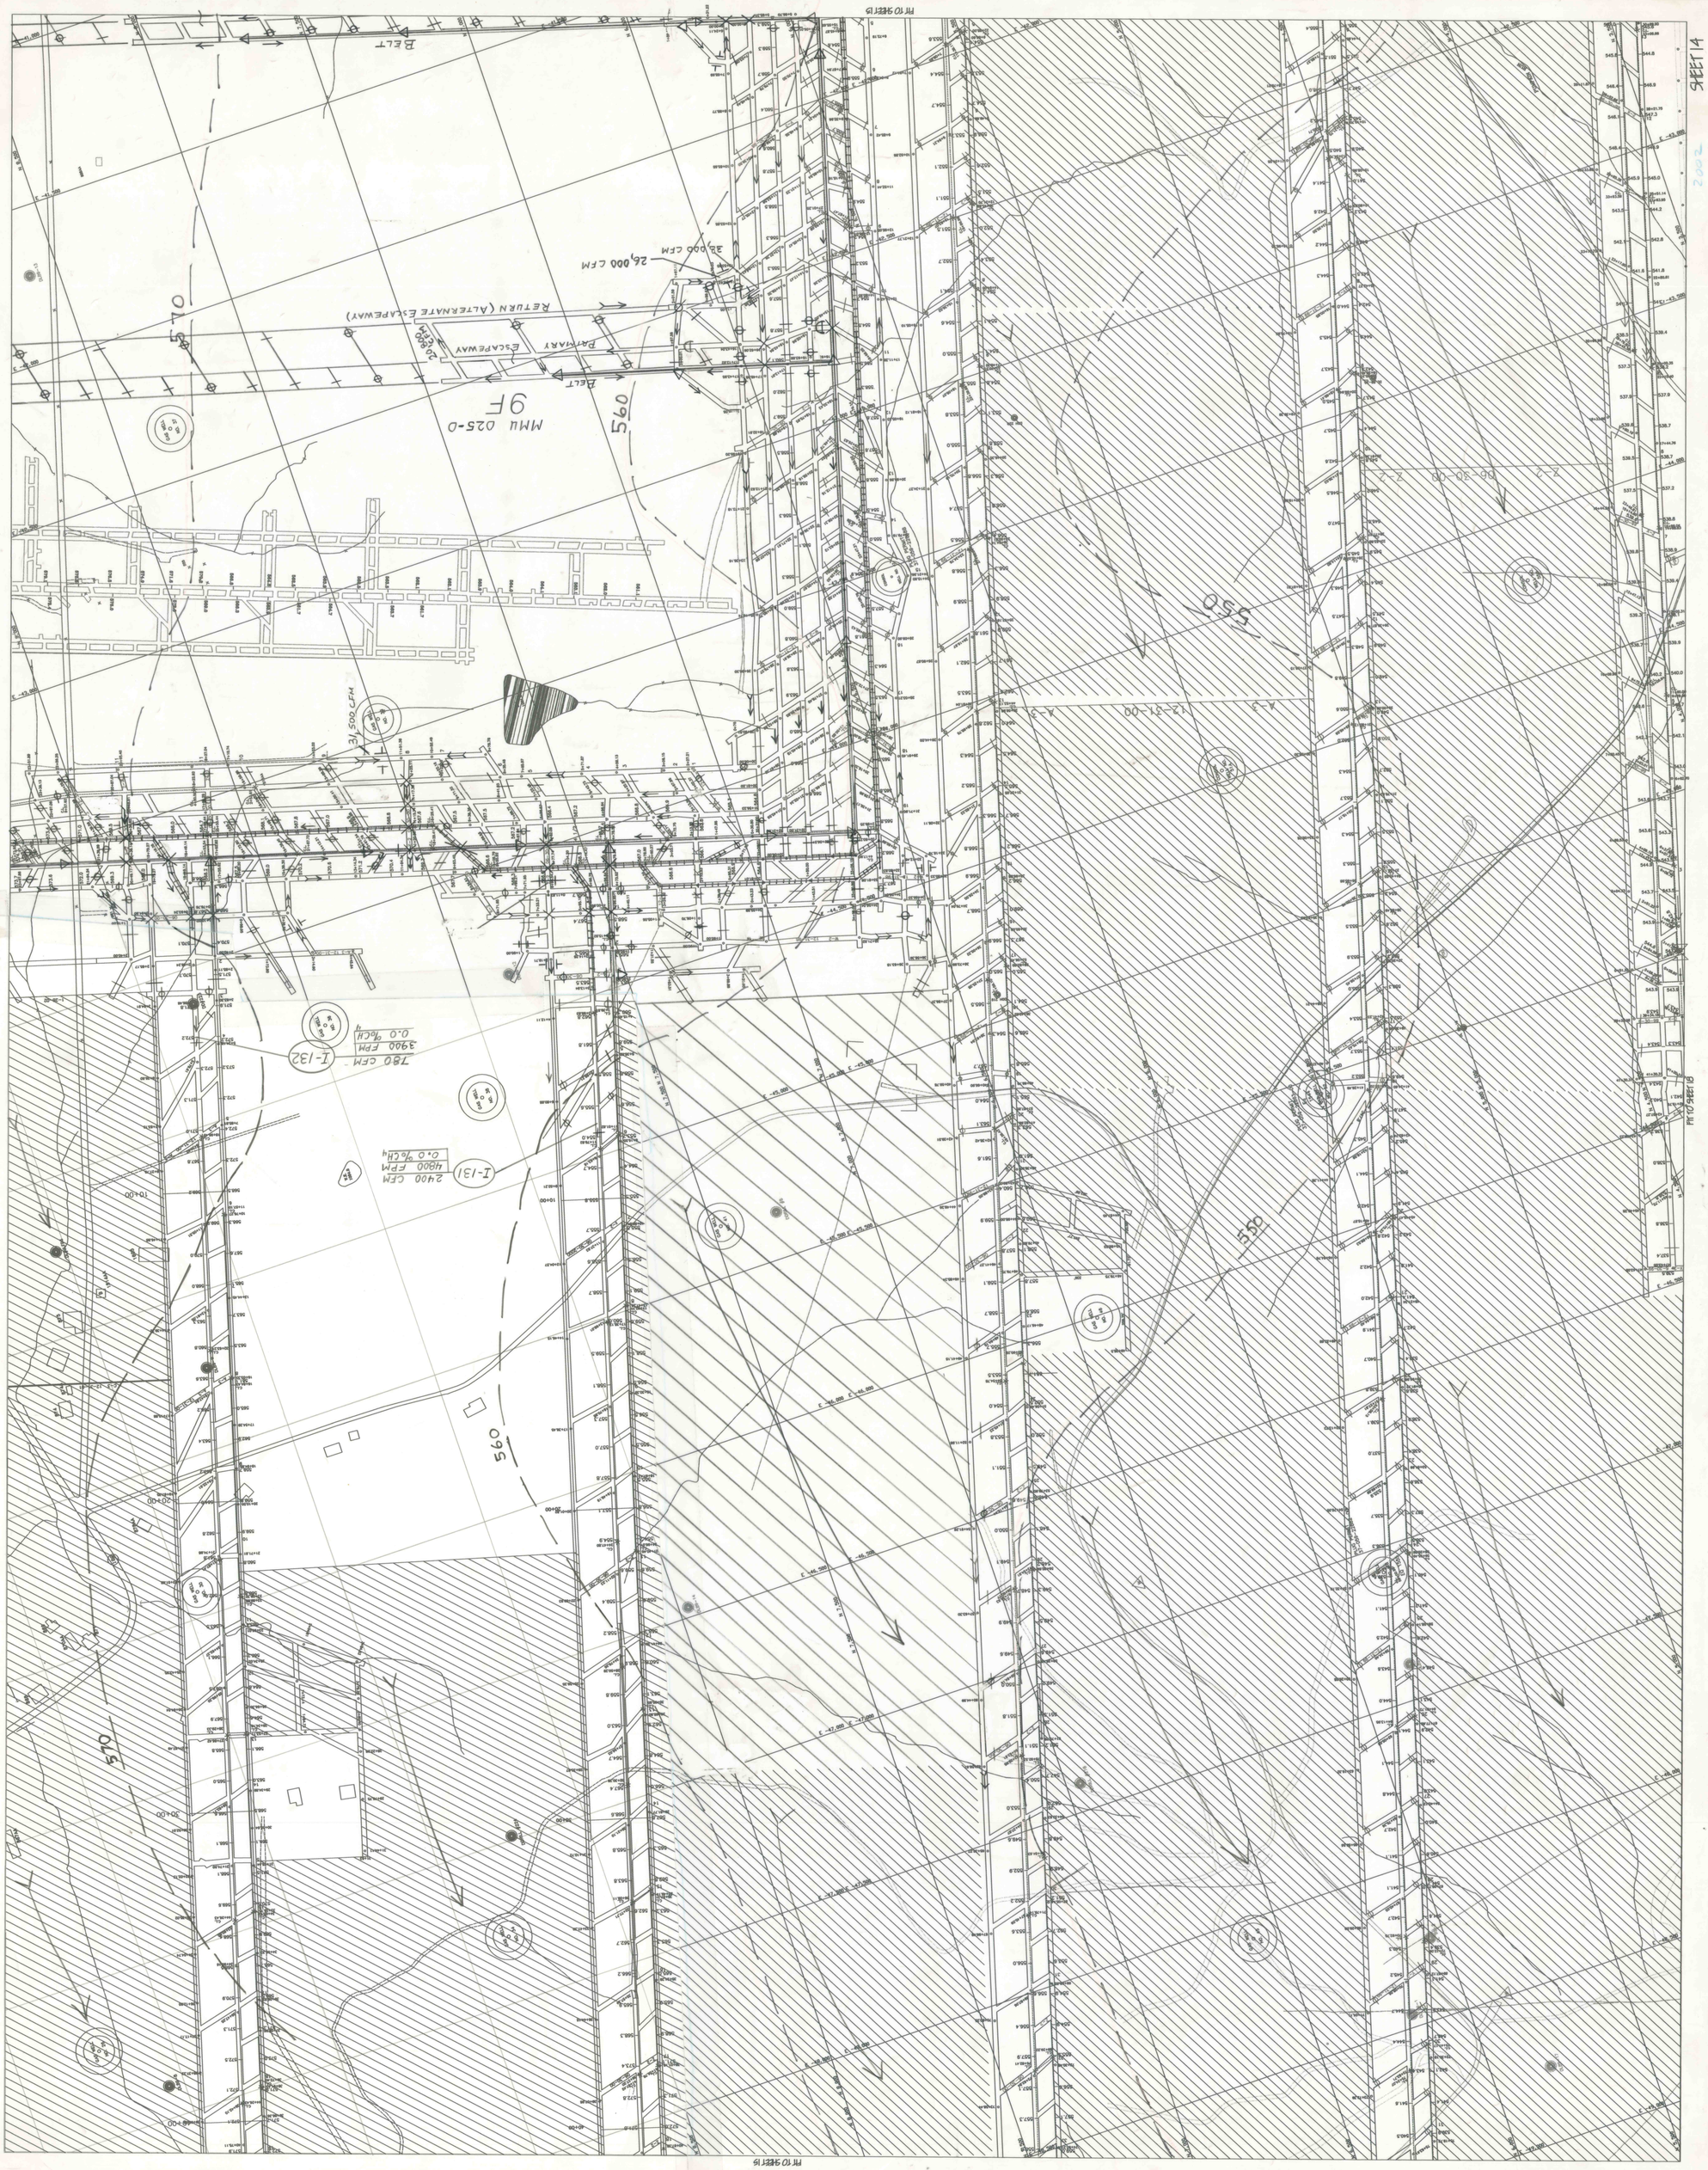
SHEET 14
2002
PLANS/DWG
PR10 SHEET 15
BELT
RETURN (ALTERNATE ESCAPEWAY)
26,000 CFM
32,000 CFM
PRIMARY ESCAPEWAY
BELT
MMU 025-D
9F
560
570
31,500 CFM
12-31-00
A-3
550
I-132
780 CFM
3900 FPM
0.0 %CH4
I-131
2400 CFM
4900 FPM
0.0 %CH4
560
570
550
10+00
20+00
30+00
40+00
FIT TO 10
2002
SHEET 14
PR10 SHEET 15