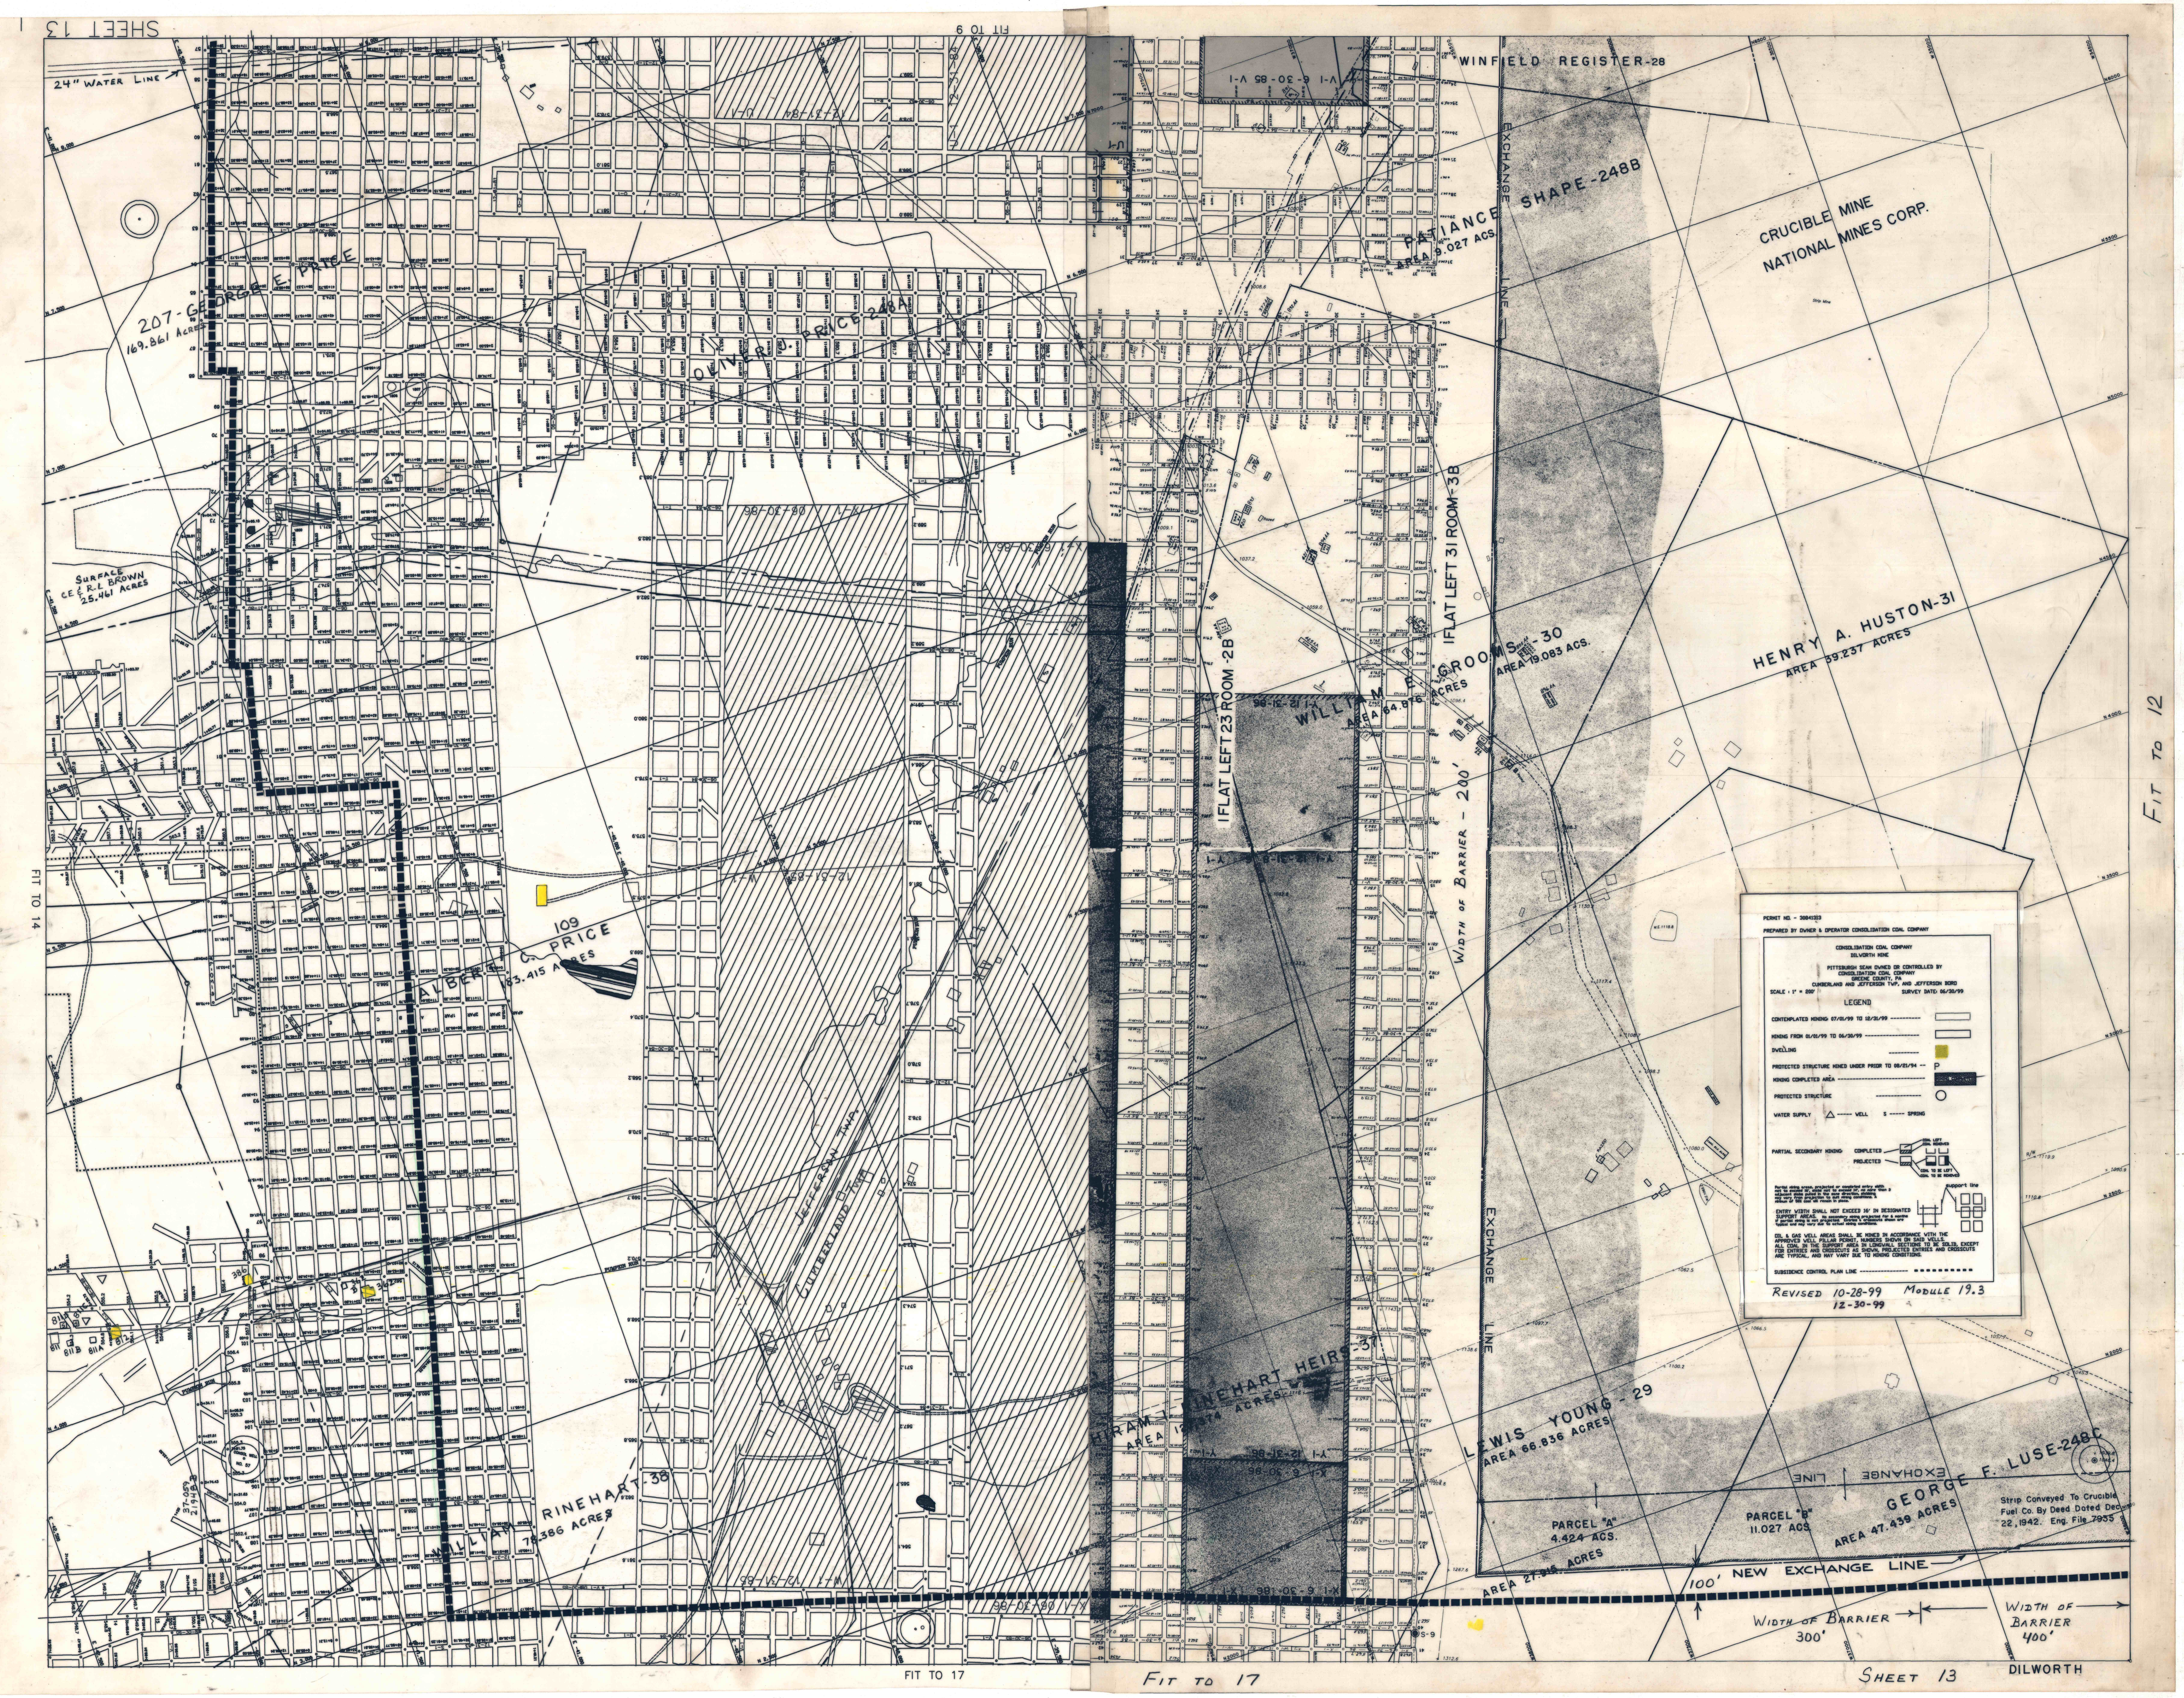
SHEET 13
FIT TO 9
24" WATER LINE
207-GEORGE E. PRICE
169.861 ACRES
OLIVER J. PRICE-248A
SURFACE
C.E. & R.L. BROWN
25.461 ACRES
109
ALBERT C. PRICE
183.415 ACRES
WILLIAM RINEHART-38
78.386 ACRES
JEFFERSON TWP.
CUMBERLAND TWP.
PUMPKIN RUN
CONSOL WELL NO. 57
WINFIELD REGISTER-28
PATIANCE SHAPE-248B
AREA 9.027 ACS.
CRUCIBLE MINE
NATIONAL MINES CORP.
Strip Mine
EXCHANGE LINE
IFLAT LEFT 23 ROOM-2B
IFLAT LEFT 31 ROOM-3B
WILLIAM E. GROOMS-30
AREA 64.876 ACRES
AREA 19.083 ACS.
HENRY A. HUSTON-31
AREA 39.237 ACRES
WIDTH OF BARRIER - 200'
HIRAM T. RINEHART HEIRS-37
LEWIS YOUNG - 29
AREA 66.836 ACRES
GEORGE F. LUSE-248C
AREA 47.439 ACRES
PARCEL "A"
4.424 ACS.
PARCEL "B"
11.027 ACS.
AREA 27.315 ACRES
Strip Conveyed To Crucible Fuel Co. By Deed Dated Dec 22, 1942. Eng. File 7935
100' NEW EXCHANGE LINE
WIDTH OF BARRIER 300'
WIDTH OF BARRIER 400'
FIT TO 12
FIT TO 14
FIT TO 17
FIT TO 17
SHEET 13
DILWORTH
PERMIT NO. - 30841313
PREPARED BY OWNER & OPERATOR CONSOLIDATION COAL COMPANY
CONSOLIDATION COAL COMPANY
DILWORTH MINE
PITTSBURGH SEAM OWNED OR CONTROLLED BY
CONSOLIDATION COAL COMPANY
GREENE COUNTY, PA
CUMBERLAND AND JEFFERSON TWP, AND JEFFERSON BORO
SCALE : 1" = 200'
SURVEY DATE: 06/30/99
LEGEND
CONTEMPLATED MINING: 07/01/99 TO 12/31/99
MINING FROM 01/01/99 TO 06/30/99
DWELLING
PROTECTED STRUCTURE MINED UNDER PRIOR TO 08/21/94 -- P
MINING COMPLETED AREA
PROTECTED STRUCTURE
WATER SUPPLY - WELL S - SPRING
PARTIAL SECONDARY MINING: COMPLETED
PROJECTED
COAL LEFT
COAL REMOVED
COAL TO BE LEFT
COAL TO BE REMOVED
support line
ENTRY WIDTH SHALL NOT EXCEED 16' IN DESIGNATED SUPPORT AREAS.
OIL & GAS WELL AREAS SHALL BE MINED IN ACCORDANCE WITH THE APPROVED WELL PILLAR PERMIT, NUMBERS SHOWN ON SAID WELLS.
ALL COAL IN THE SUPPORT AREA IN LONGWALL SECTIONS TO BE SOLID, EXCEPT FOR ENTRIES AND CROSSCUTS AS SHOWN, PROJECTED ENTRIES AND CROSSCUTS ARE TYPICAL, AND MAY VARY DUE TO MINING CONDITIONS.
SUBSIDENCE CONTROL PLAN LINE
REVISED 10-28-99
12-30-99
MODULE 19.3