

AIR SHAFT NO. 2 FANS  
 DIESEL--STAND-BY  
 JEFFREY 8-HU-96 AERODYNE FAN IN NO. 3 BLADE POSITION  
 DIRECT DRIVE WITH 685 H.P. DIESEL ENGINE POWER UNIT  
 OPERATING AT A NOMINAL 900 R.P.M.  
 ELECTRIC-- OPERATING  
 JEFFREY 8-HU-96 AERODYNE FAN IN NO. 3 BLADE POSITION  
 DIRECT DRIVE WITH 500 H.P., 2400 V., A.C. MOTOR  
 OPERATING AT 85 AMPS. AND NOMINAL 900 R.P.M.  
 TOP COPING ELEVATION - 950.0'  
 BOTTOM COAL ELEVATION - 617.3'  
 DEPTH - 332.7'  
 ENTRY HEIGHT - 6.3' AVG.  
 ENTRY WIDTH - 16.0' AVG.


AIR SHAFT NO. 1  
 TOP COPING ELEVATION - 791.2'  
 BOTTOM COAL ELEVATION - 630.5'  
 DEPTH - 160.7'  
 ENTRY HEIGHT - 6.3' AVG.  
 ENTRY WIDTH - 16.0' AVG.

BENCH MARK  
 ELEVATION - 786.76  
 Located on Anchor Bolt  
 of Water Tank Leg Facing Valve Box

Electric Fan	Blade Pts	Water Gauge	Water Current	Intake (C.F.M.)	Exhaust (C.F.M.)
Before	3				
After	3				

BASE LINE POINT  
 11+00.52  
 IRON PIN  
 N - 14304 58  
 W - 32678 17

BENCH MARK  
 ELEVATION - 786.68  
 Located 8.7 Ft. On  
 Blacksmith Spud In  
 Concrete Foundation  
 Wall Facing South Of  
 The Water Filtration  
 Plant.

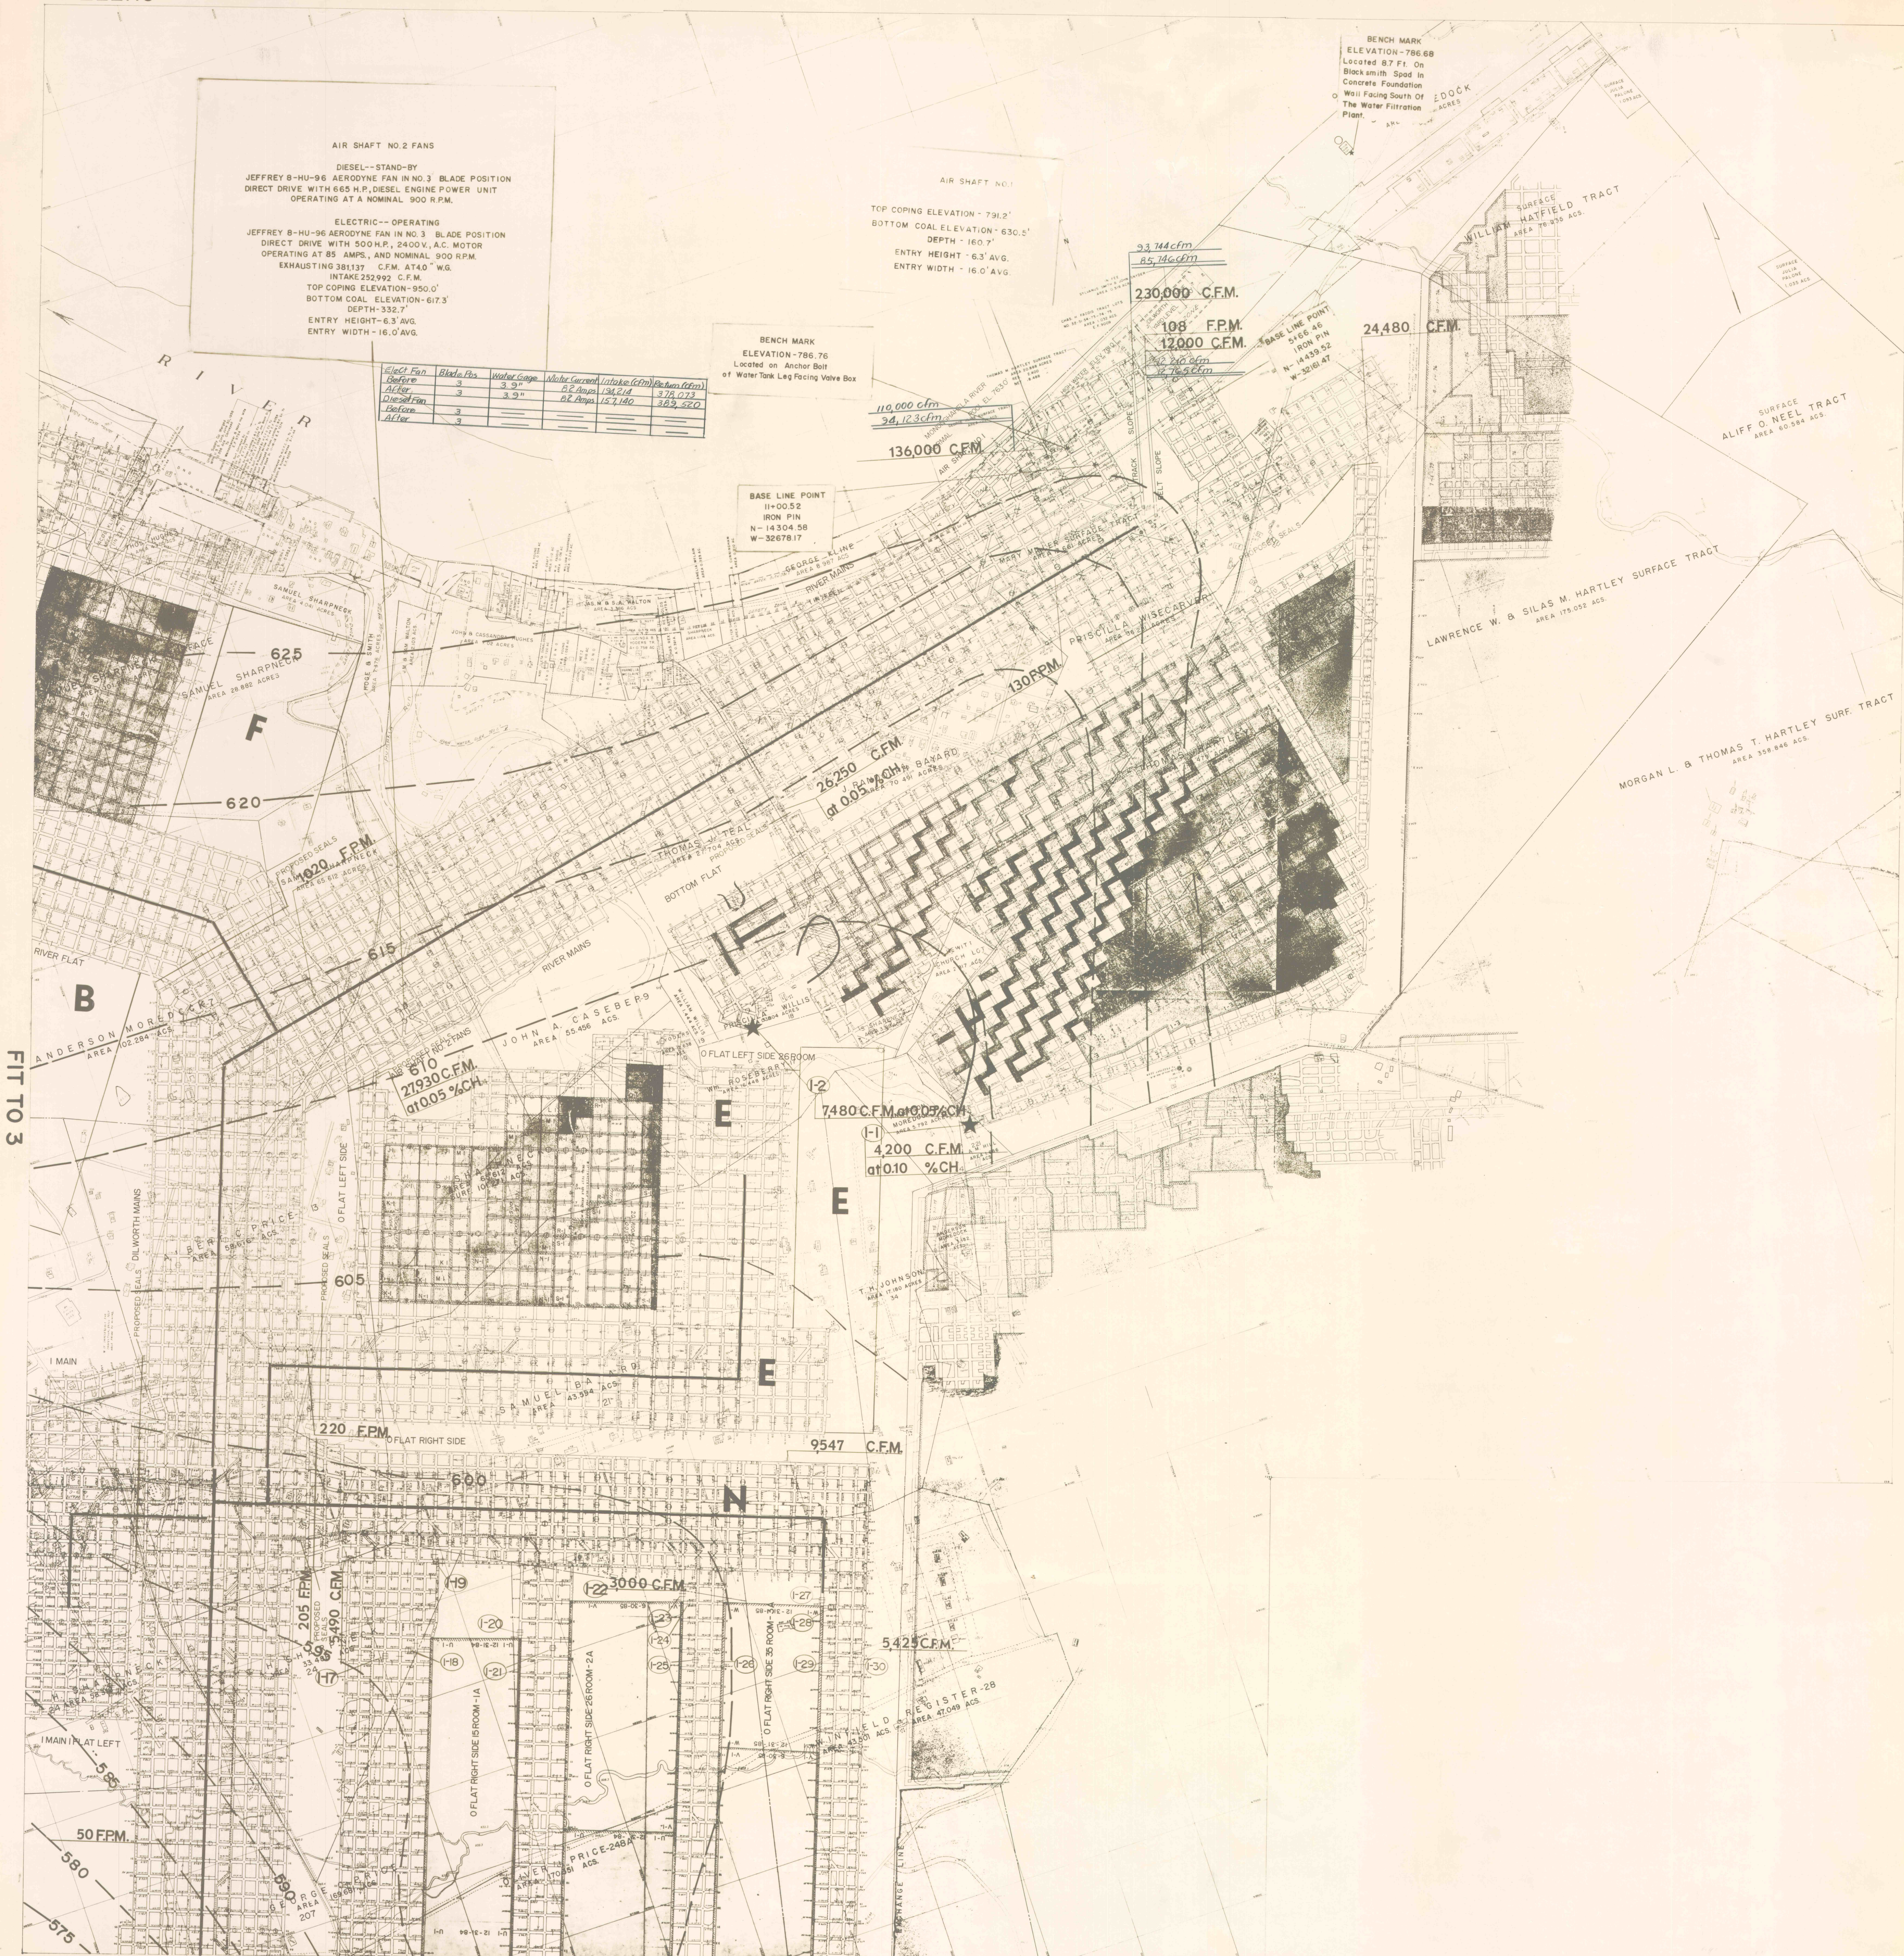

FIT TO 3

FIT TO 7