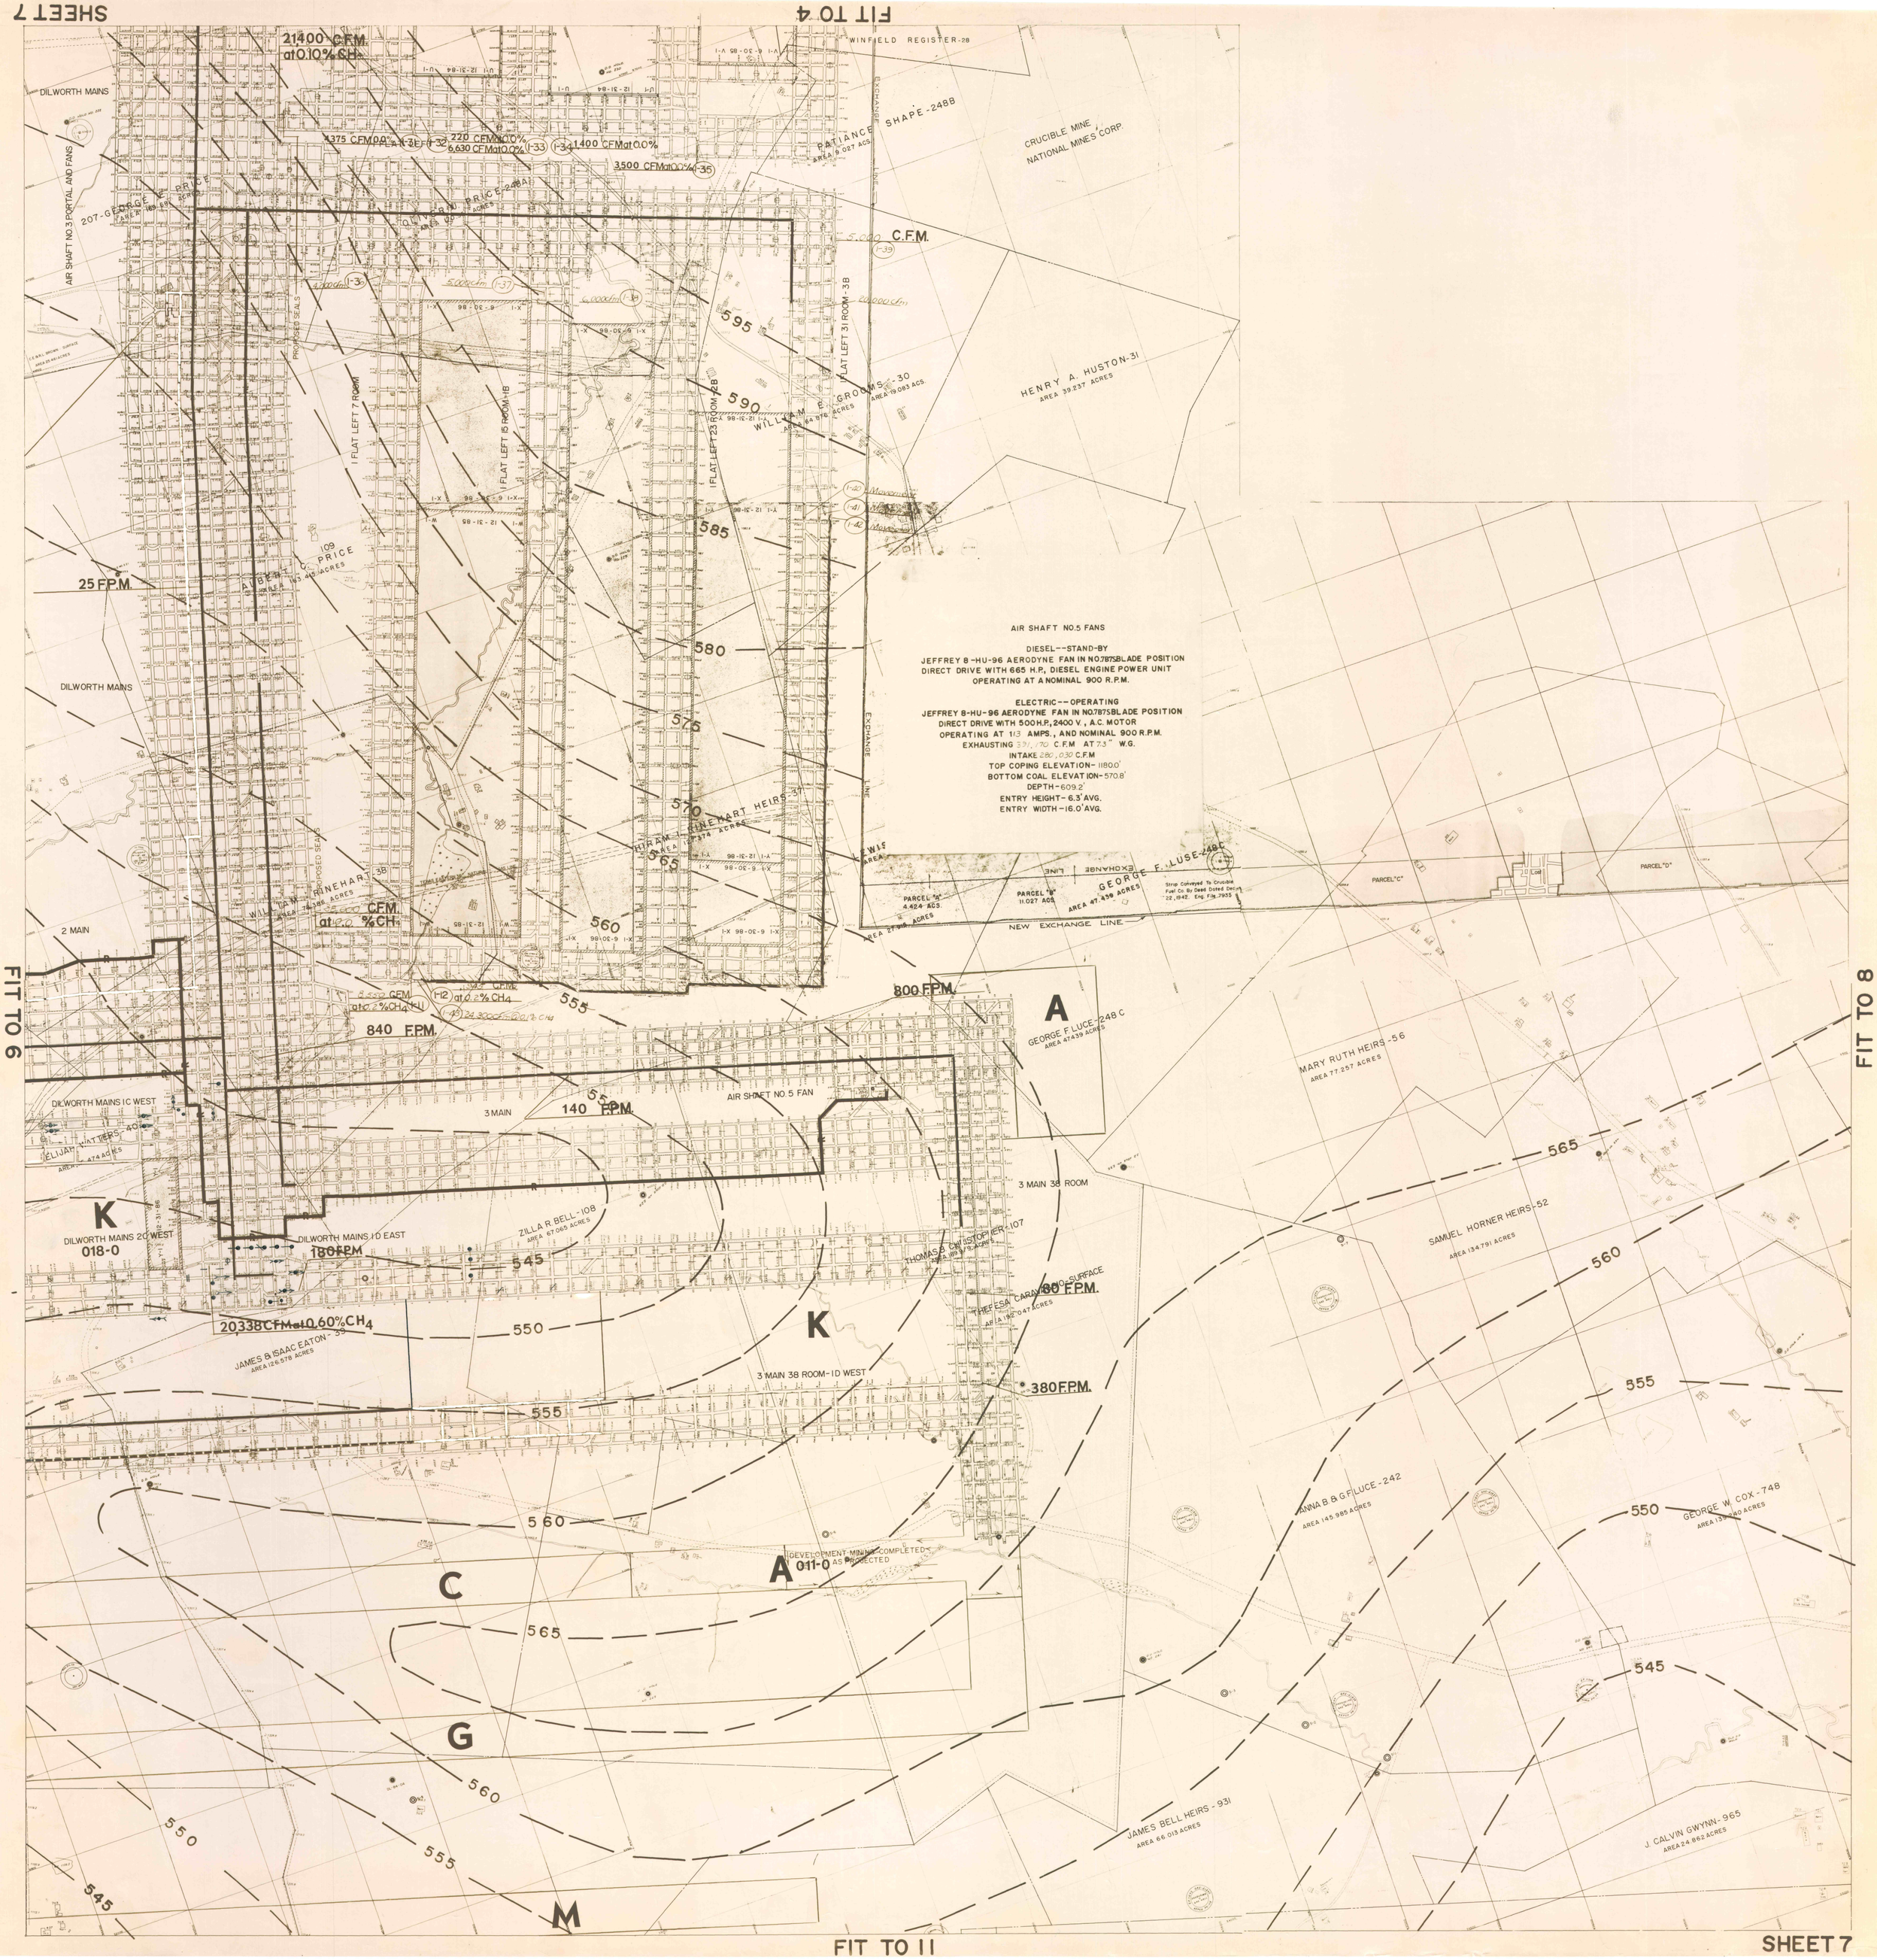
21,400 C.F.M. at 0.10% CH4
WINFIELD REGISTER-28
DILWORTH MAINS
AIR SHAFT NO.3 PORTAL AND FANS
207-GEORGE E. PRICE
AREA 185.688 ACRES
375 CFM 0.0%
220 CFM 0.0%
6,630 CFM at 0.0%
1,400 CFM at 0.0%
3,500 CFM at 0.0%
PATIANCE SHAPE-248B
AREA 9.027 ACS.
CRUCIBLE MINE
NATIONAL MINES CORP.
EXCHANGE LINE
5,000 C.F.M.
PROPOSED SEALS
1 FLAT LEFT 7 ROOM
1 FLAT LEFT 15 ROOM-1B
1 FLAT LEFT 23 ROOM-2B
1 FLAT LEFT 31 ROOM-3B
595
590
WILLIAM E. GROOMS-30
AREA 19.083 ACS.
HENRY A. HUSTON-31
AREA 39.237 ACRES
585
25 F.P.M.
ALBERT C. PRICE
AREA 145.45 ACRES
580
AIR SHAFT NO.5 FANS
DIESEL--STAND-BY
JEFFREY 8-HU-96 AERODYNE FAN IN NO.787S BLADE POSITION
DIRECT DRIVE WITH 665 H.P., DIESEL ENGINE POWER UNIT
OPERATING AT A NOMINAL 900 R.P.M.
ELECTRIC--OPERATING
JEFFREY 8-HU-96 AERODYNE FAN IN NO.787S BLADE POSITION
DIRECT DRIVE WITH 500 H.P., 2400 V., A.C. MOTOR
OPERATING AT 113 AMPS., AND NOMINAL 900 R.P.M.
EXHAUSTING 331,170 C.F.M AT 7.3" W.G.
INTAKE 280,030 C.F.M
TOP COPING ELEVATION-1180.0'
BOTTOM COAL ELEVATION-570.8'
DEPTH-609.2'
ENTRY HEIGHT-6.3' AVG.
ENTRY WIDTH-16.0' AVG.
575
570
HIRAM GINEHART HEIRS-37
AREA 17.374 ACRES
565
PARCEL "A" 4.424 ACS.
PARCEL "B" 11.027 ACS.
GEORGE F. LUSE-248C
AREA 47.439 ACRES
Strip Conveyed To Crucible Fuel Co. By Deed Dated Dec. 22, 1942. Eng. File 7933
PARCEL "C"
PARCEL "D"
NEW EXCHANGE LINE
WILLIAM GINEHART-38
AREA 14.186 ACRES
35,600 C.F.M. at 0.0 %CH4
560
2 MAIN
FIT TO 6
555
840 F.P.M.
800 F.P.M.
A
GEORGE F. LUSE-248 C
AREA 47.439 ACRES
MARY RUTH HEIRS-56
AREA 77.257 ACRES
DILWORTH MAINS 1C WEST
ELIJAH WATTERS-40
AREA 1.474 ACRES
3 MAIN
140 F.P.M.
AIR SHAFT NO.5 FAN
3 MAIN 38 ROOM
565
K
DILWORTH MAINS 2C WEST
018-0
DILWORTH MAINS 1D EAST
180 F.P.M.
545
ZILLA R. BELL-108
AREA 67.065 ACRES
THOMAS & CHRISTOPHER-107
AREA 189.73 ACRES
SAMUEL HORNER HEIRS-52
AREA 134.791 ACRES
560
THEFESA CARAVELLO-SURFACE
AREA 192.047 ACRES
80 F.P.M.
20338 CFM at 0.60% CH4
550
JAMES & ISAAC EATON-39
AREA 126.578 ACRES
K
3 MAIN 38 ROOM-1D WEST
380 F.P.M.
555
ANNA B. & G. F. LUCE-242
AREA 145.985 ACRES
GEORGE W. COX-748
AREA 13.240 ACRES
560
DEVELOPMENT MINING COMPLETED AS PROJECTED
011-0
A
C
565
545
G
560
550
555
545
M
JAMES BELL HEIRS-931
AREA 66.013 ACRES
J. CALVIN GWYNN-965
AREA 24.862 ACRES
FIT TO 8