



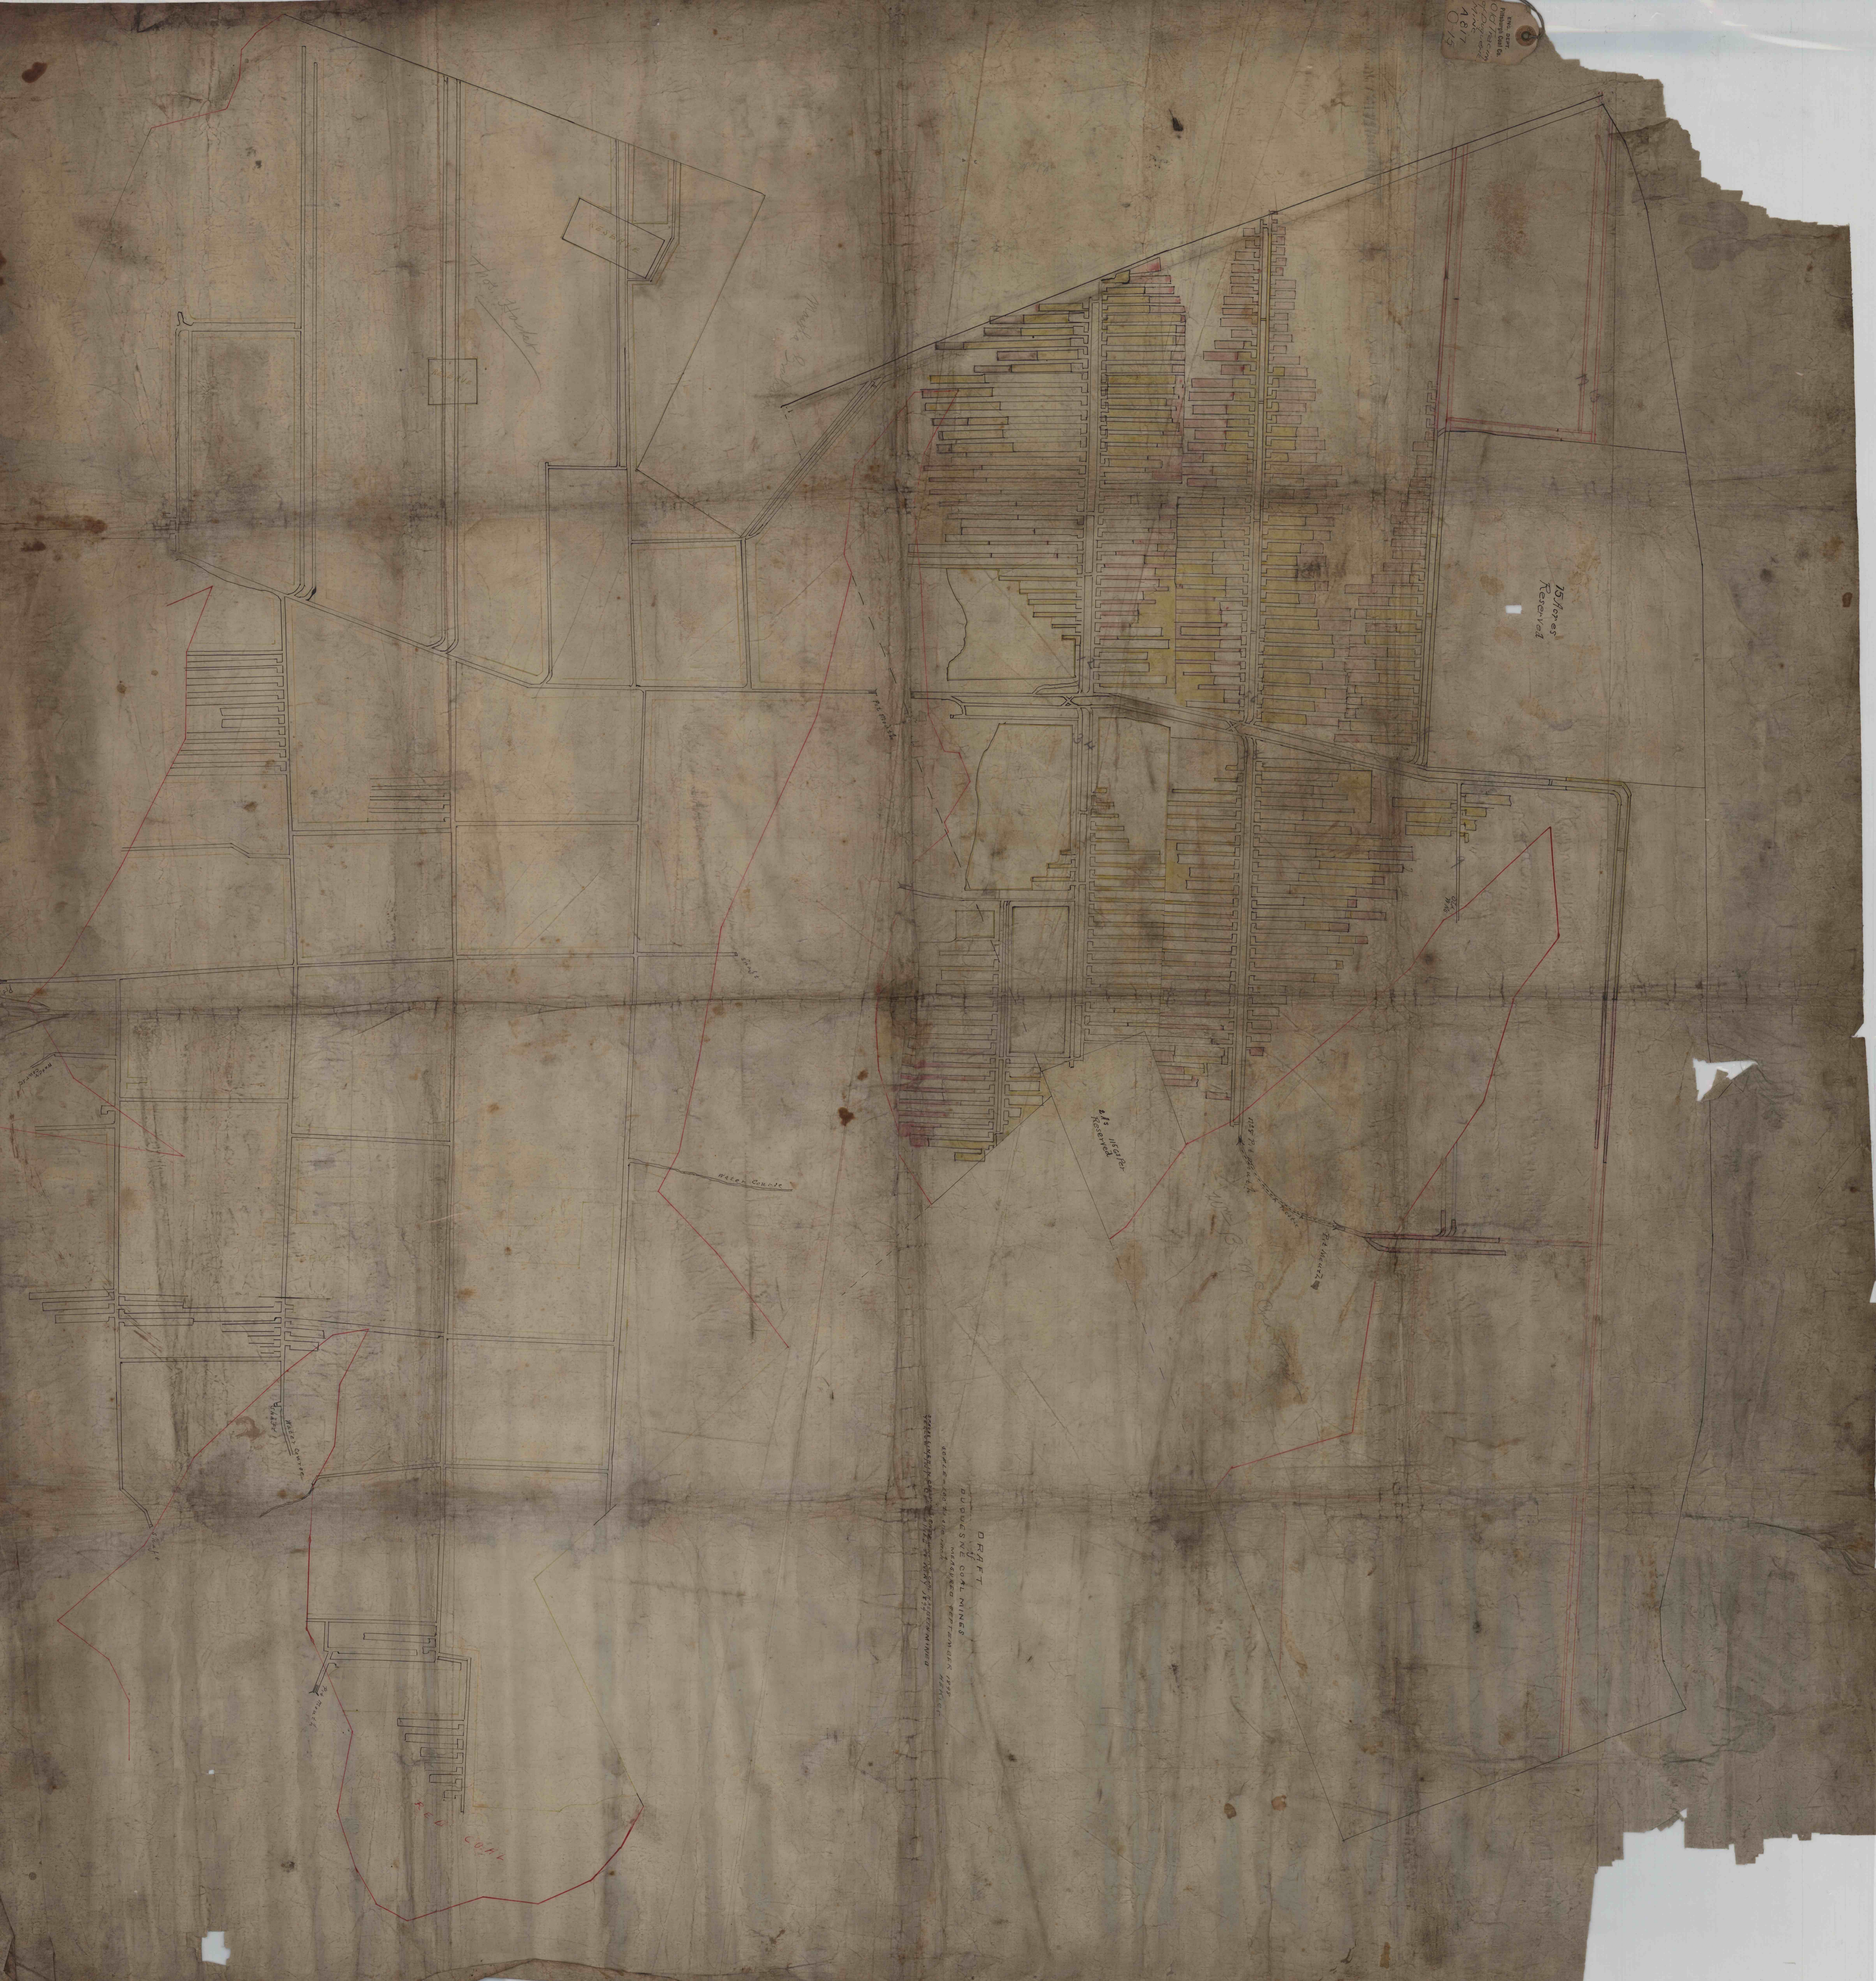

DRAFT  
DUQUESNE COAL MINES  







