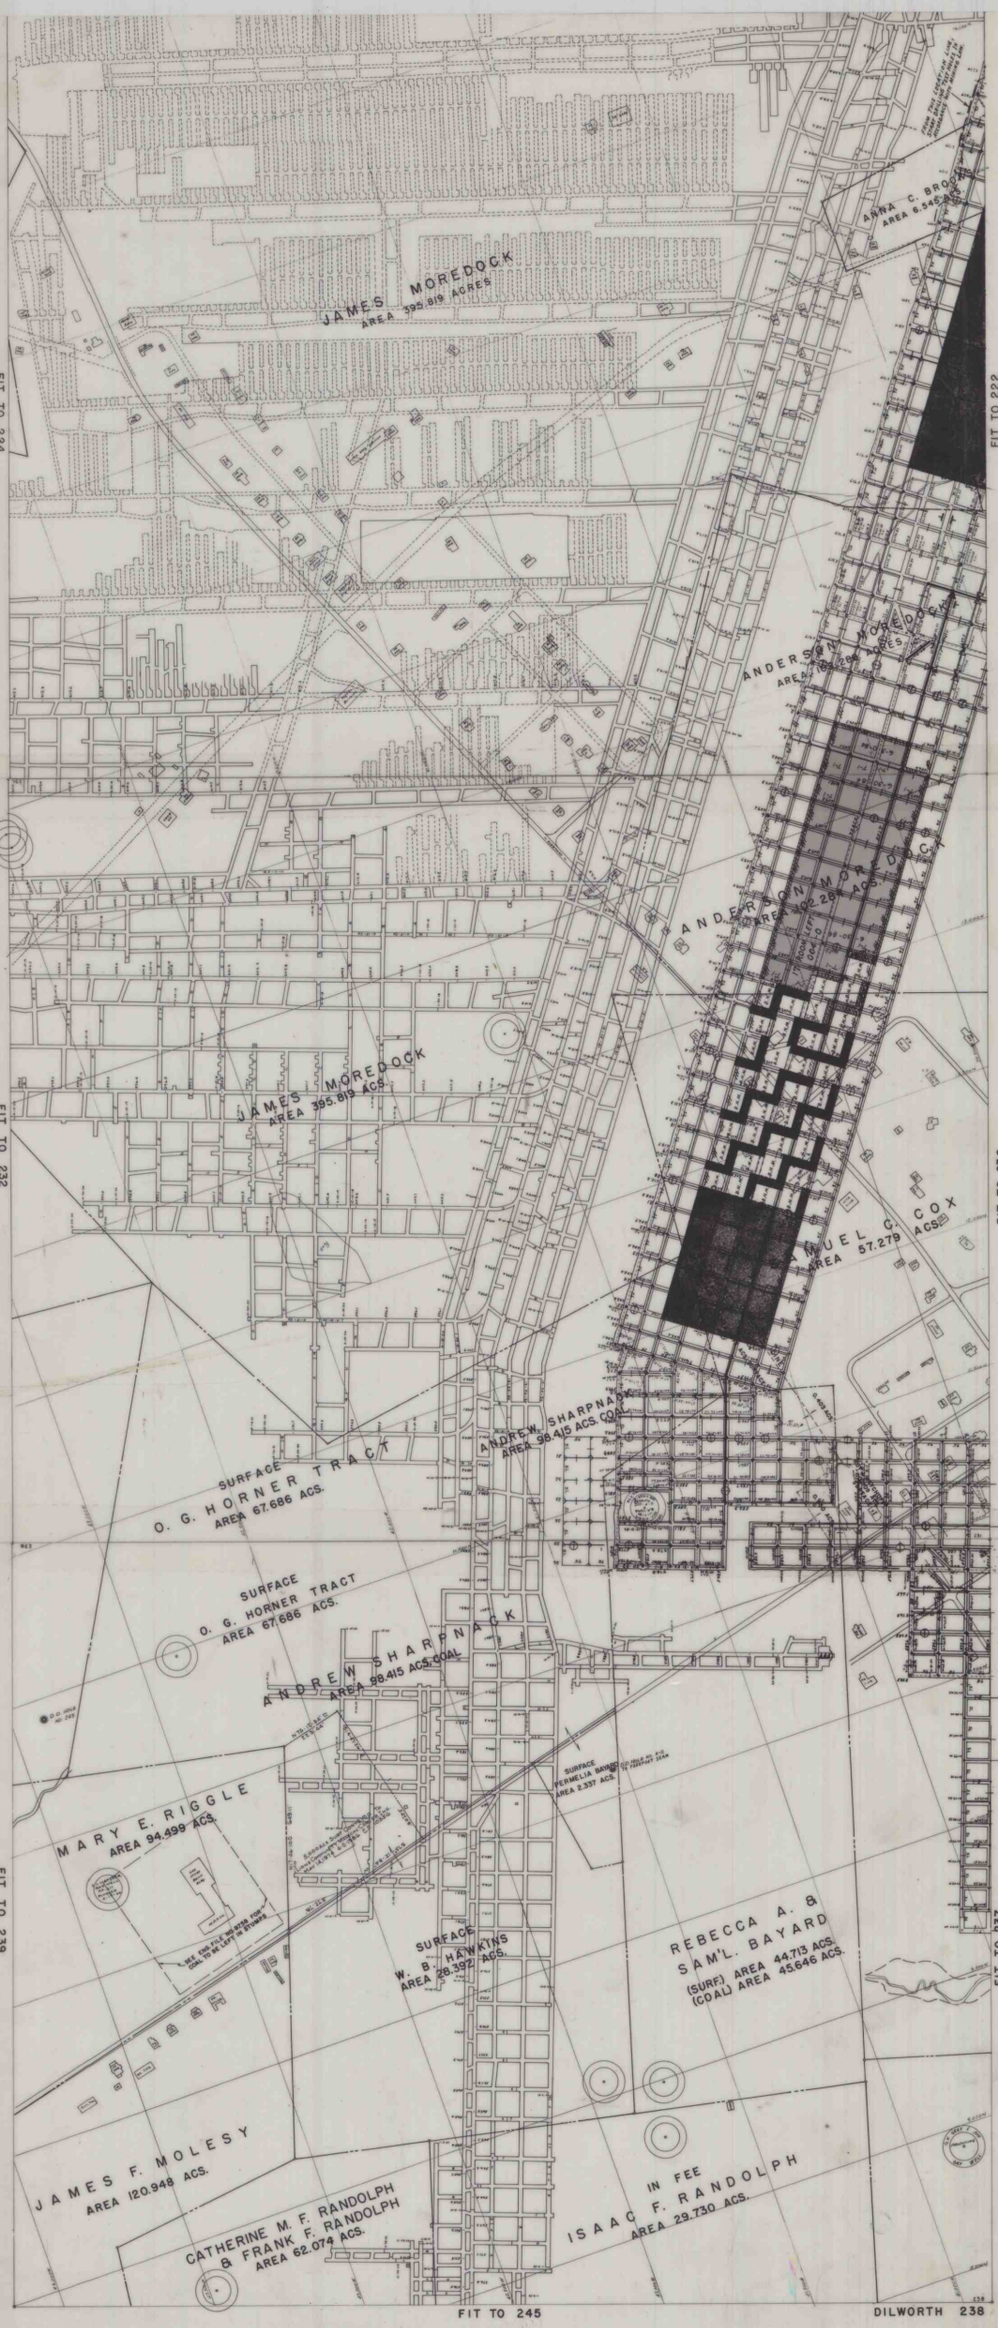

JAMES MOREDOCK
AREA 395.819 ACRES
ANNA C. BROOKS
AREA 6.545 ACS.
ANDERSON MOREDOCK
AREA 102.284 ACS.
ANDERSON MOREDOCK
AREA 102.284 ACS.
JAMES MOREDOCK
AREA 395.819 ACS.
SAMUEL C. COX
AREA 57.279 ACS.
ANDREW SHARPNACK
AREA 98.415 ACS. COAL
SURFACE
O. G. HORNER TRACT
AREA 67.686 ACS.
SURFACE
O. G. HORNER TRACT
AREA 67.686 ACS.
ANDREW SHARPNACK
AREA 98.415 ACS. COAL
SURFACE
PERMELIA BAYARD
AREA 2.337 ACS.
MARY E. RIGGLE
AREA 94.499 ACS.
SEE CON FILE NO 8738 FOR COAL TO BE LEFT IN STUMPS
SURFACE
W. B. HAWKINS
AREA 28.392 ACS.
REBECCA A. &
SAM'L. BAYARD
(SURF.) AREA 44.713 ACS.
(COAL) AREA 45.646 ACS.
JAMES F. MOLESY
AREA 120.948 ACS.
CATHERINE M. F. RANDOLPH
& FRANK F. RANDOLPH
AREA 62.074 ACS.
IN FEE
ISAAC F. RANDOLPH
AREA 29.730 ACS.
FIT TO 224
FIT TO 222
FIT TO 232
FIT TO 230
FIT TO 239
FIT TO 237
FIT TO 245
DILWORTH 238