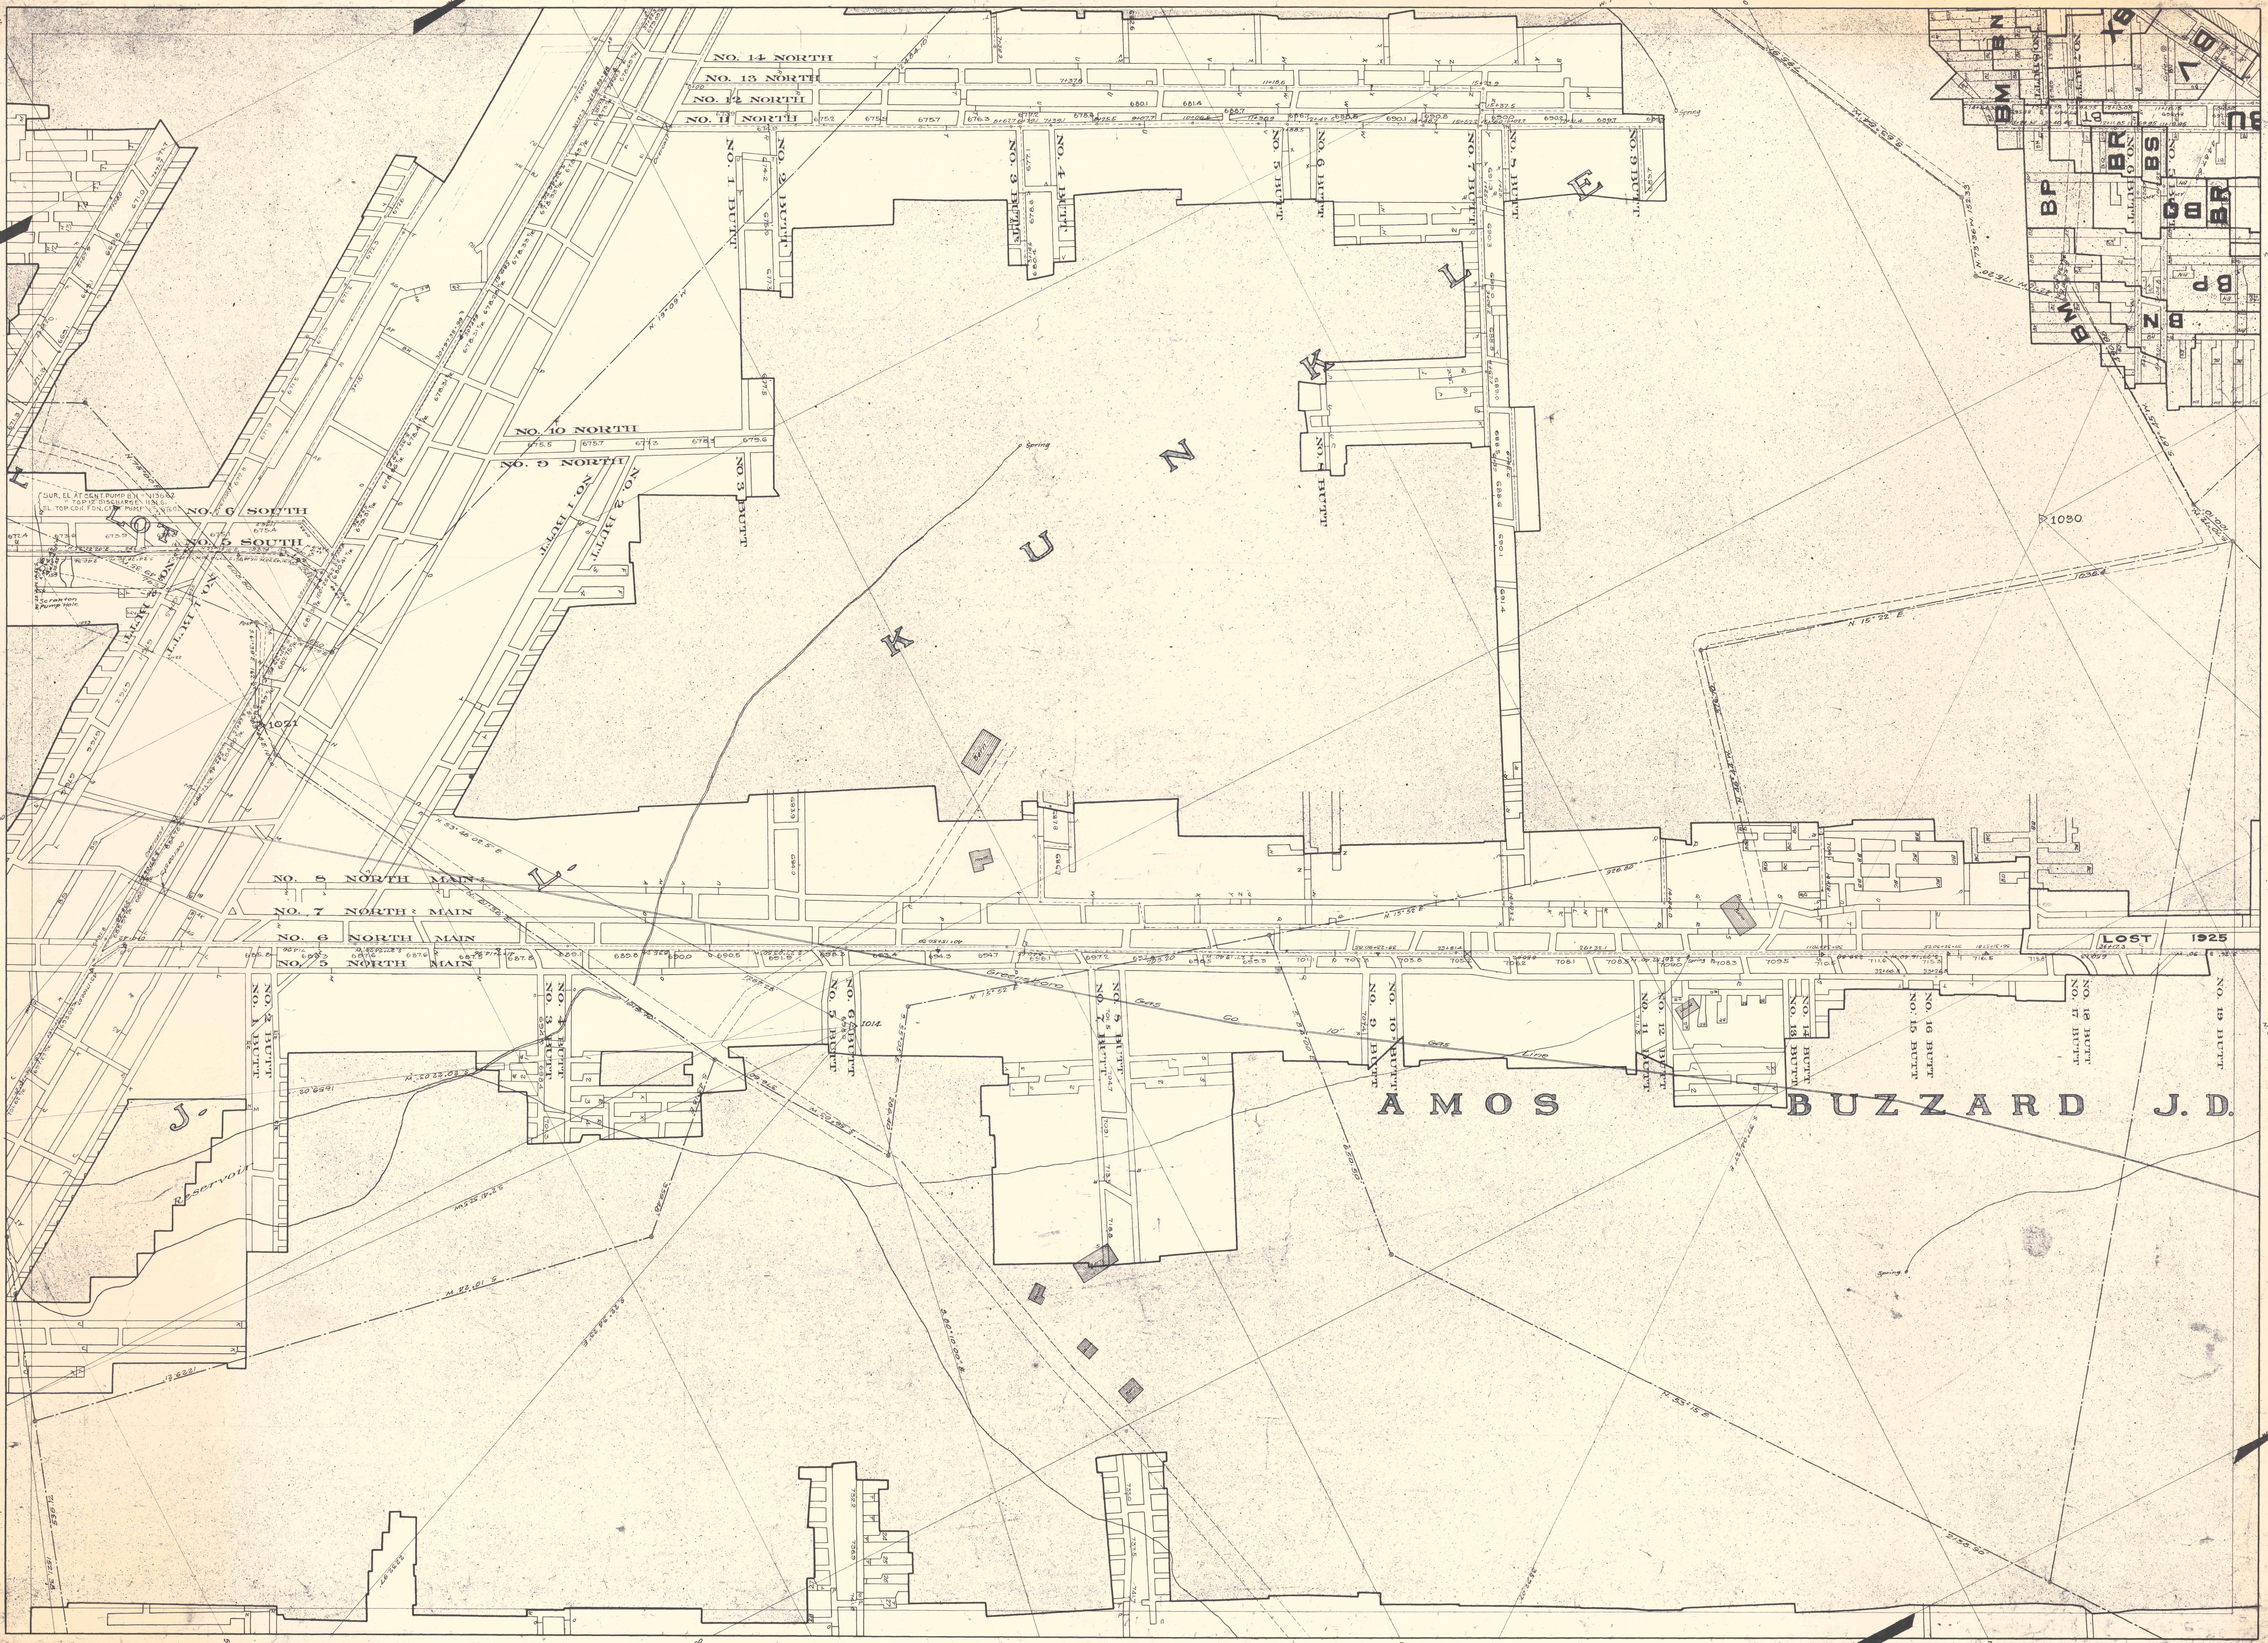
NO. 14 NORTH
NO. 13 NORTH
NO. 12 NORTH
NO. 11 NORTH
NO. 10 NORTH
NO. 9 NORTH
NO. 6 SOUTH
NO. 5 SOUTH
NO. 1 BUTT
NO. 2 BUTT
NO. 3 BUTT
NO. 4 BUTT
NO. 5 BUTT
NO. 6 BUTT
NO. 7 BUTT
NO. 8 BUTT
NO. 9 BUTT
SUR. EL. AT CENT. PUMP B.H. = 1136.82
TOP 12" DISCHARGE = 1131.61
EL. TOP CON. FDN. CENT. PUMP = 1076.02
Scranton Pump Hole
1021
Spring
Barn
House
K U N K L E
L
J.
Reservoir
NO. 8 NORTH MAIN
NO. 7 NORTH MAIN
NO. 6 NORTH MAIN
NO. 5 NORTH MAIN
1014
Greensboro Gas Co. 10" Gas Line
NO. 10 BUTT
NO. 11 BUTT
NO. 12 BUTT
NO. 13 BUTT
NO. 14 BUTT
NO. 15 BUTT
NO. 16 BUTT
NO. 17 BUTT
NO. 18 BUTT
NO. 19 BUTT
LOST 1925
AMOS BUZZARD J.D.
1030
N. 15° 22' E.
BM
BN
BP
BR
BS
BQ
BB
BZ
N. 53° 15' E
W. 10000
W. 9000
W. 8000
W. 7000
N. 1000
N. 2000
N. 3000
S. 1000