


1-01-0

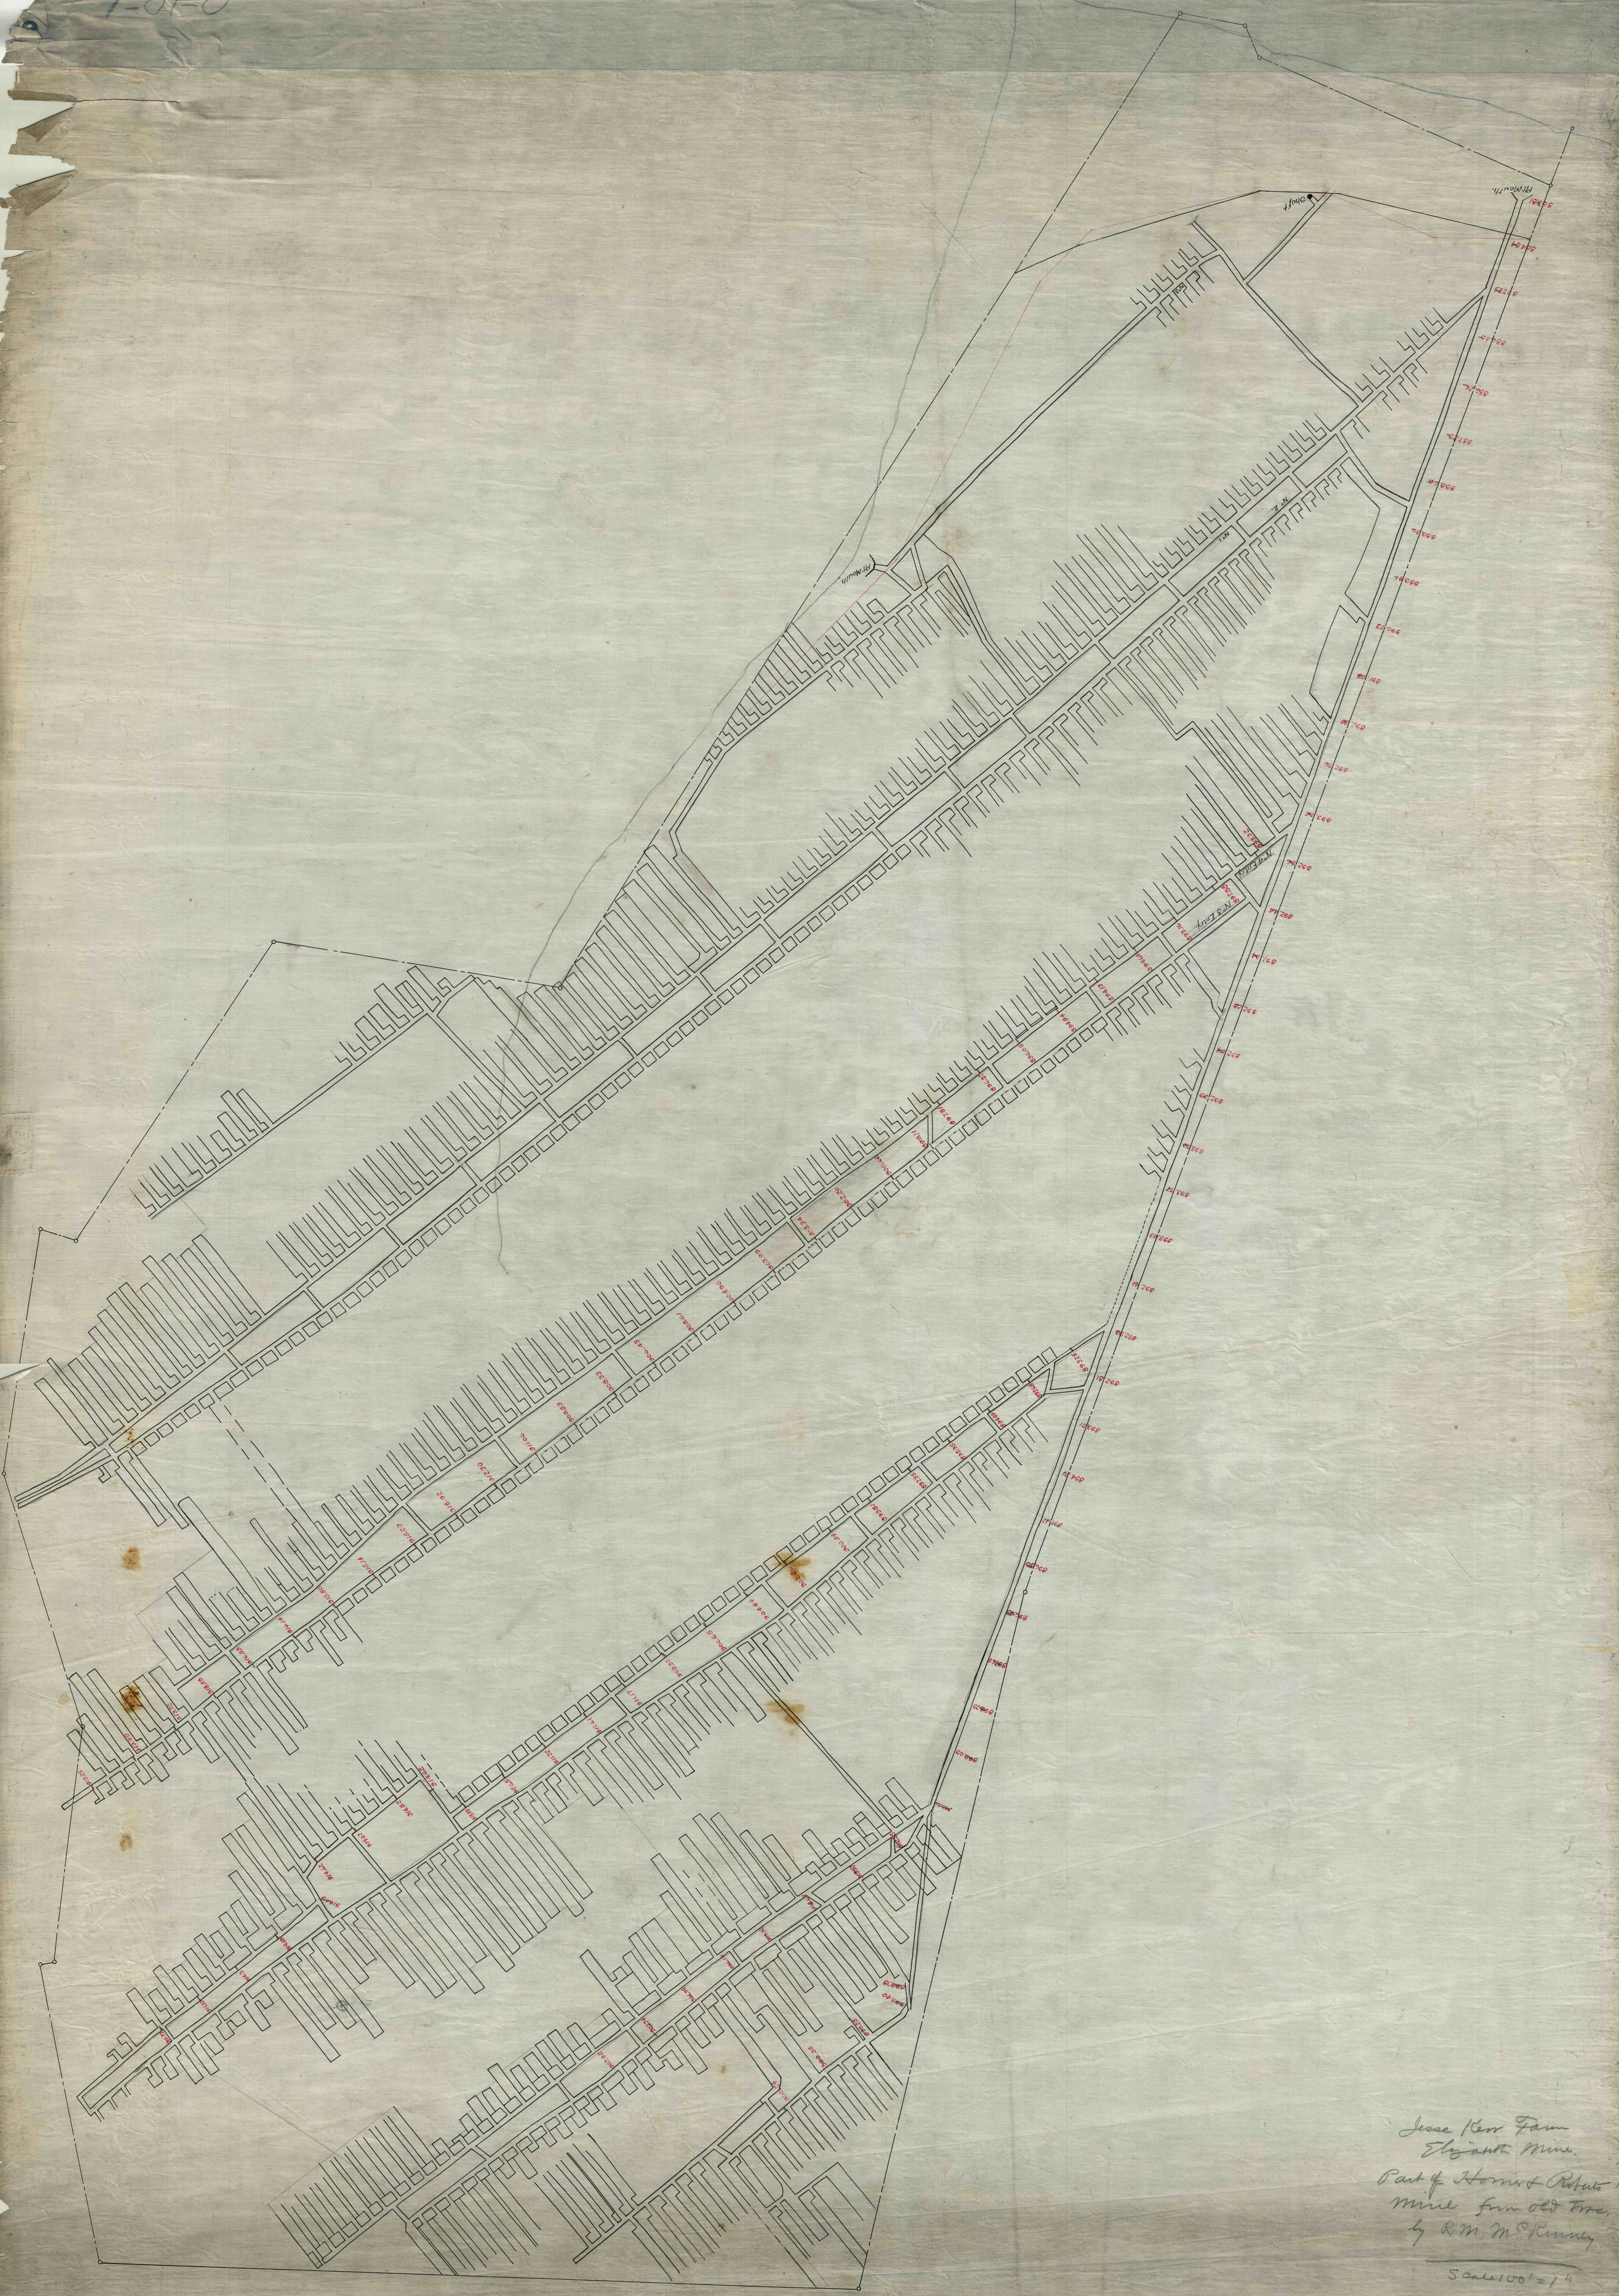

Jesse Kerr Farm
by R.M. McKinney
Scale 100' = 1"