



NO 43 & 42 BUTT SECTION HANNASTOWN MINE

42 & 43 BUTT SECTION - HANNASTOWN MINE

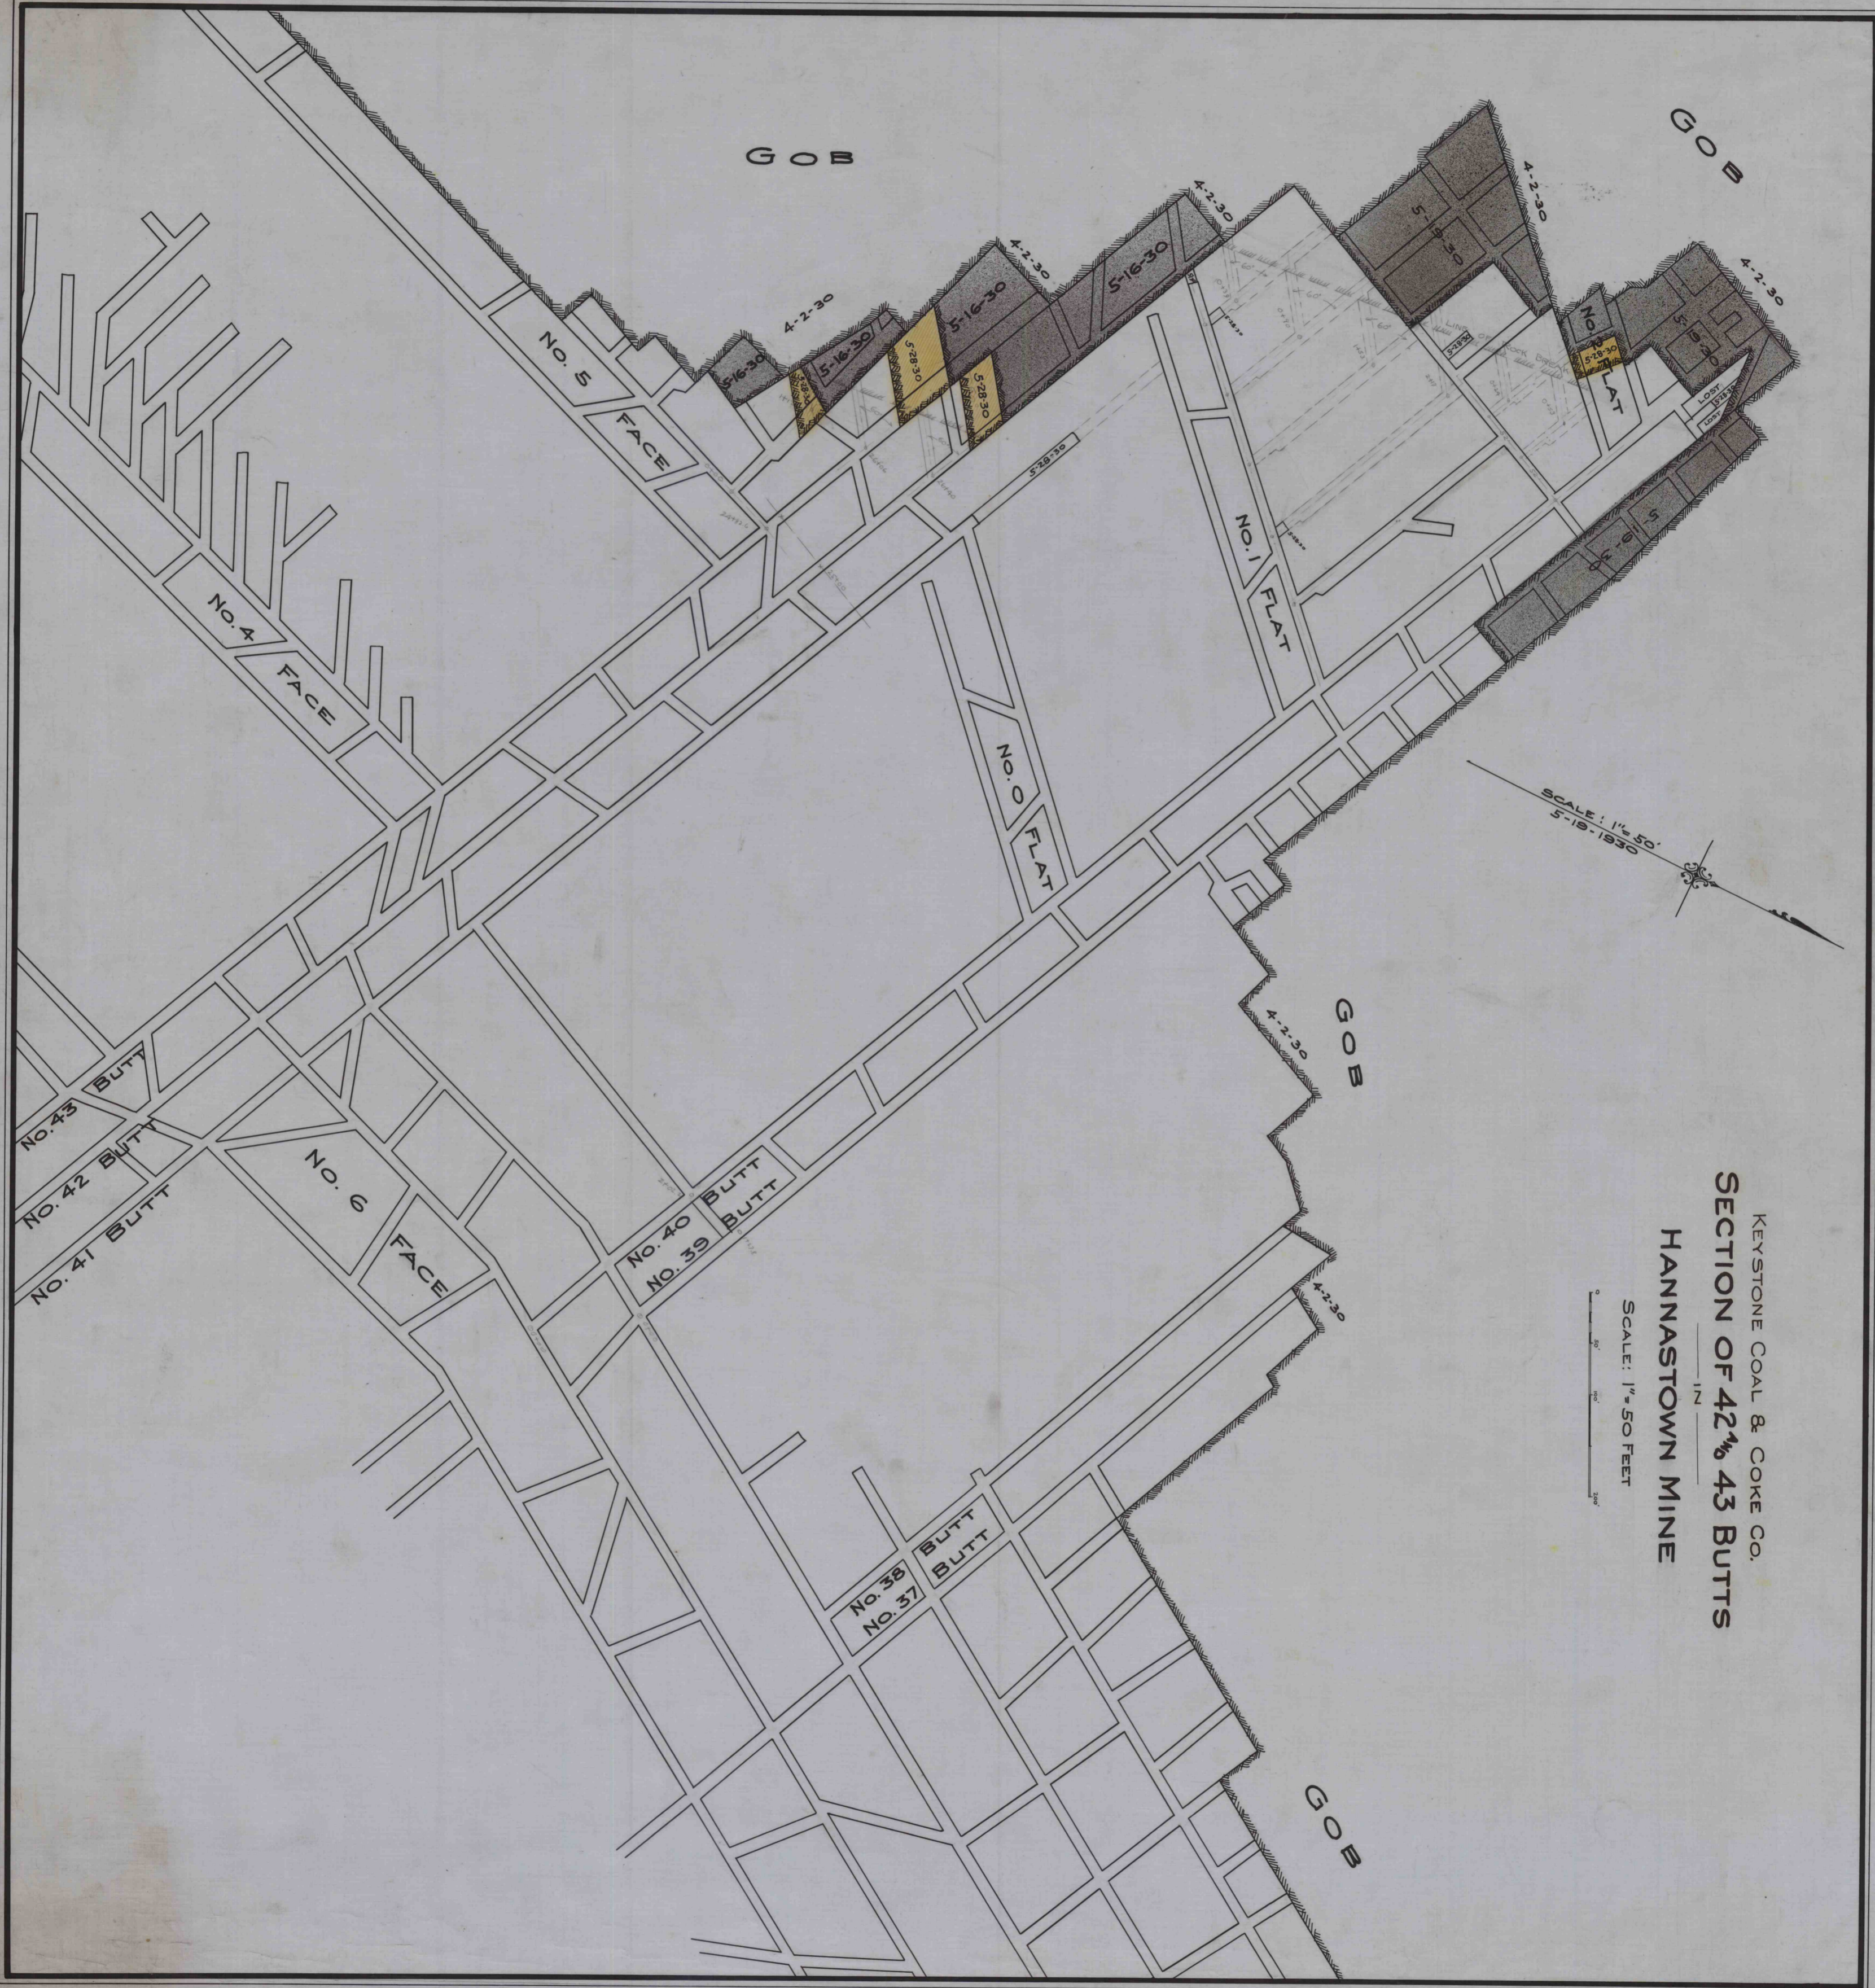

KEYSTONE COAL & COKE CO.
SECTION OF 42¹/₂ 43 BUTTS
 IN
HANNASTOWN MINE

SCALE: 1" = 50 FEET

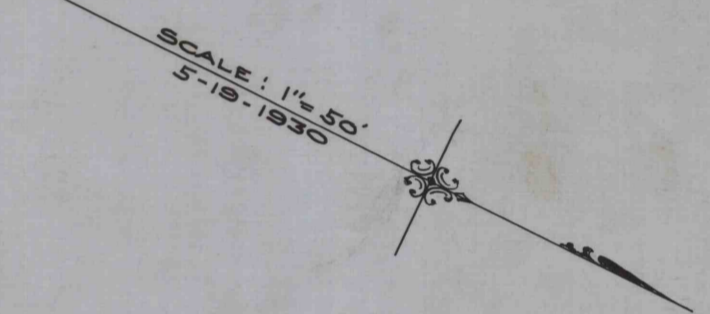

GOB

GOB

GOB

GOB

No. 5

FACE

No. 4

FACE

No. 1

FLAT

No. 0

FLAT

No. 6

FACE

No. 40

BUTT

No. 39

BUTT

No. 38

BUTT

No. 37

BUTT

4-2-30

5-16-30

5-28-30

5-28-30

4-2-30

5-16-30

5-16-30

4-2-30

4-2-30

4-2-30

4-2-30

4-2-30

5-28-30

5-28-30

