


K-5060

FIT TO 5057

FIT TO 5059

FIT TO 5061

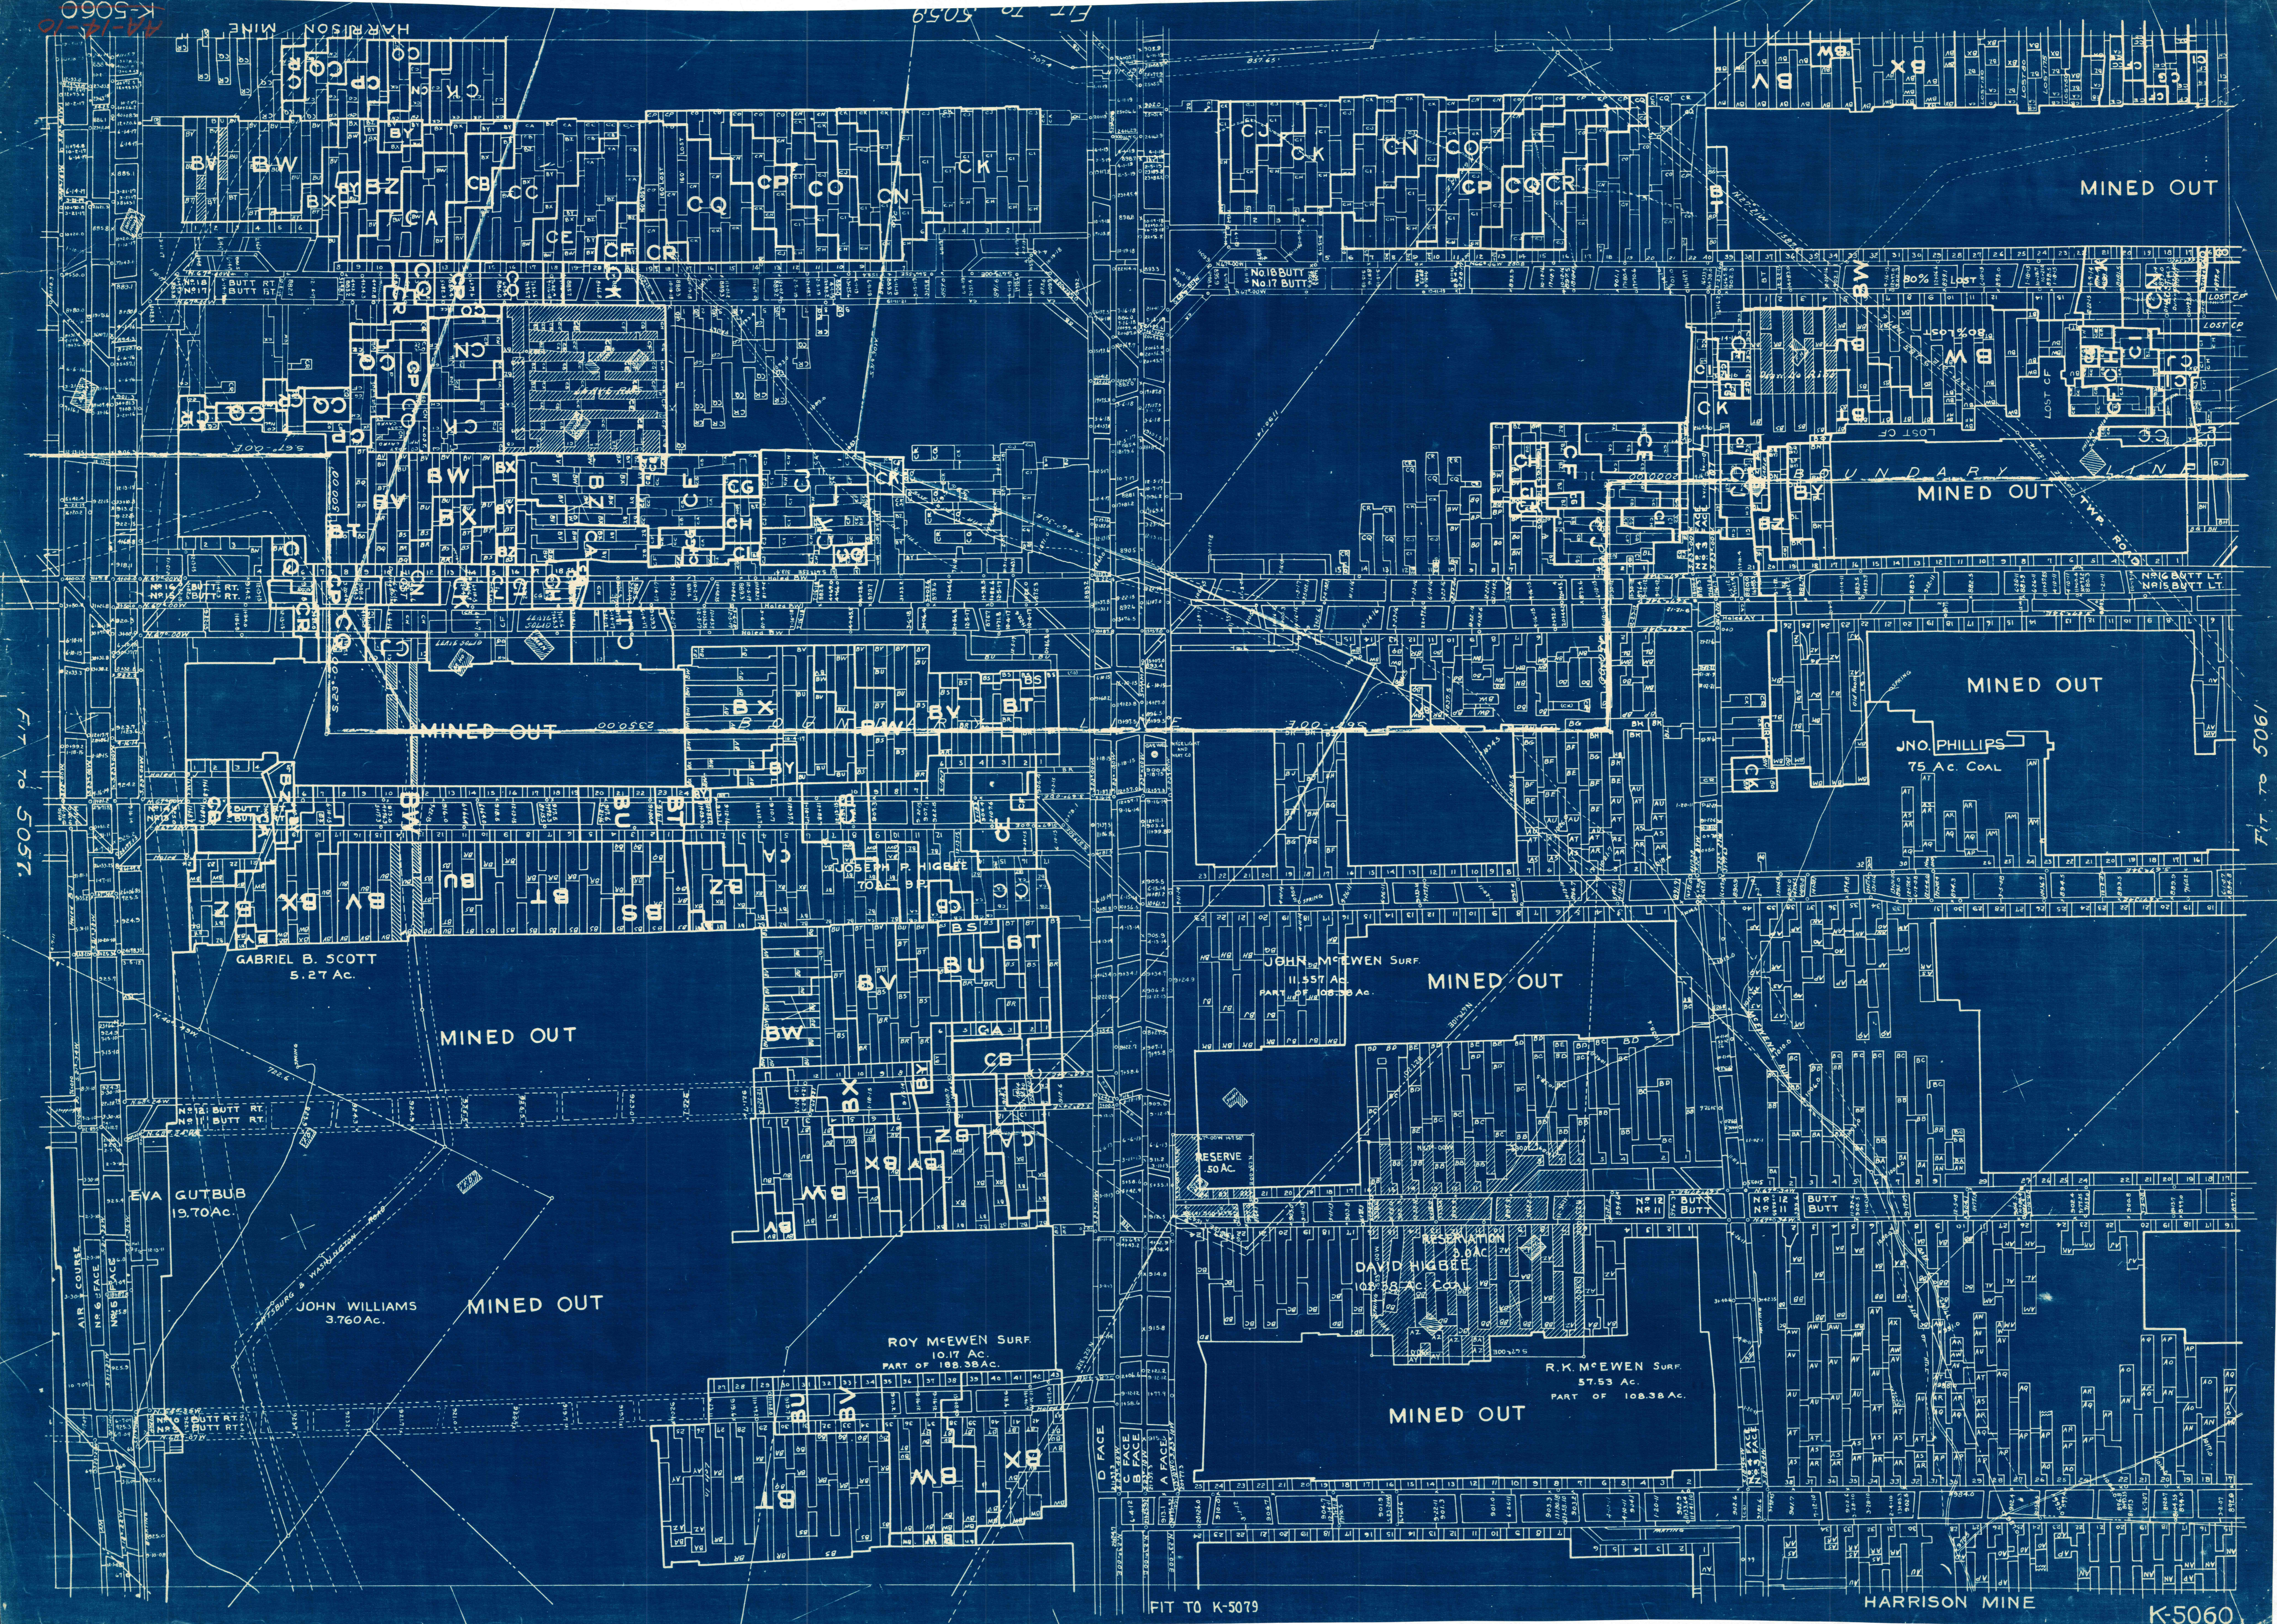

FIT TO K-5079

K-5060