


K-5059

HARRISON MINE

5060

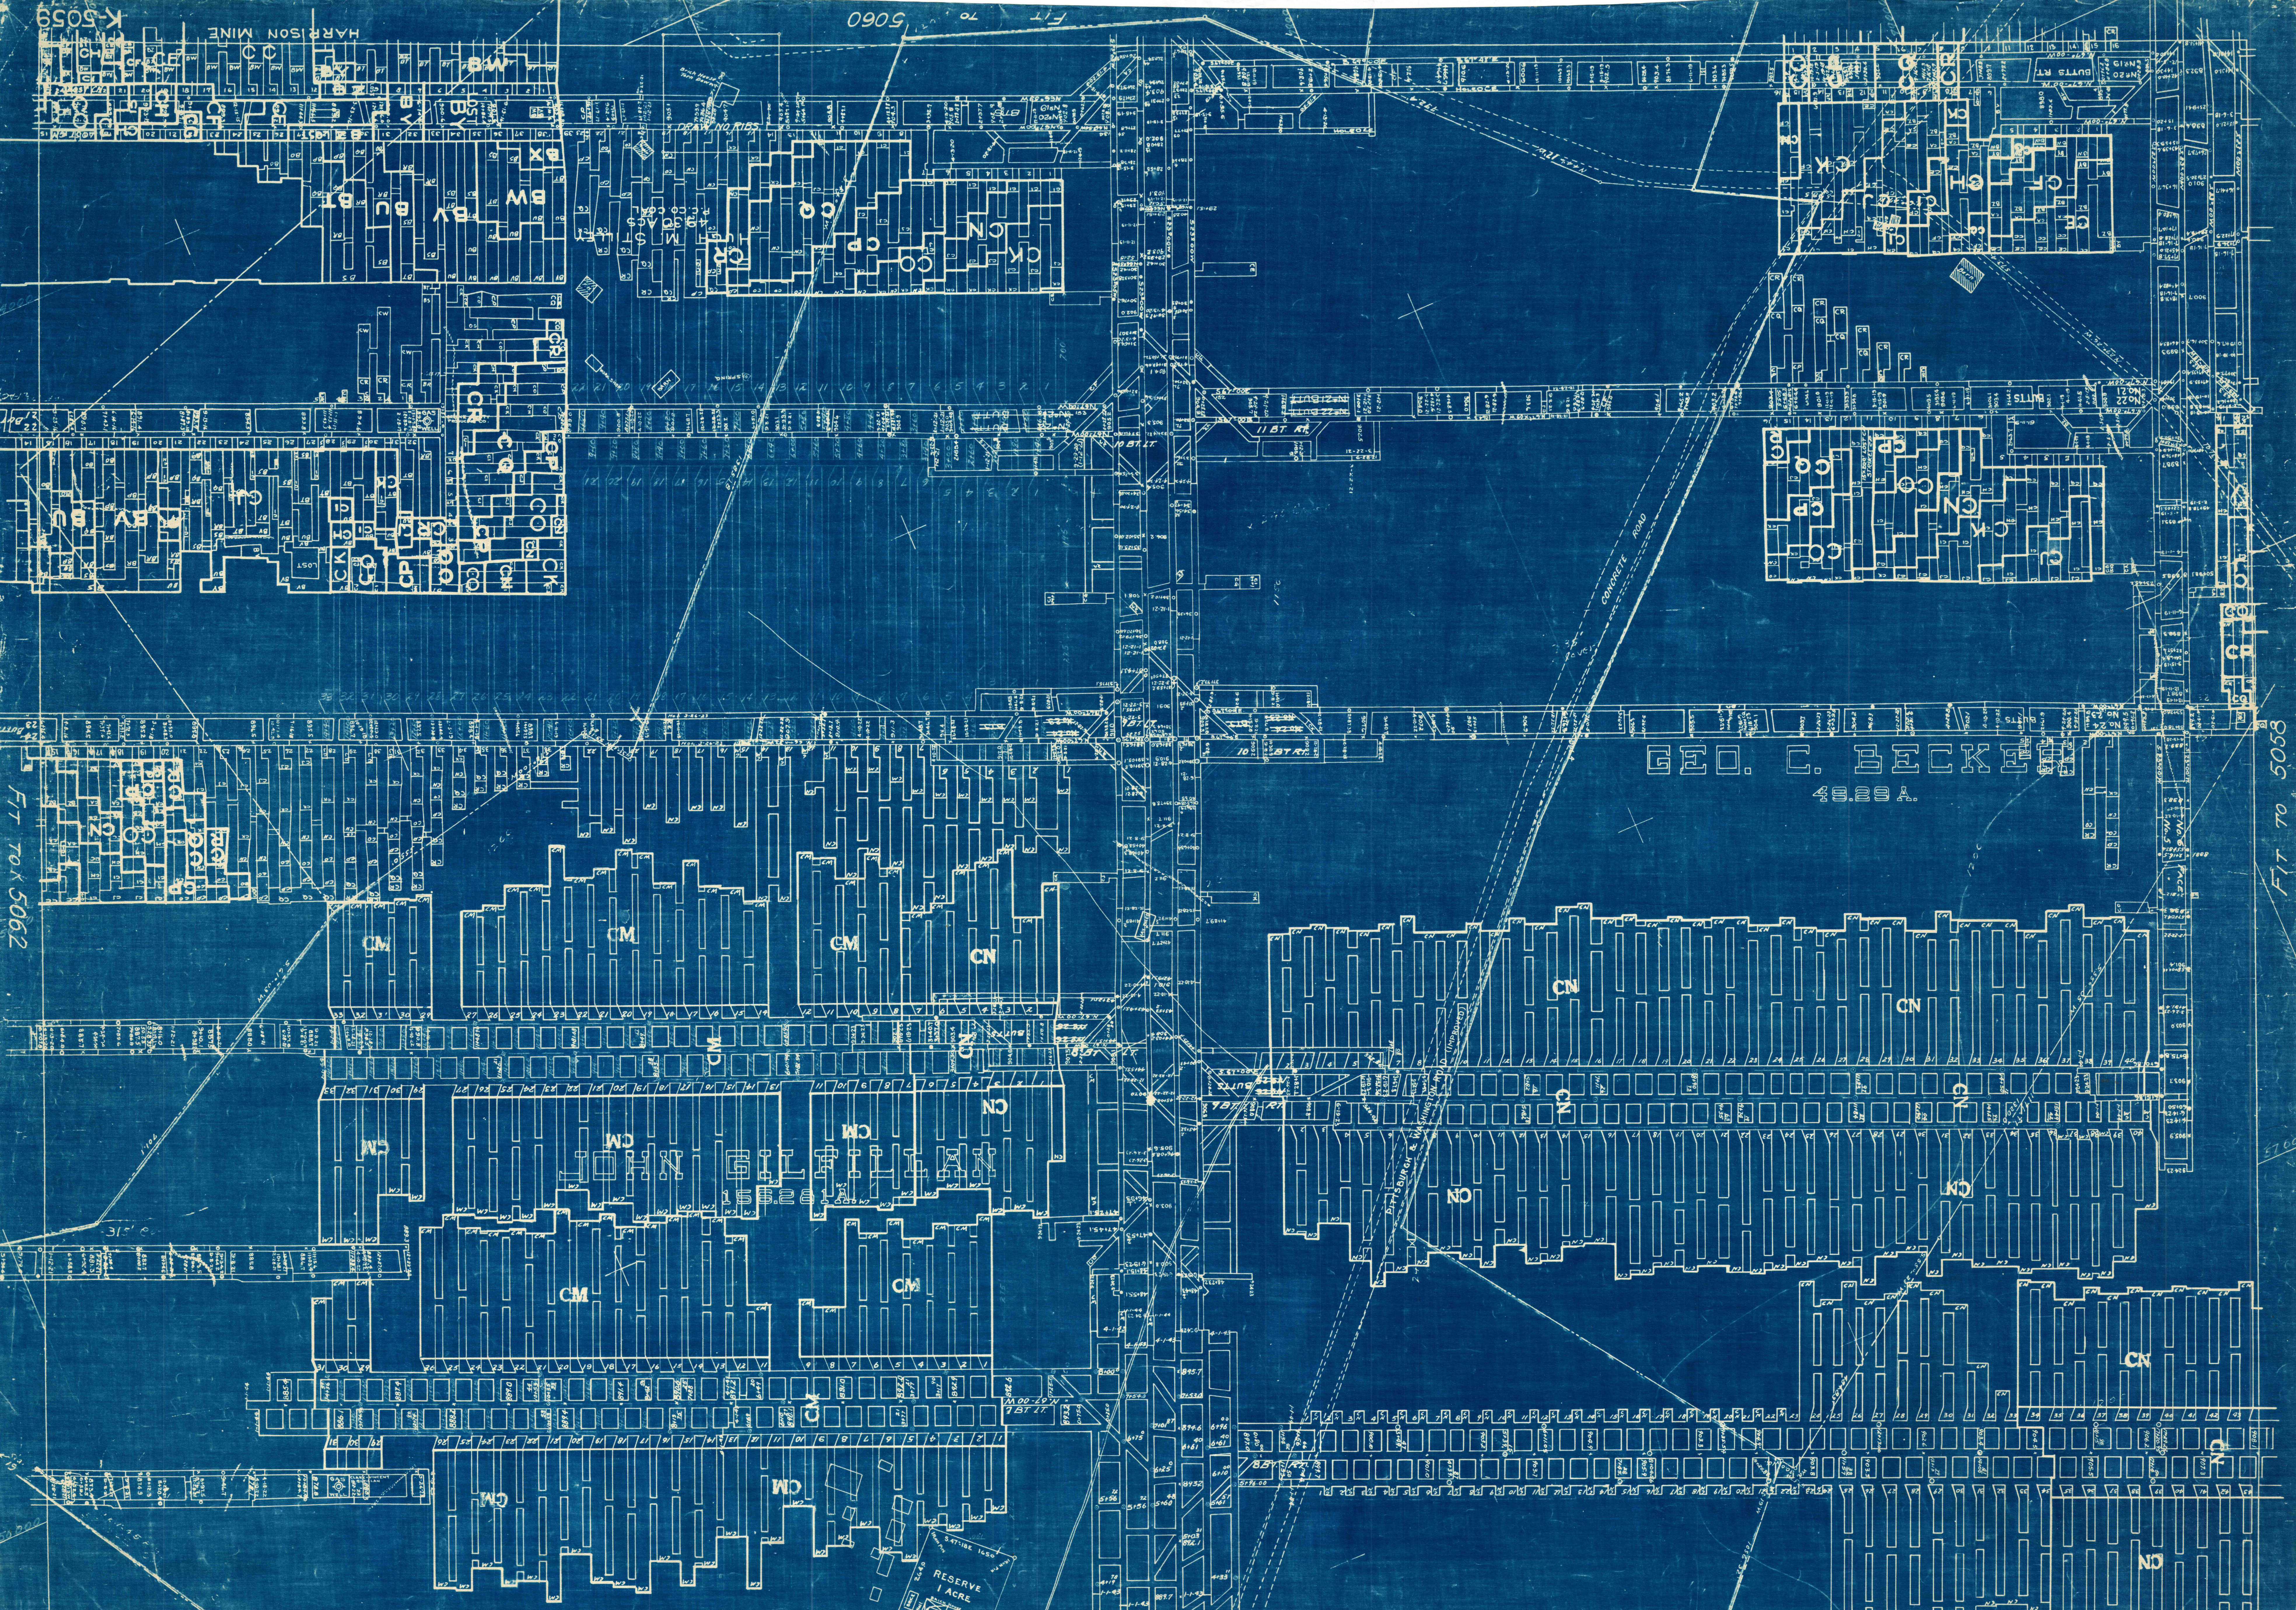

FT 70 X 5062

GEO. C. BECKETT

FT 70 5058

5760

FT TO K-5191

HARRISON MINE

K-5059