

HARRISON MINE K 5192

FIT TO K-5207

AMELIA MORAKE
S 28 A.



OFFICE

COVERDALE OR NO. 8 MINE
P.T.C. CORP.

ALEX GILFILLAN
S 24.000 A.

MINED OUT

BOUNDARY LINE

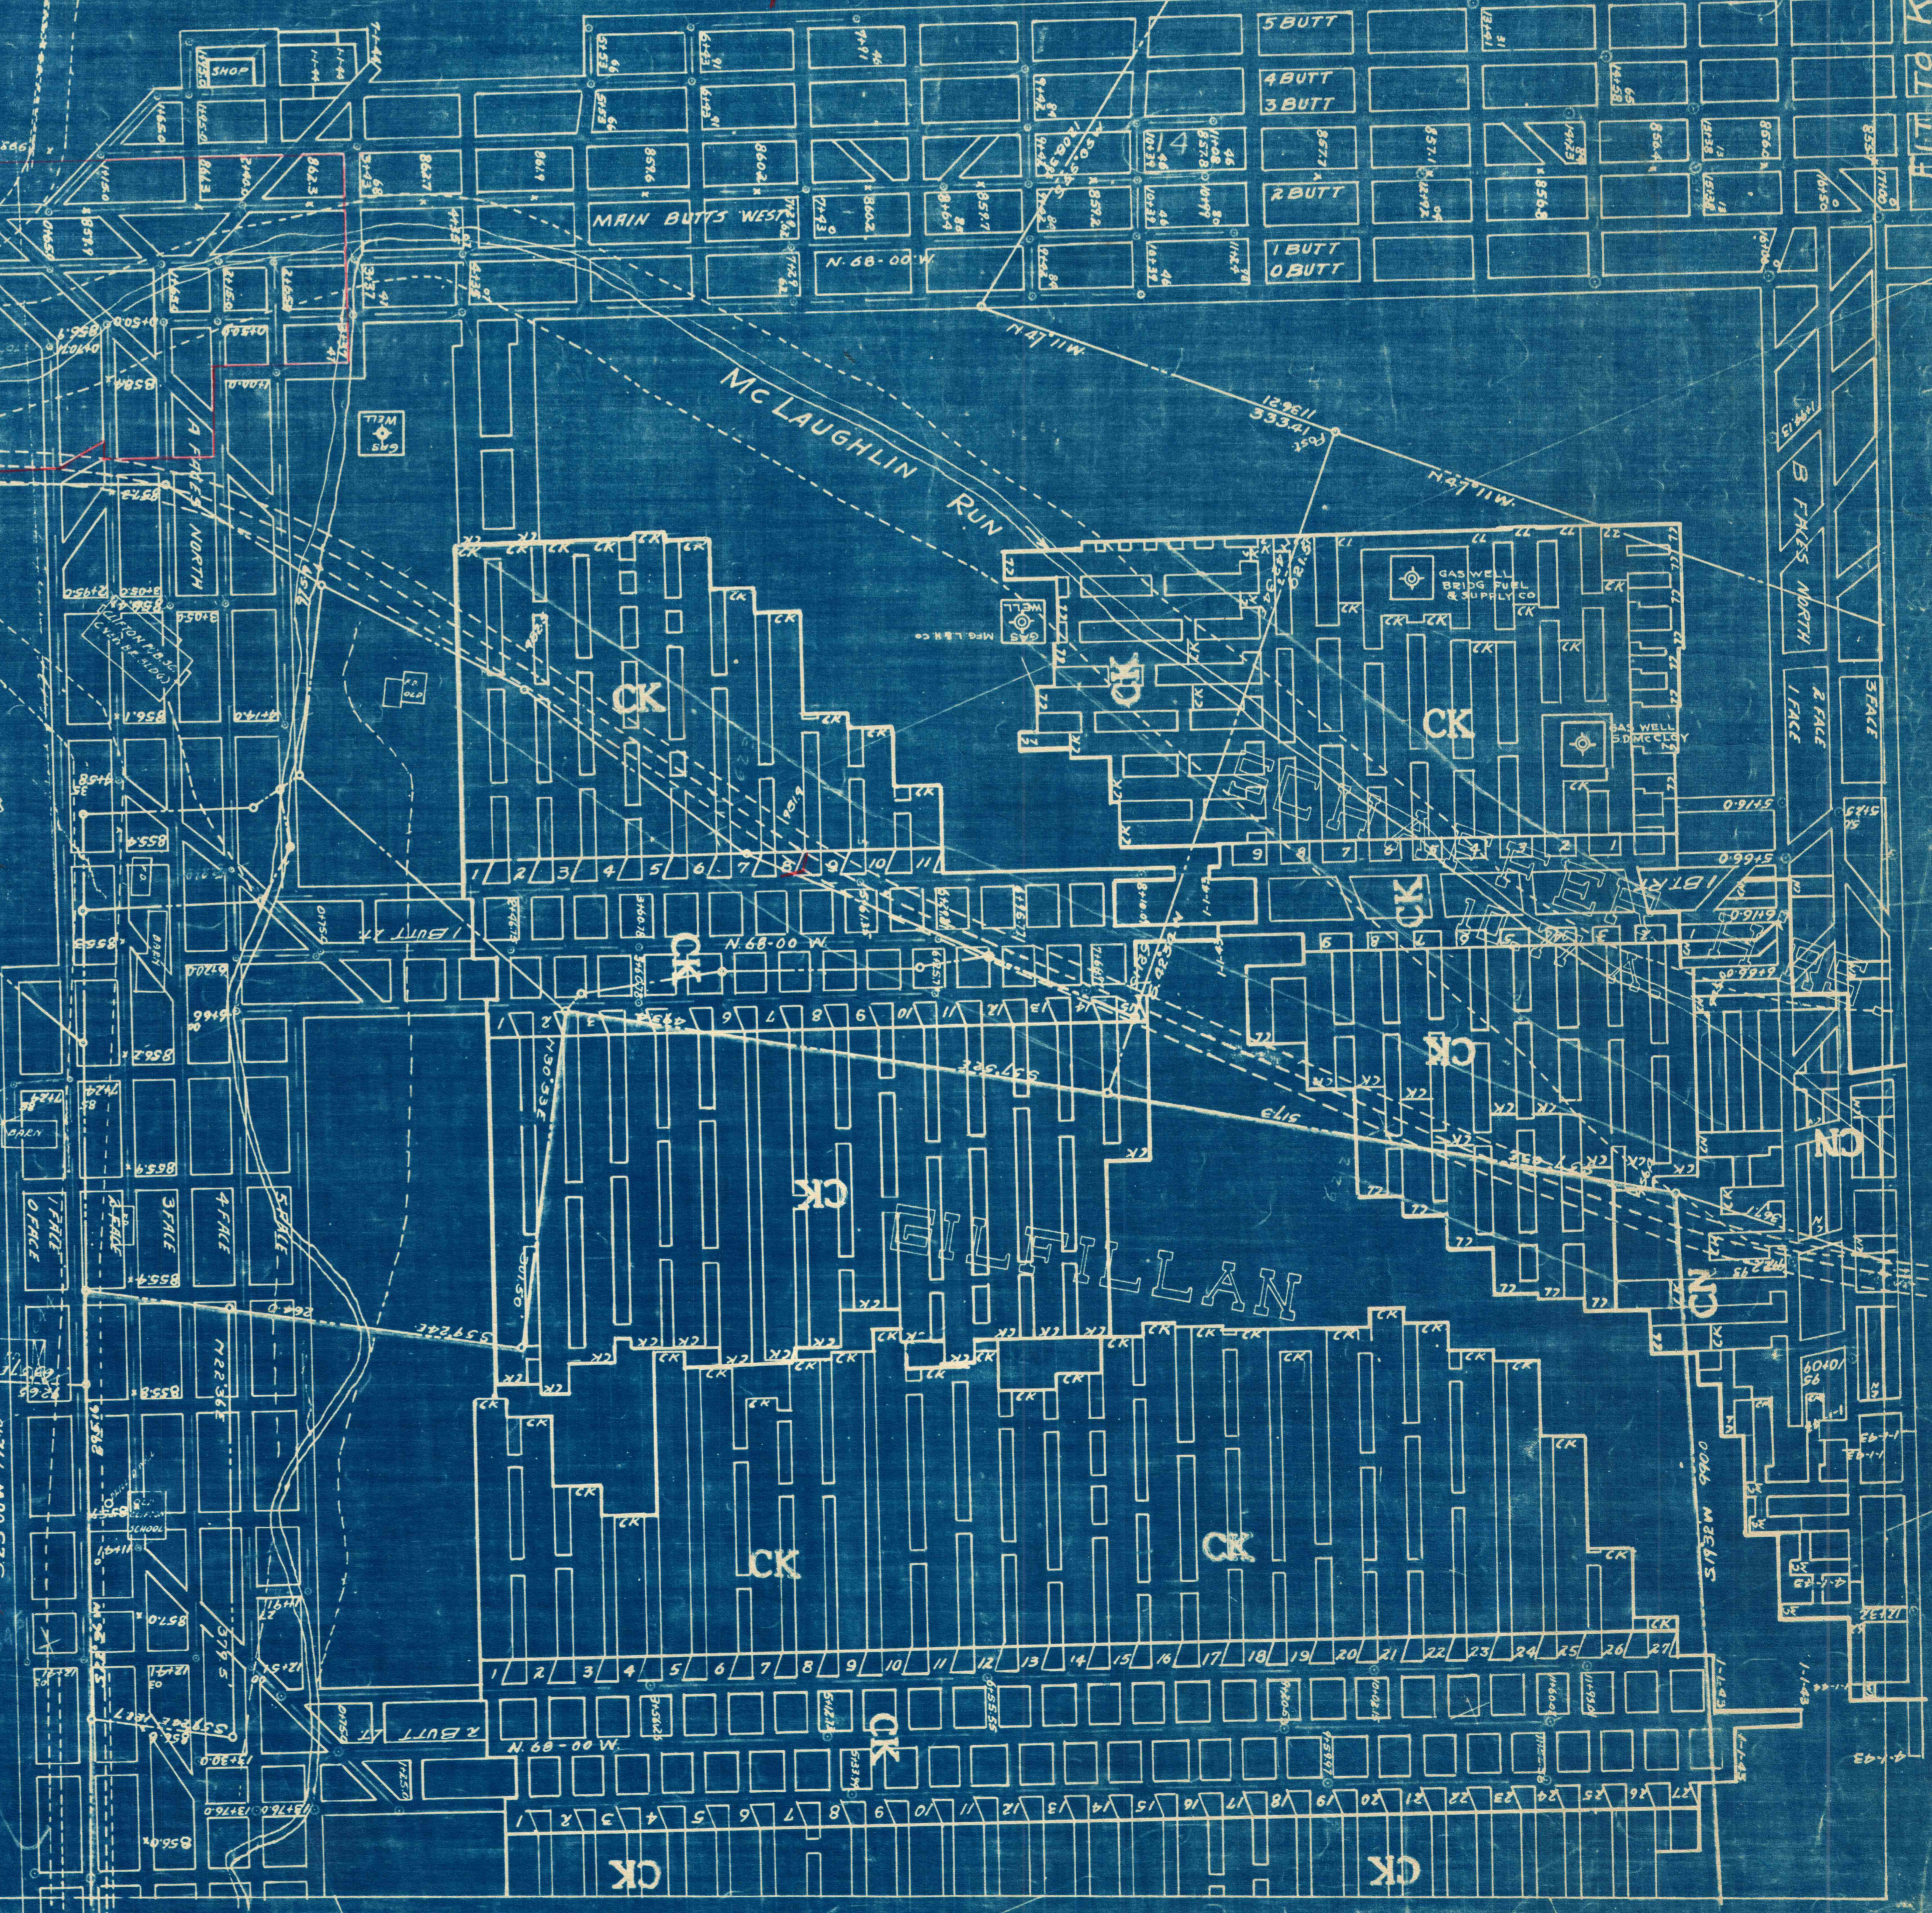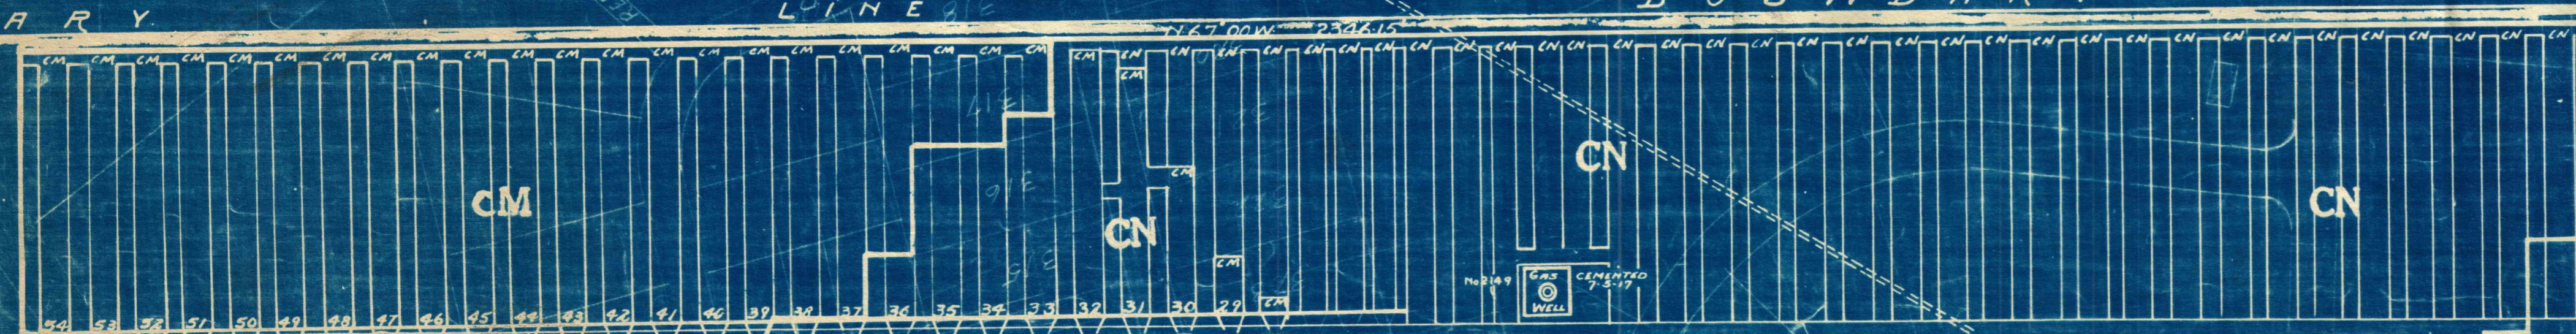

FIT TO K 5191

HARRISON MINE

K 5192
AA-14-10