


HARRISON MINE
ESSEN No 1 MINE
K-5061

FIT TO 5062

SAMUEL CONNER
38A BIP (includes part sold)

MINED OUT

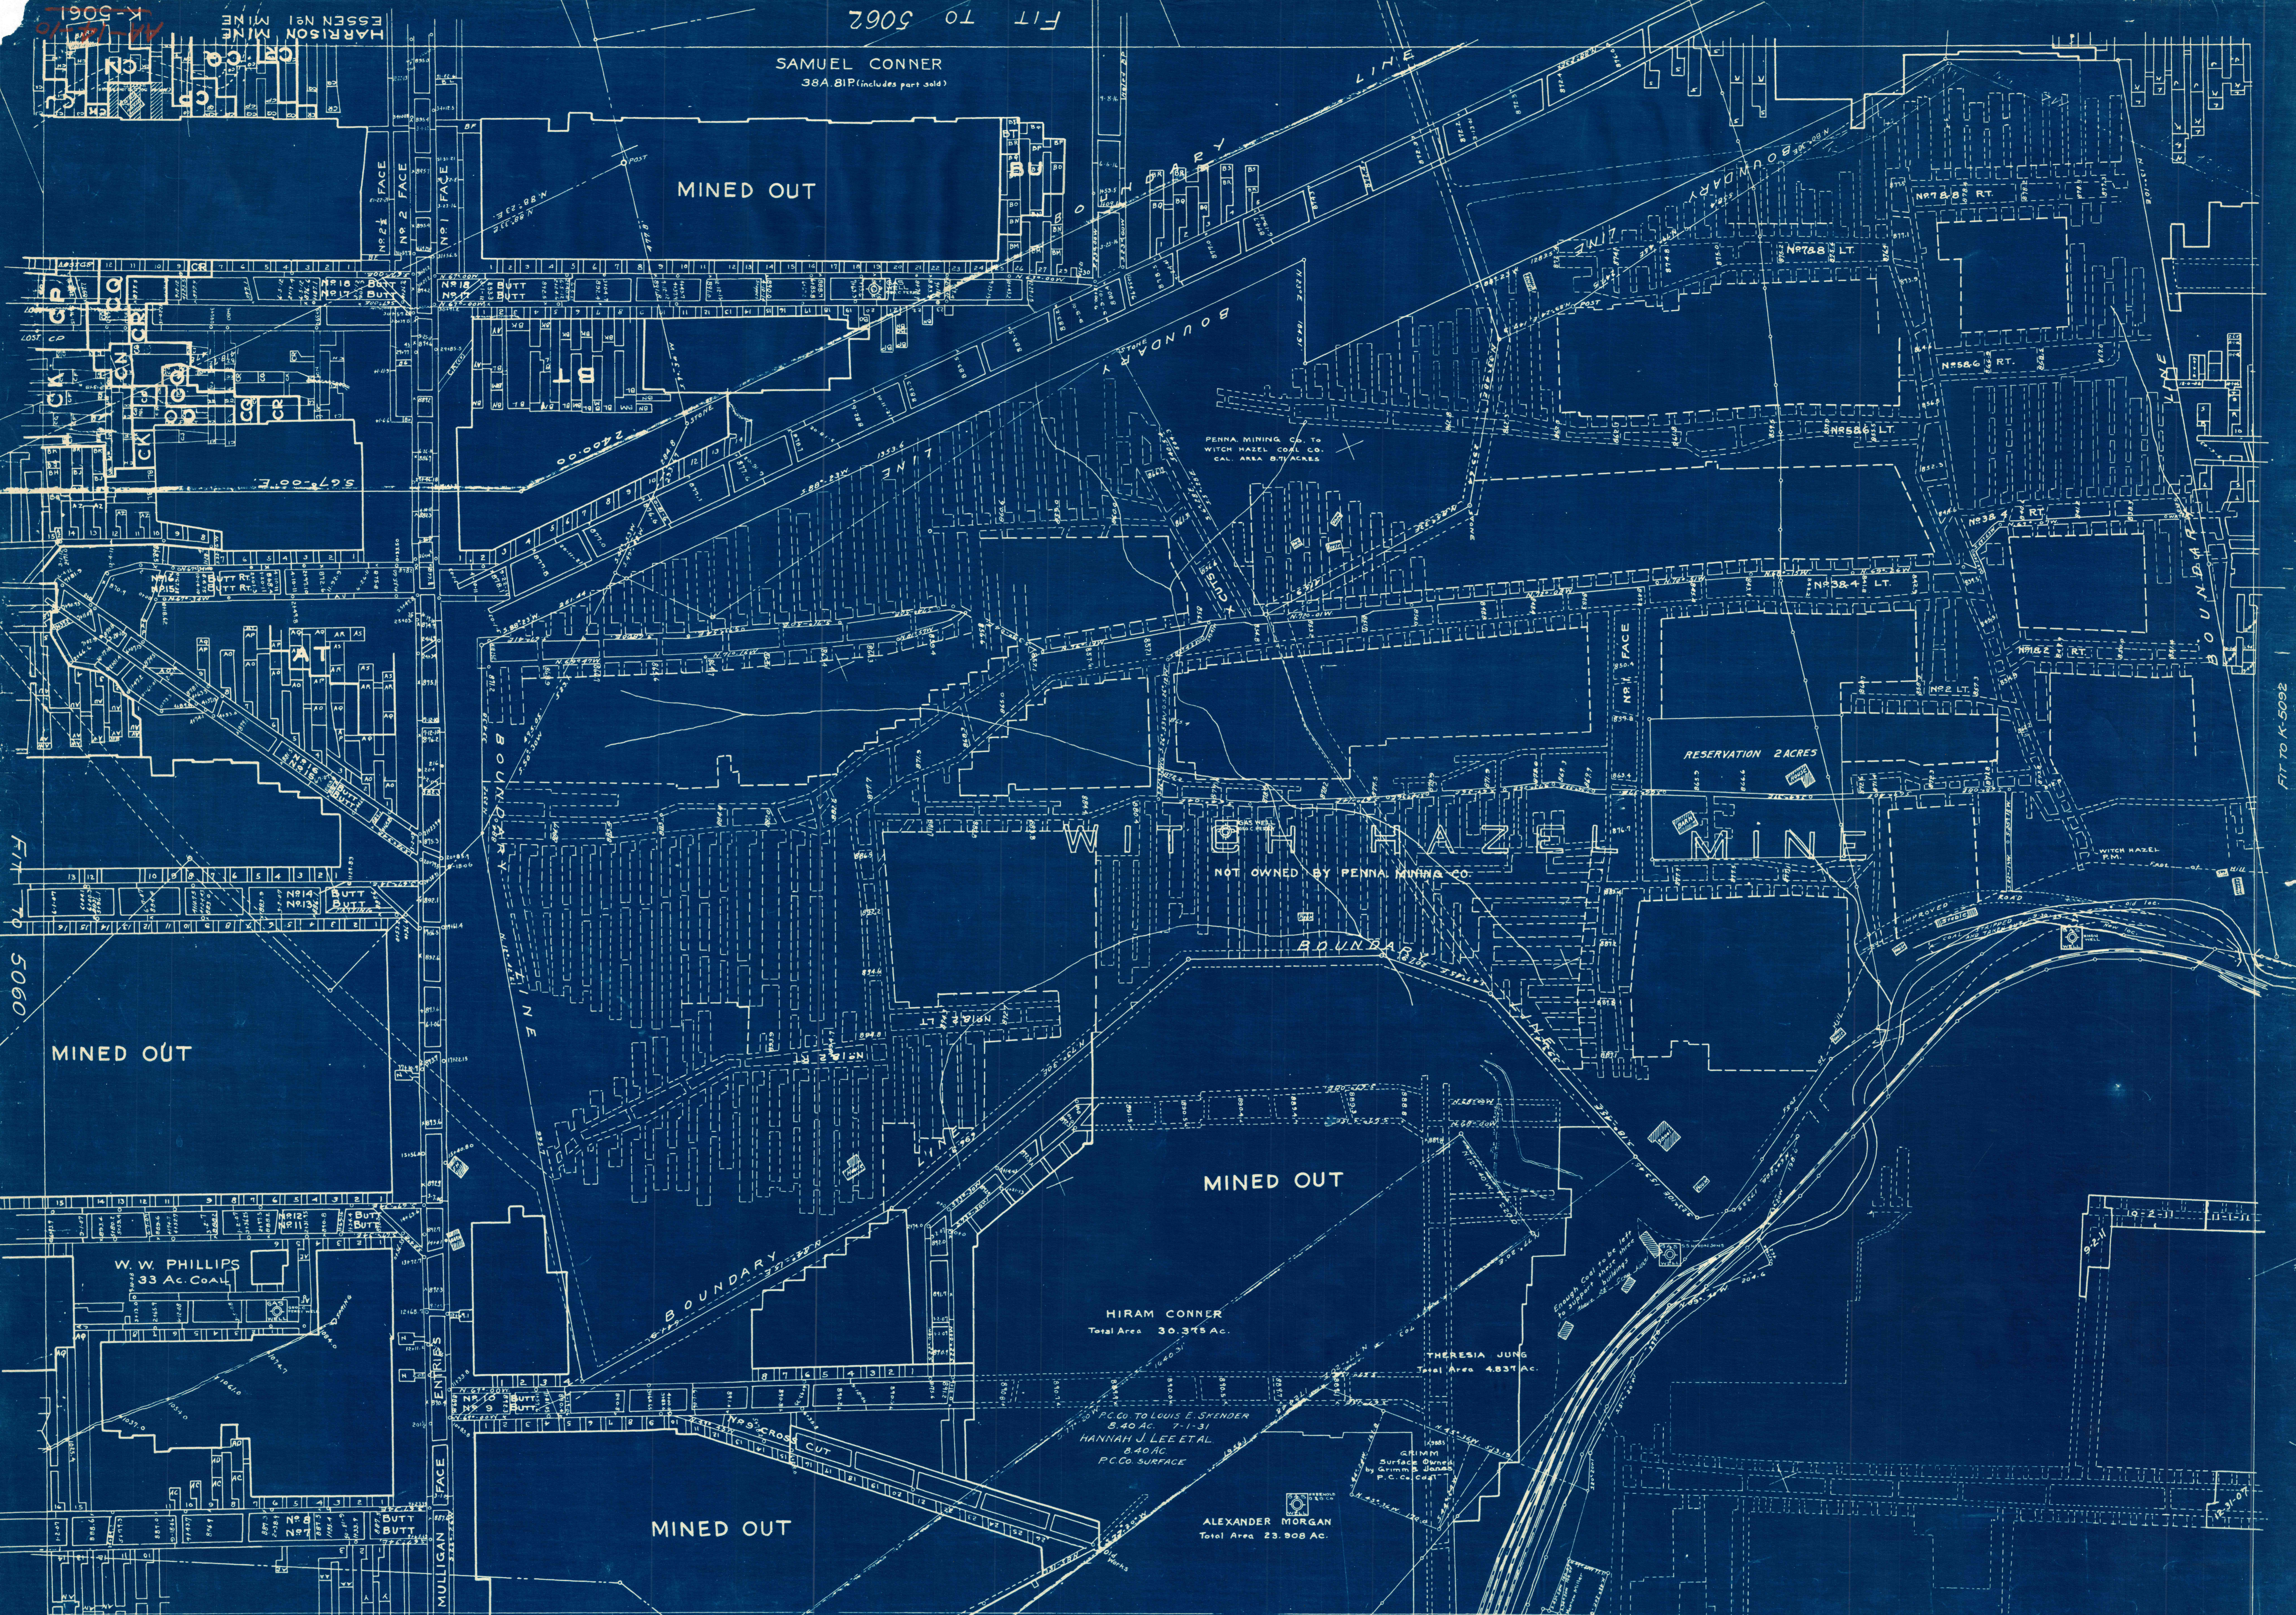

FIT TO 5060

MINED OUT

W. W. PHILLIPS
33 AC. COAL

HIRAM CONNER
Total Area 30.375 Ac.

THERESIA JUNG
Total Area 4.837 Ac.

P.C. Co TO LOUIS E. SHENDER
8.40 AC. 7-1-31
HANNAH J. LEE ET AL.
8.40 AC.
P.C. Co SURFACE

ALEXANDER MORGAN
Total Area 23.908 Ac.

MINED OUT

FIT TO K-5080

HARRISON MINE
ESSEN No 1 MINE
K-5061

FIT TO K-5092