


PLAN OF  
HORNER'S NO. 3 MINE  
SITUATED IN  
FORWARD TWP. ALLEGHENY CO. PA.  
C. M. CLAY & C.  
MAR. 1896  
SCALE 1/4"=100 FT.

*All 0-10-1 for working the*

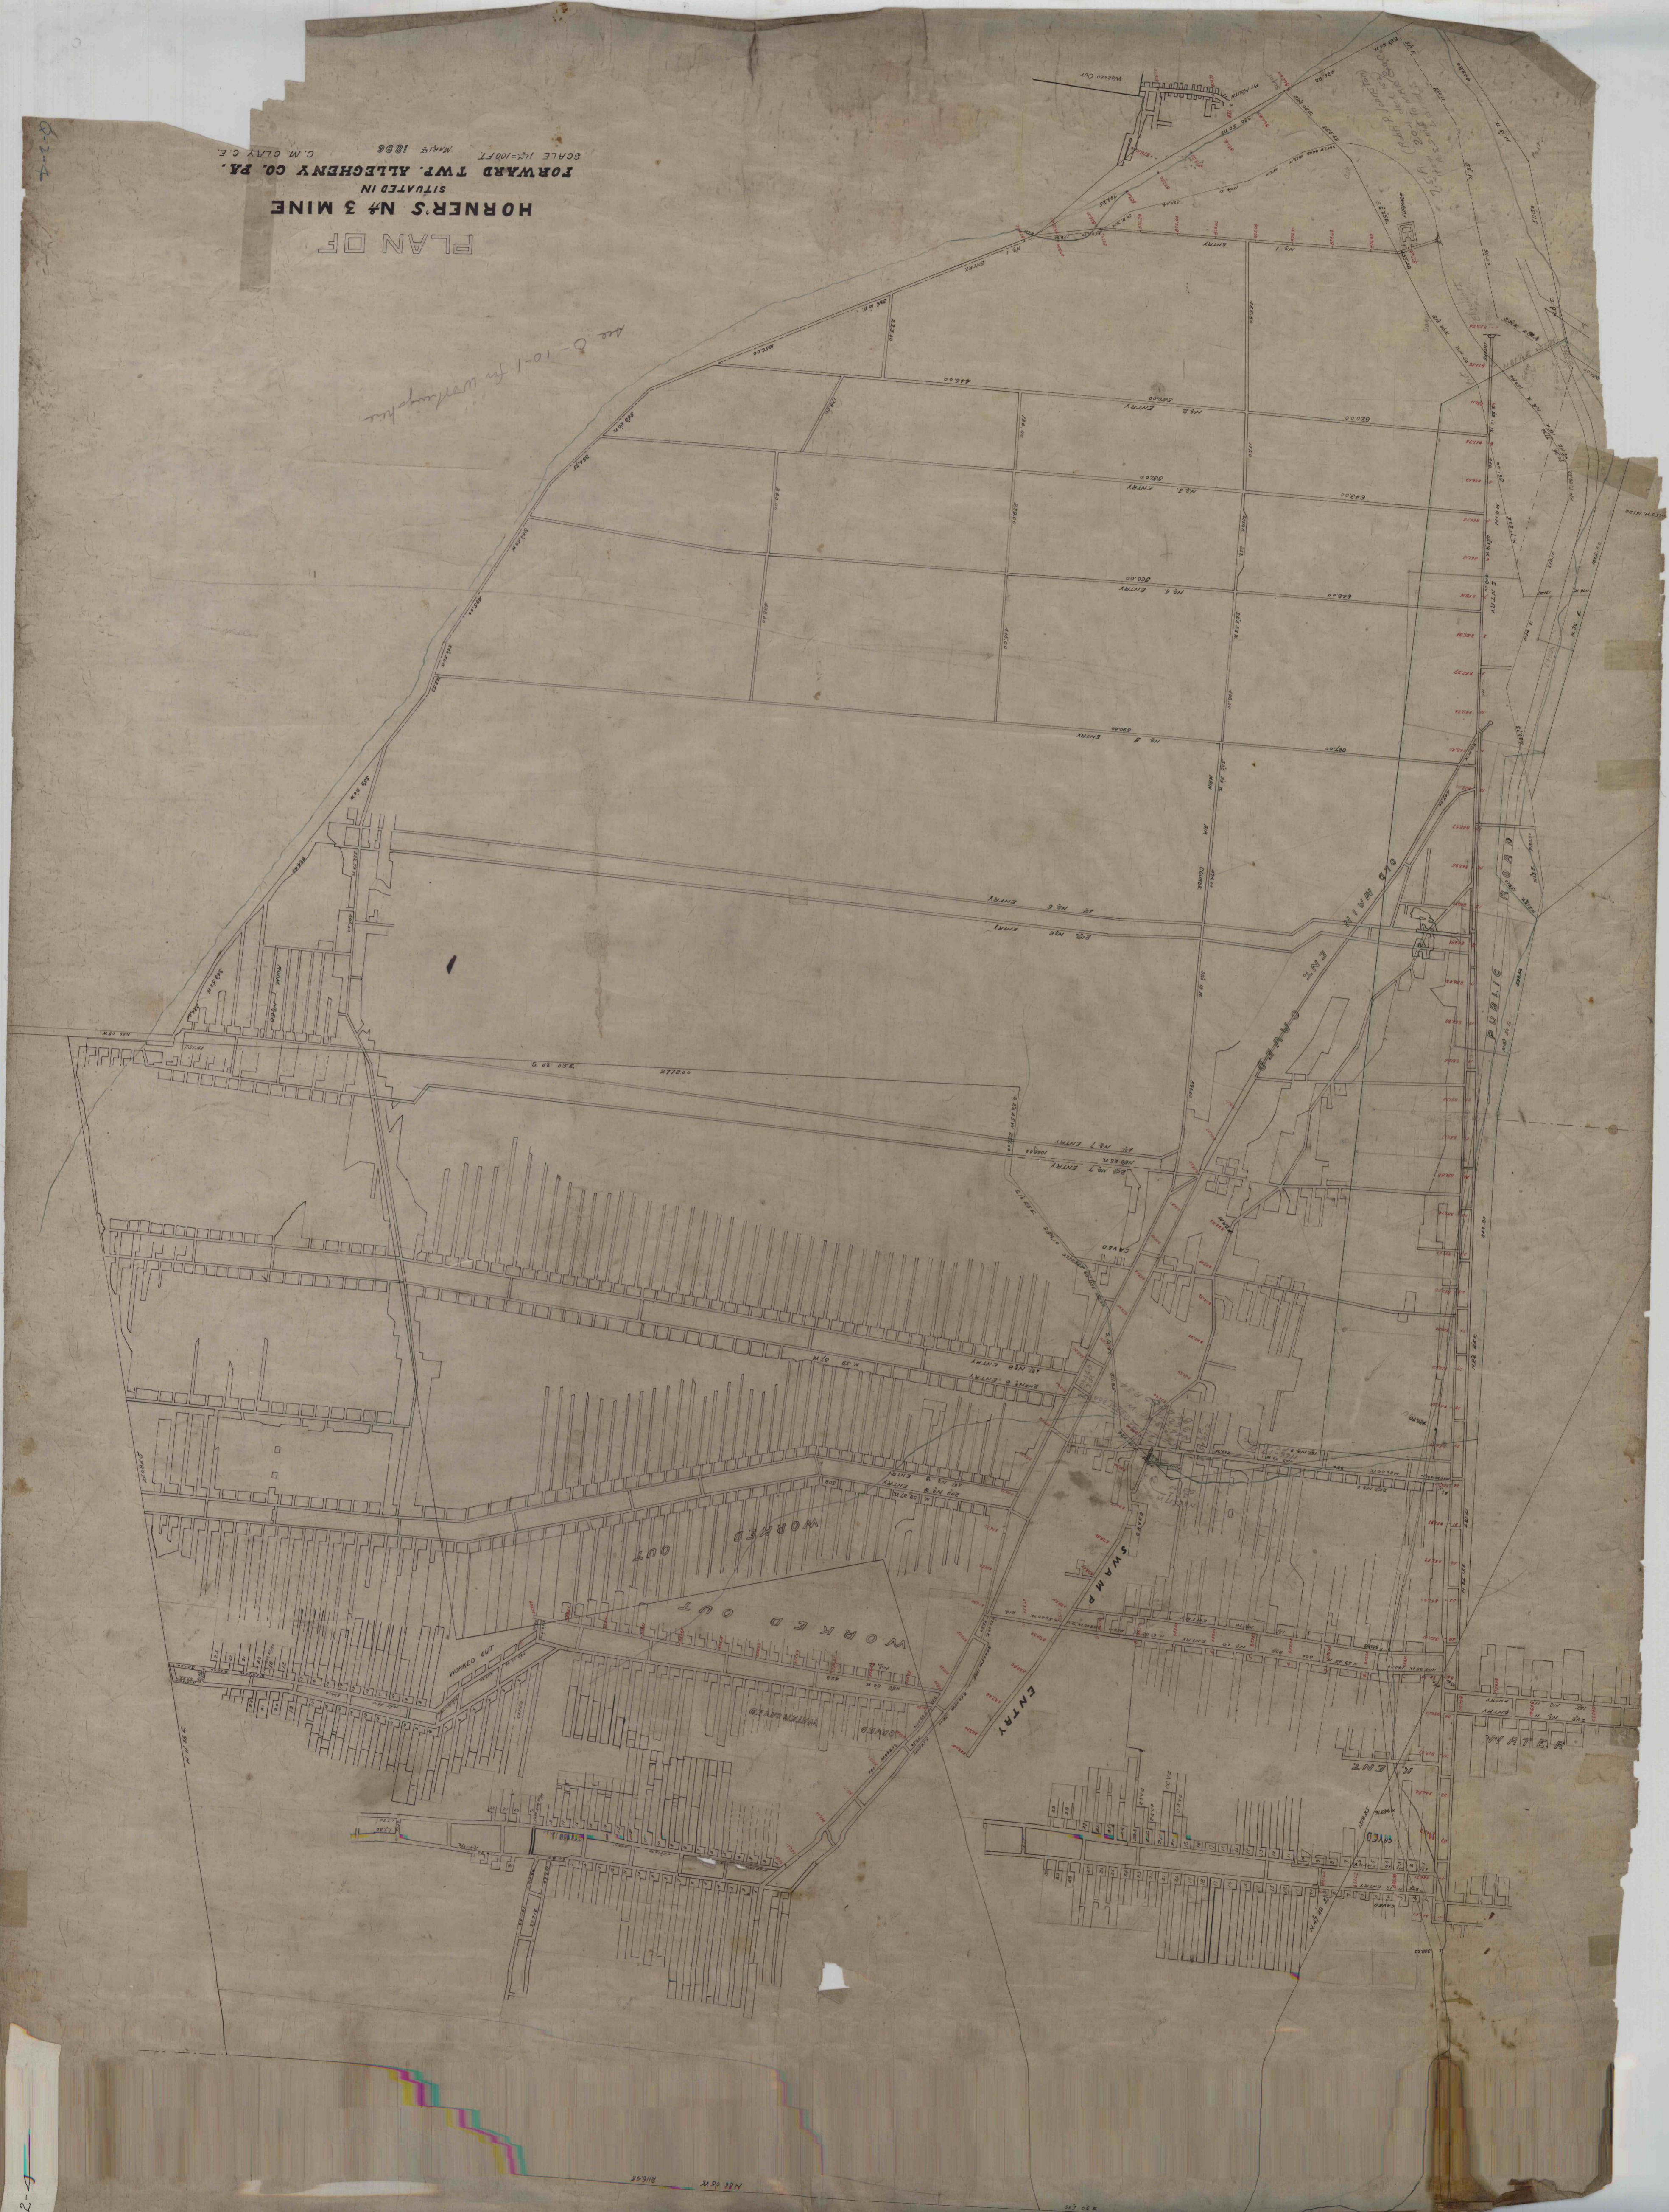

0-2-7

0-2-0

NEE 65 71  
BUC 24