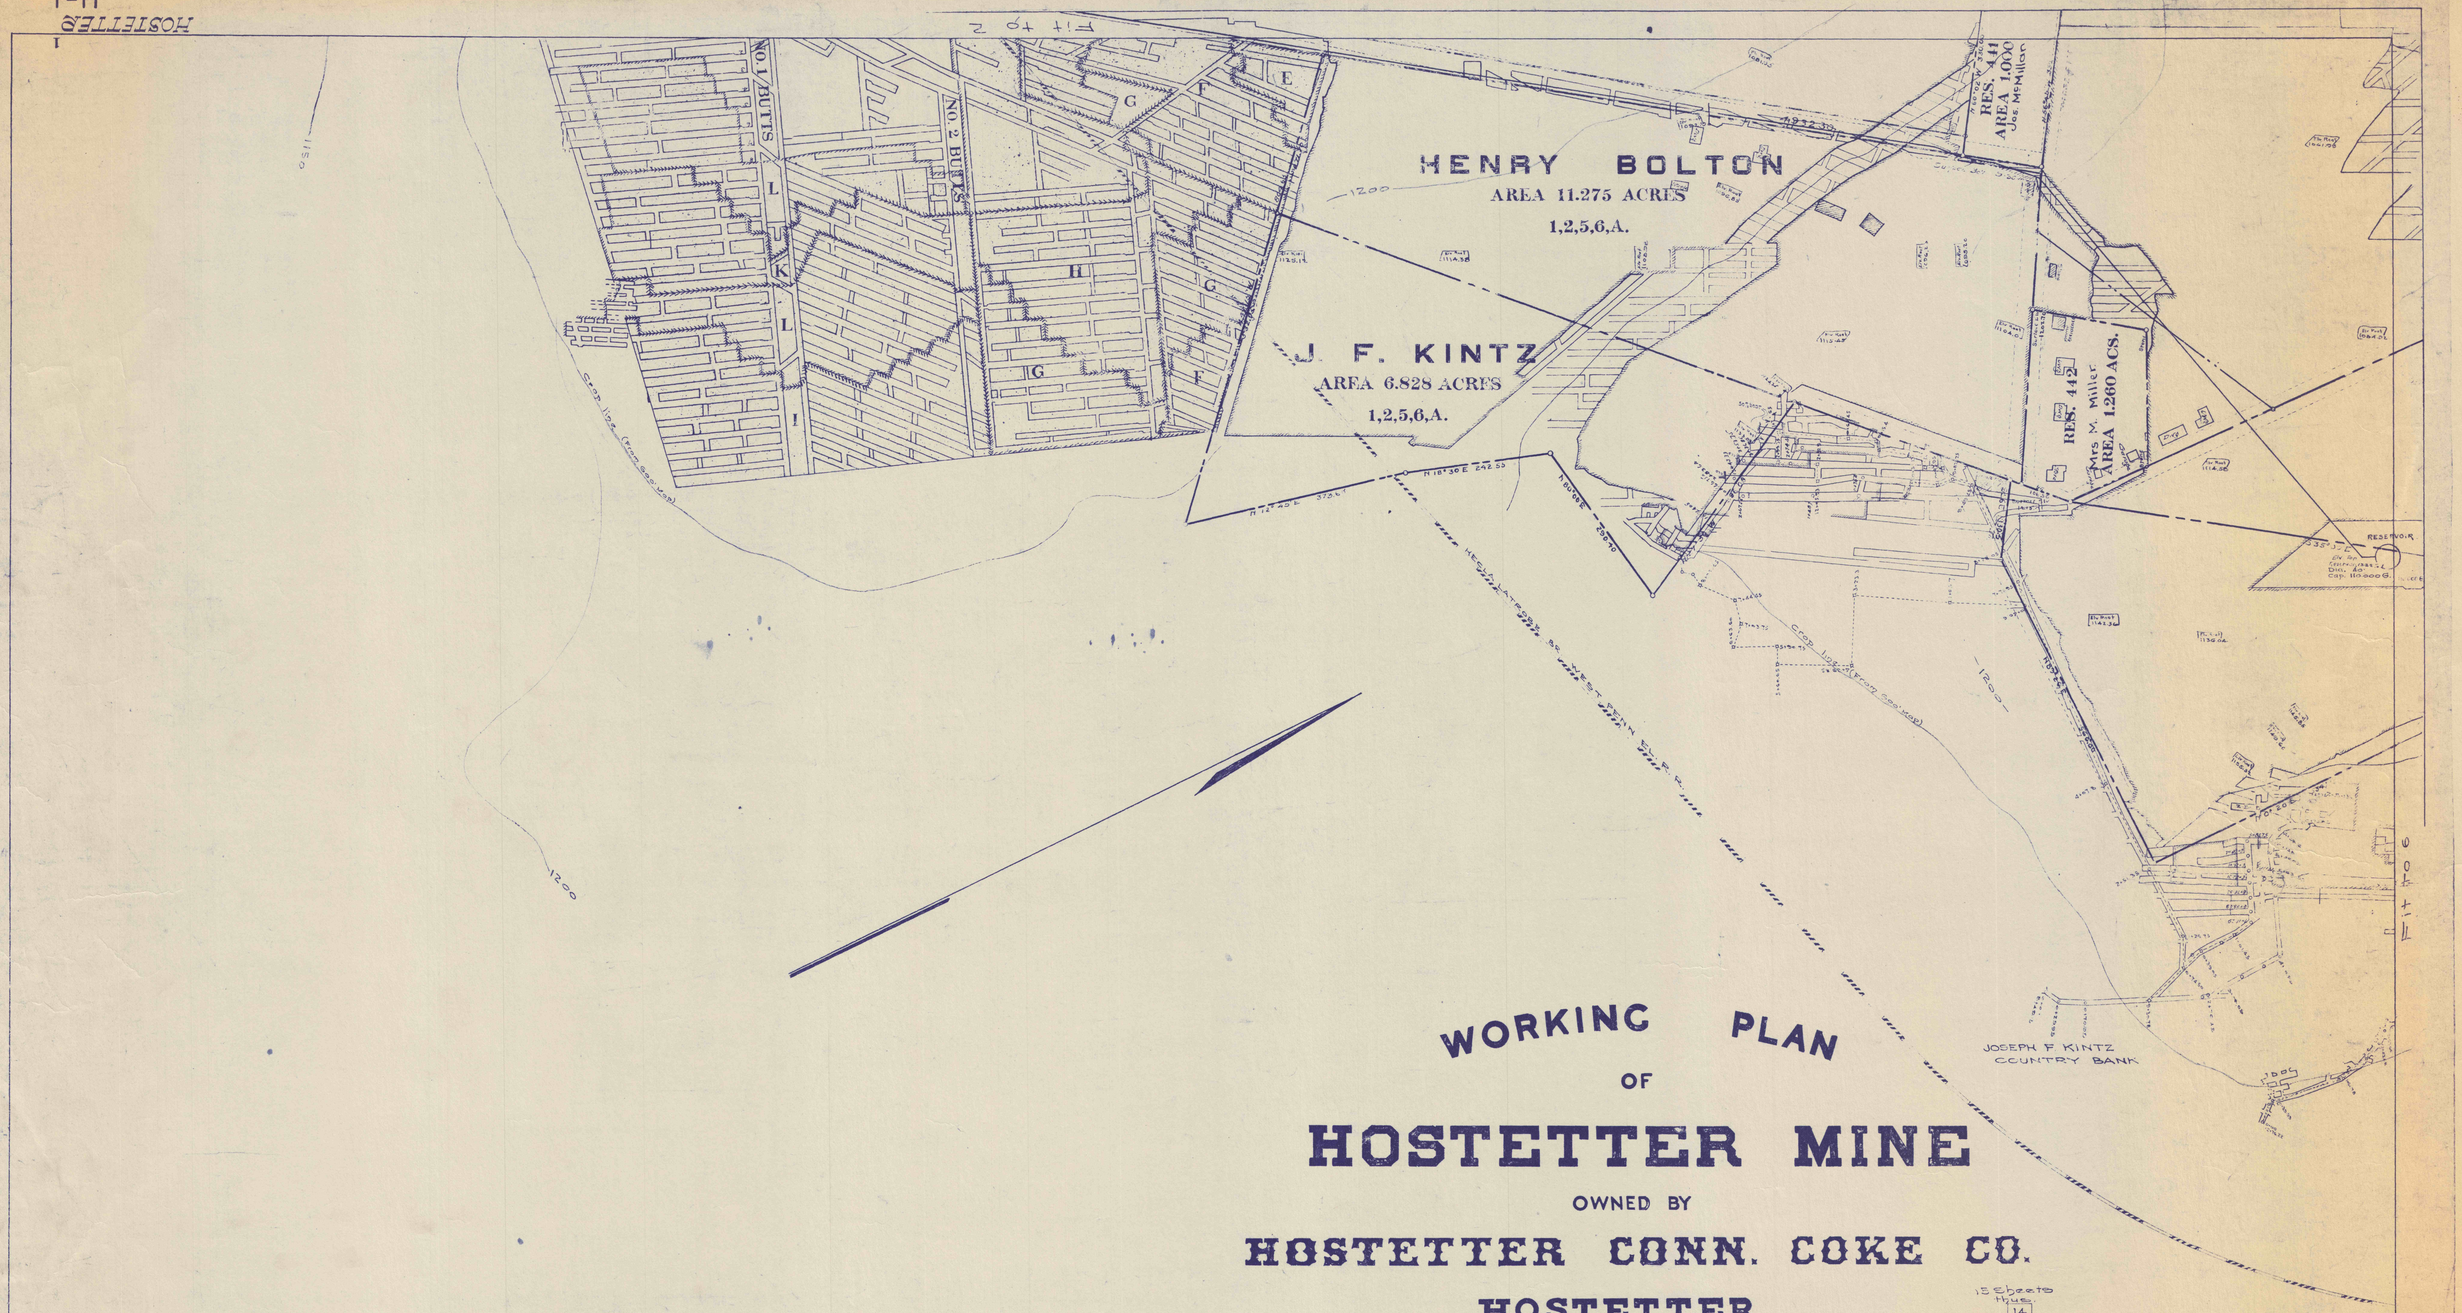

WORKING PLAN
OF
HOSTETTER MINE
OWNED BY
HOSTETTER CONN. COKE CO.
HOSTETTER
WEST MORELAND CO.
PA.

Scale – 100 ft. to 1 in. N.A. Barnhart Eng.

15 Sheets thus.

		14	
5	10	13	
4	9	12	15
3	8	11	
2	7		
Title 1	6		

DATE OF SURVEYS

June	5	1910	A	RCC	June	28	1916	V	WFS	Dec	16	1926	Q-1	FED
Sep	30	1910	B	RCC	Dec	27	1916	W	WFS	JUNE	28	1927	R-1	LRE
[illegible]	[illegible]	1911	[illegible]	[illegible]	June	27	1917	X	RCC	DEC	15	1927	S-1	FED
[illegible]	[illegible]	1911	[illegible]	[illegible]	Dec	[illegible]	1917	[illegible]	[illegible]	JUNE	19	1928	T-1	LRE
June	26	1911	E	[illegible]	June	27	1918	Z	LRE	DEC.	14	1928	U-1	LRE
Oct	17	1911	F	[illegible]	Dec	26	1918	A-1	WFS	JUNE	18	1929	V-1	LRE
Jan	2	1912	G	[illegible]	June	26	1919	B-1	RCC	DEC	20	1929	W-1	WFS
April	1	1912	H	[illegible]	Dec	26	1919	C-1	LRE	JUNE	20	1930	X-1	LRE
July	8	1912	I	[illegible]	June	28	1920	D-1	LRE	DEC.	16	1930	Y-1	LRE
Oct	11	1912	[illegible]	[illegible]	Dec	29	1920	E-1	LRE	SEPT	2	1931	Z-1	WFS
Jan	1	1913	K	[illegible]	June	28	1921	F-1	LRE					
April	1	1913	[illegible]	[illegible]	Dec	28	1921	G-1	LRE					
July	1	1913	M	[illegible]	June	28	1922	H-1	LRE					
Oct	1	1913	N	[illegible]	Dec	27	1922	I-1	LRE					
Jan	1	1914	O	WFS	June	28	1923	J-1	FED					
Mar	28	1914	P	[illegible]	Dec	27	1923	K-1	FED					
July		1914	Q	RCC	June	27	1924	L-1	LRE					
Oct	8	1914	R	RCC	Dec	27	1924	M-1	LRE					
Dec	31	1914	S	[illegible]	June	30	1925	N-1	LRE					
June	28	1915	T	[illegible]	Dec	29	1925	O-1	LRE					
Dec	30	1915	[illegible]	[illegible]	June	29	1926	P-1	LRE					

HOSTETTER 1
H-1