


H-11
HOSTETTER

FIT TO 12

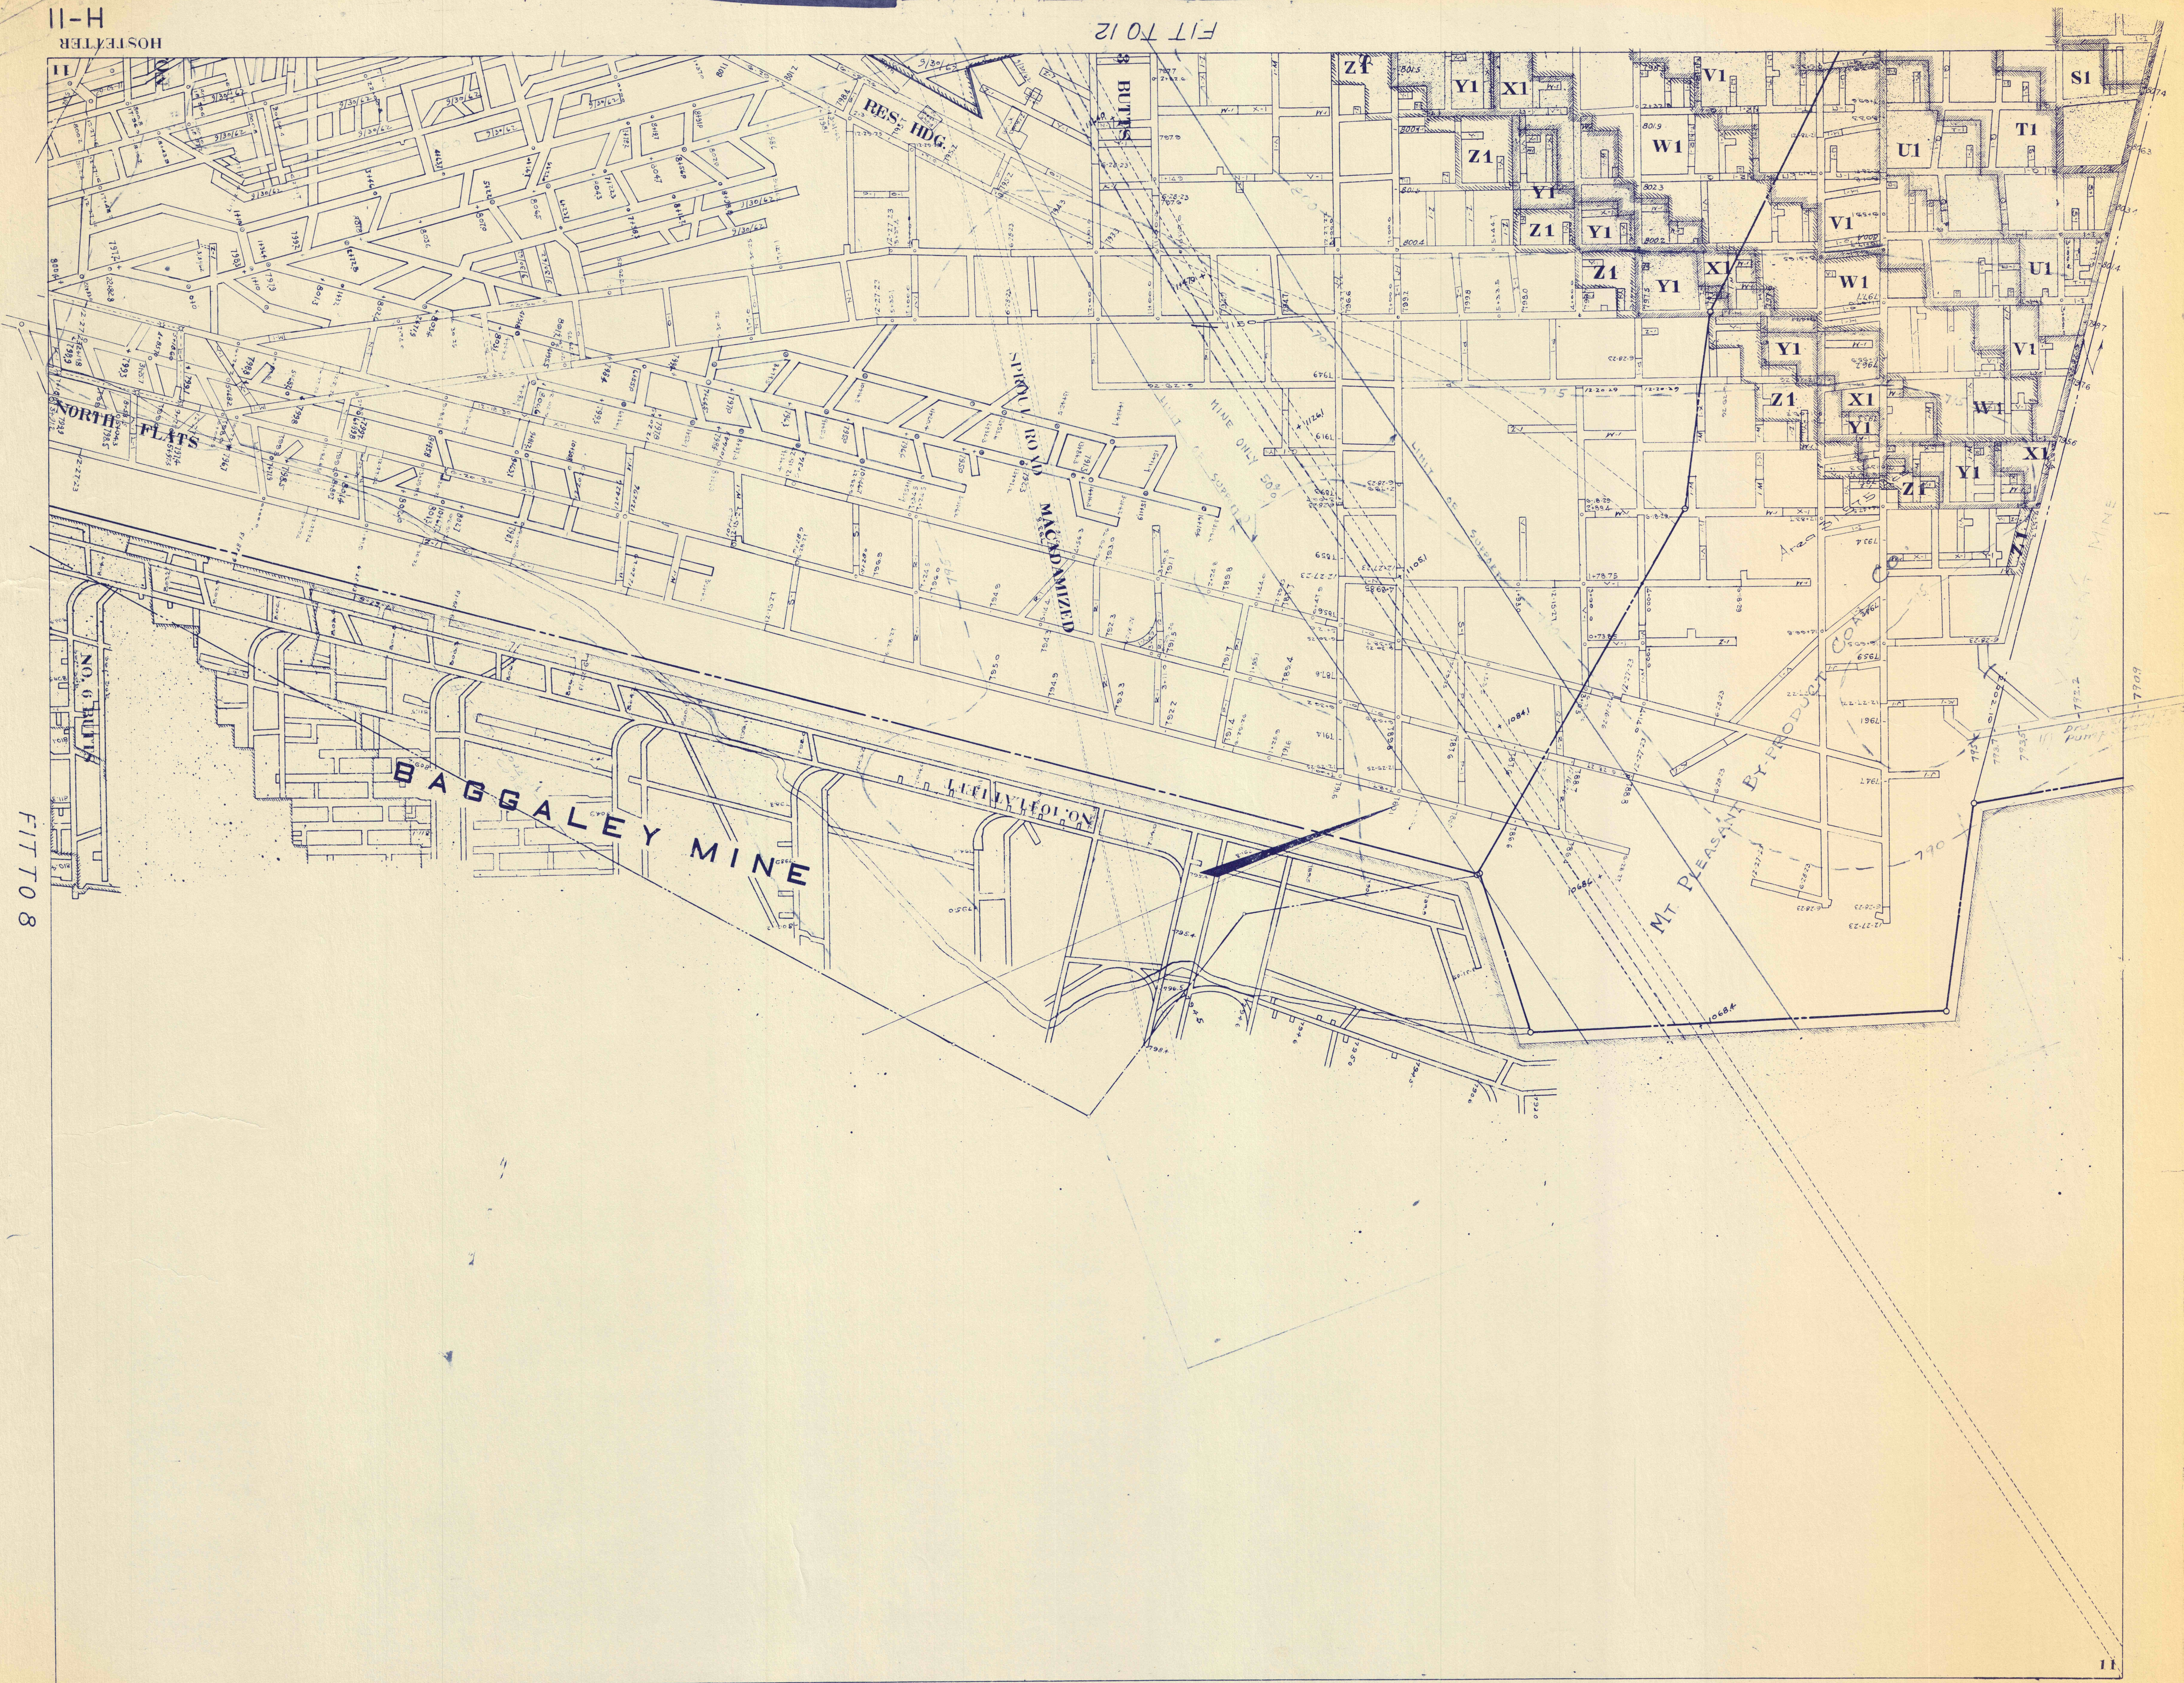

FIT TO 8

H-11
HOSTETTER