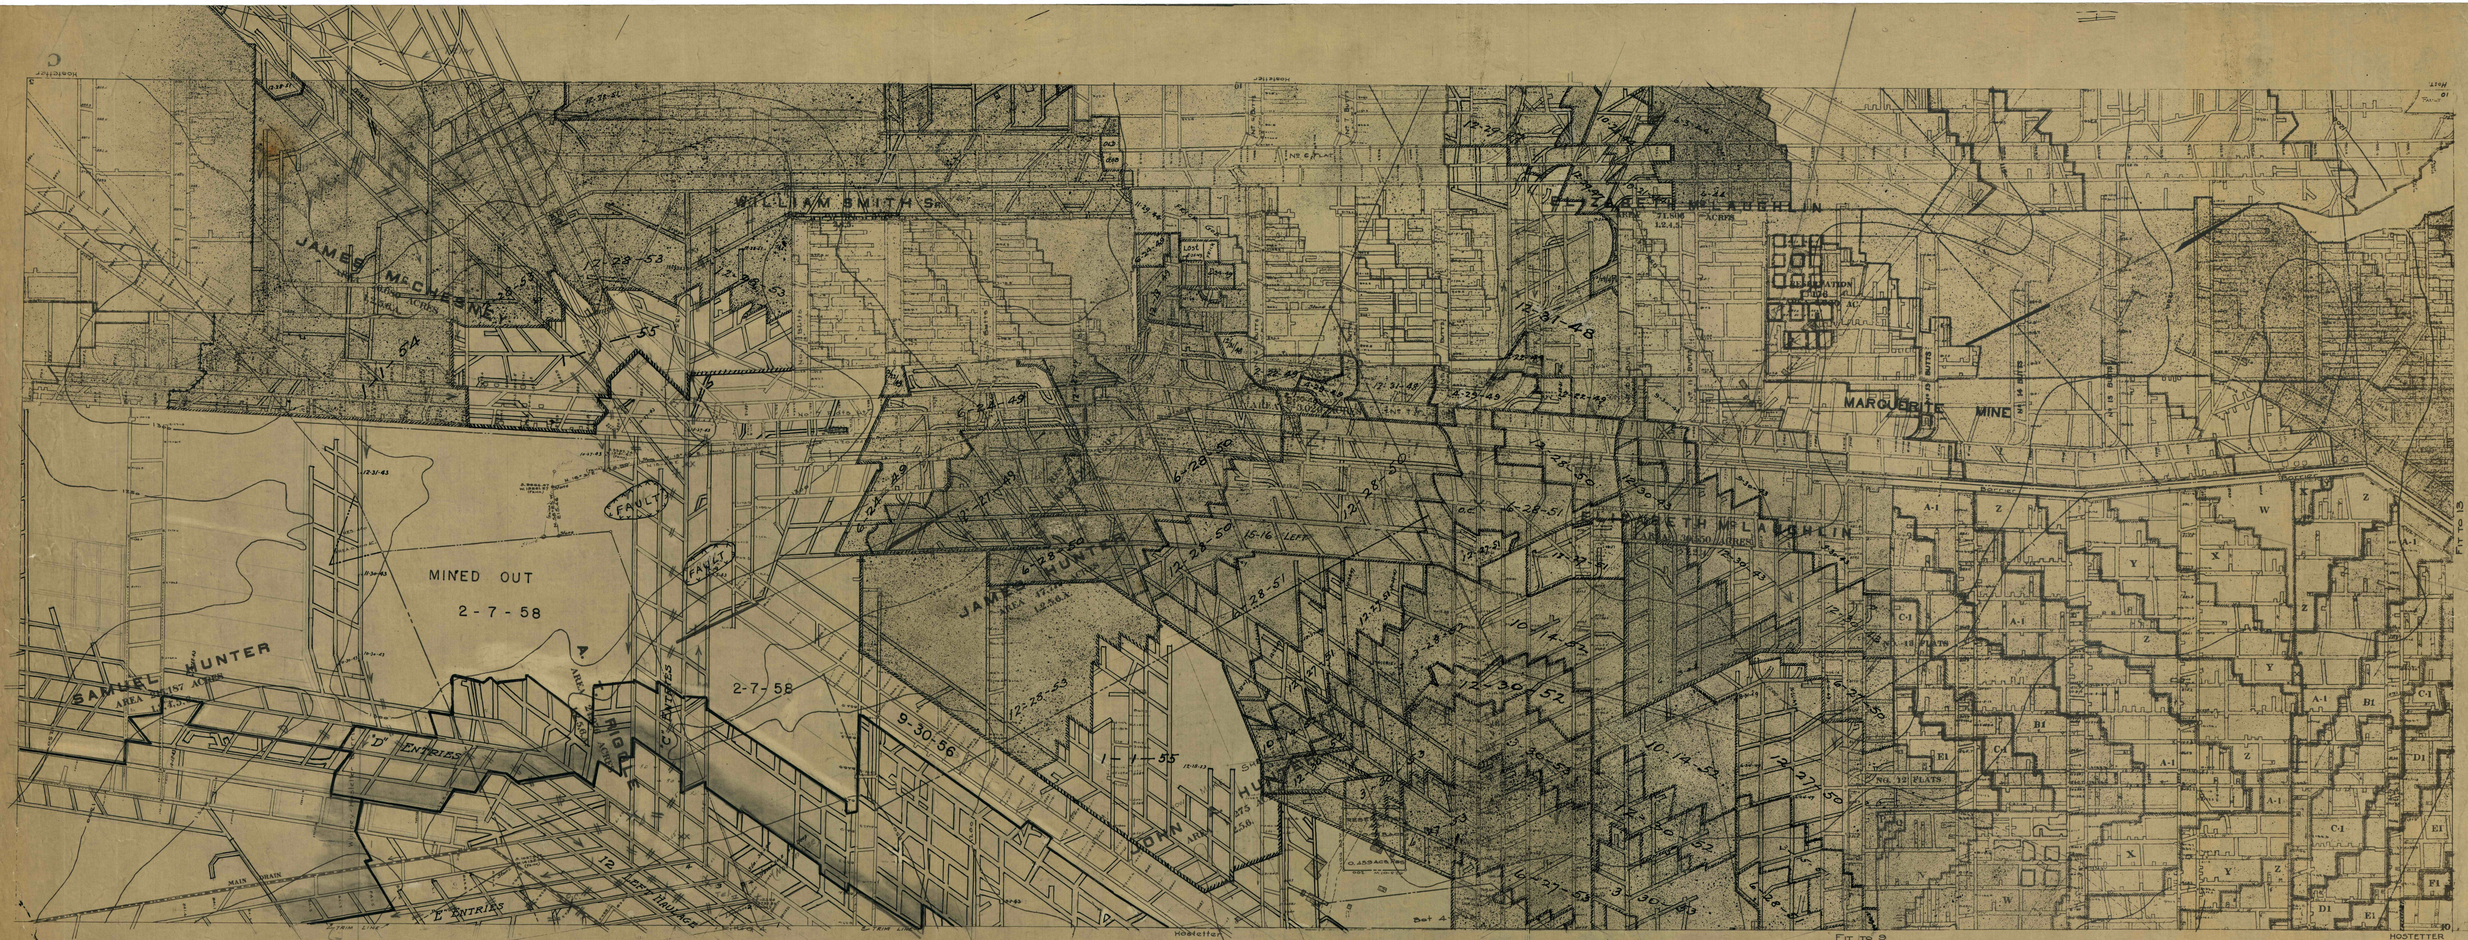
WILLIAM SMITH Sr.
JAMES McCREERY
ELIZABETH McLAUGHLIN
MARQUETTE MINE
MINED OUT
2-7-58
SAMUEL HUNTER
JAMES HUNTER
JOHN
"D" ENTRIES
"E" ENTRIES
12 LEFT PANHANDLE
FAULT
FAULT
FAULT
9-30-56
1-1-55
2-7-58
12-28-53
12-31-48
6-28-50
6-28-51
12-30-52
10-14-53
12-27-53
12-31-43
12-31-54
12-31-49
12-28-55
12-25-53
12-31-53
12-31-45
12-31-43
12-31-43
12-31-43