


Top of Fdn #1 Pump
 606.46
 Floor New Pump Ho
 604.74
 $1.72 = 1' - 8\frac{7}{8}" = 20\frac{7}{8}"$

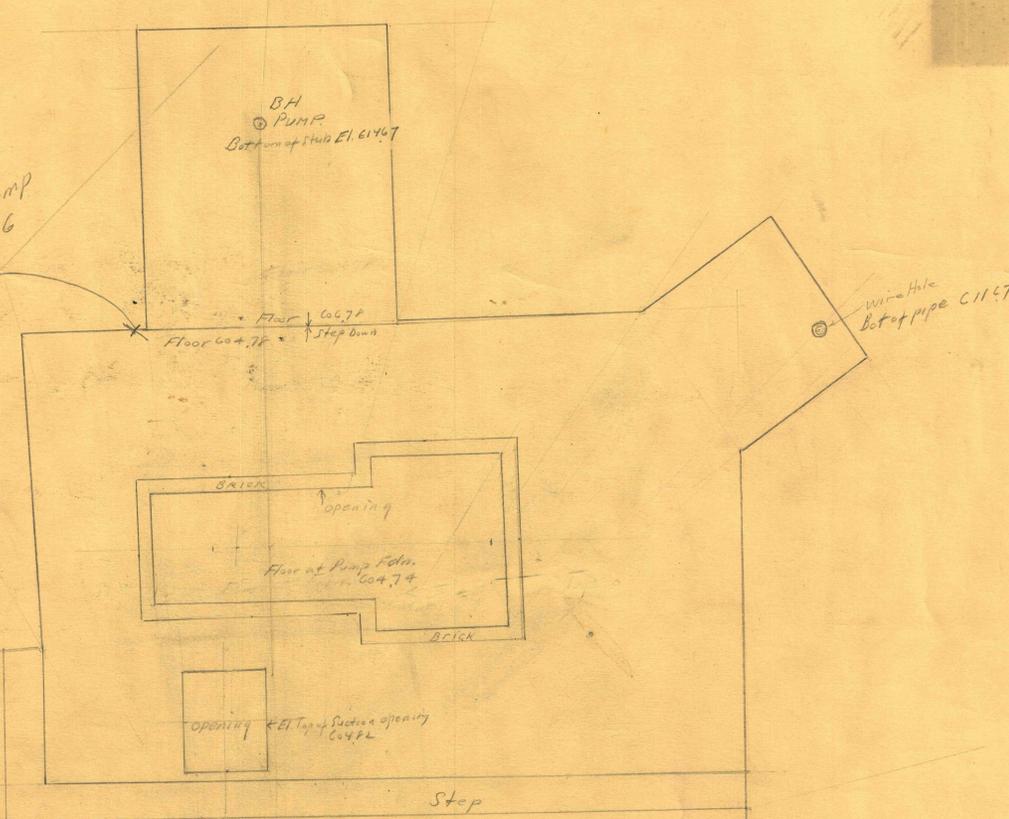

Pump foundation 24" above floor
 if Bed plate is same height
 as #1 pump

NEW PUMP ROOM HUTCHINSON MINE
 FROM SURVEY 3-12-42 Vol 32 P 122

SCALE 1/2" = 1'

520
 501
 511