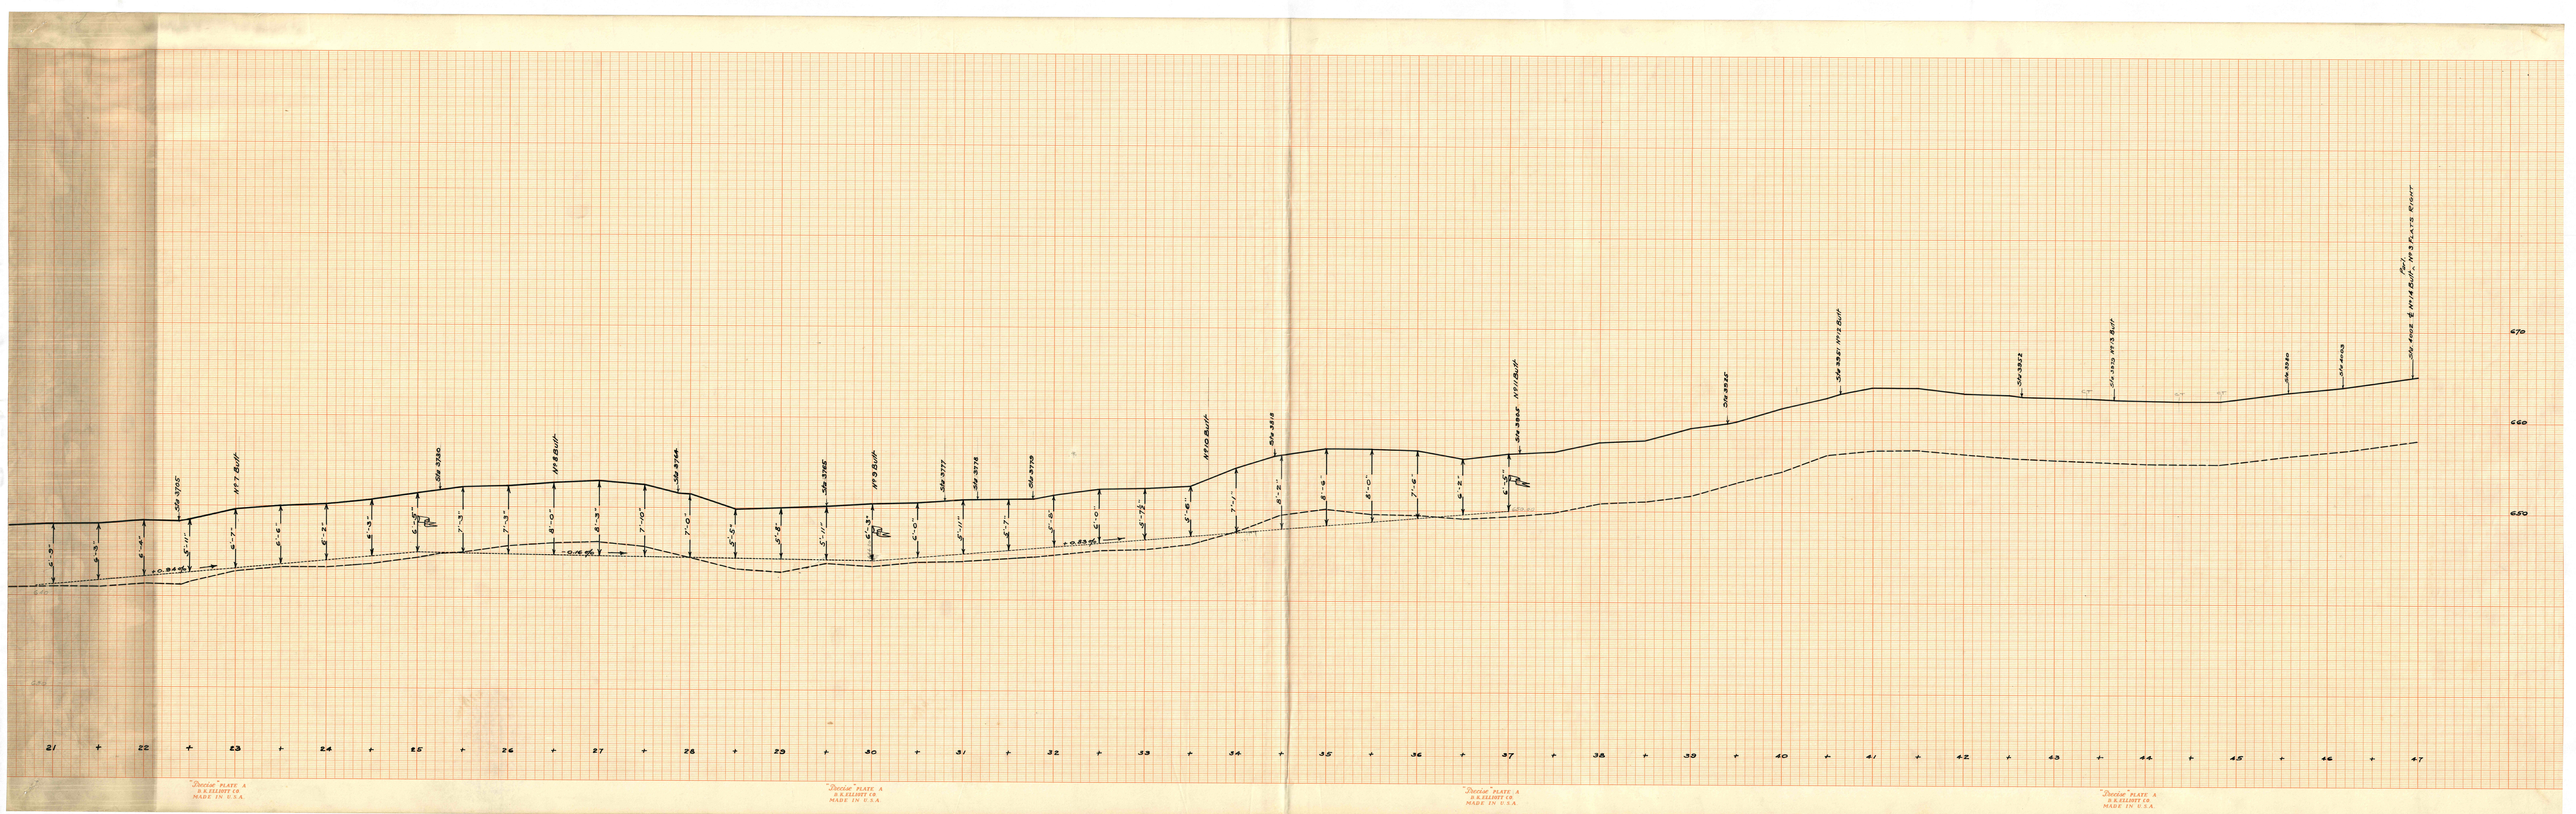

"Dietzia" PLATE A
K & E. ELLIOTT CO.
MADE IN U.S.A.

"Dietzia" PLATE A
K & E. ELLIOTT CO.
MADE IN U.S.A.

"Dietzia" PLATE A
K & E. ELLIOTT CO.
MADE IN U.S.A.

"Dietzia" PLATE A
K & E. ELLIOTT CO.
MADE IN U.S.A.