


PROFILE OF GRADING ON
 LOADED HAULAGE ROAD FROM
 NO. 1 & NO. 2 RIGHT FLATS
 SCALE 1" = 20' HOR.
 1" = 2' VERT. 12-5-27

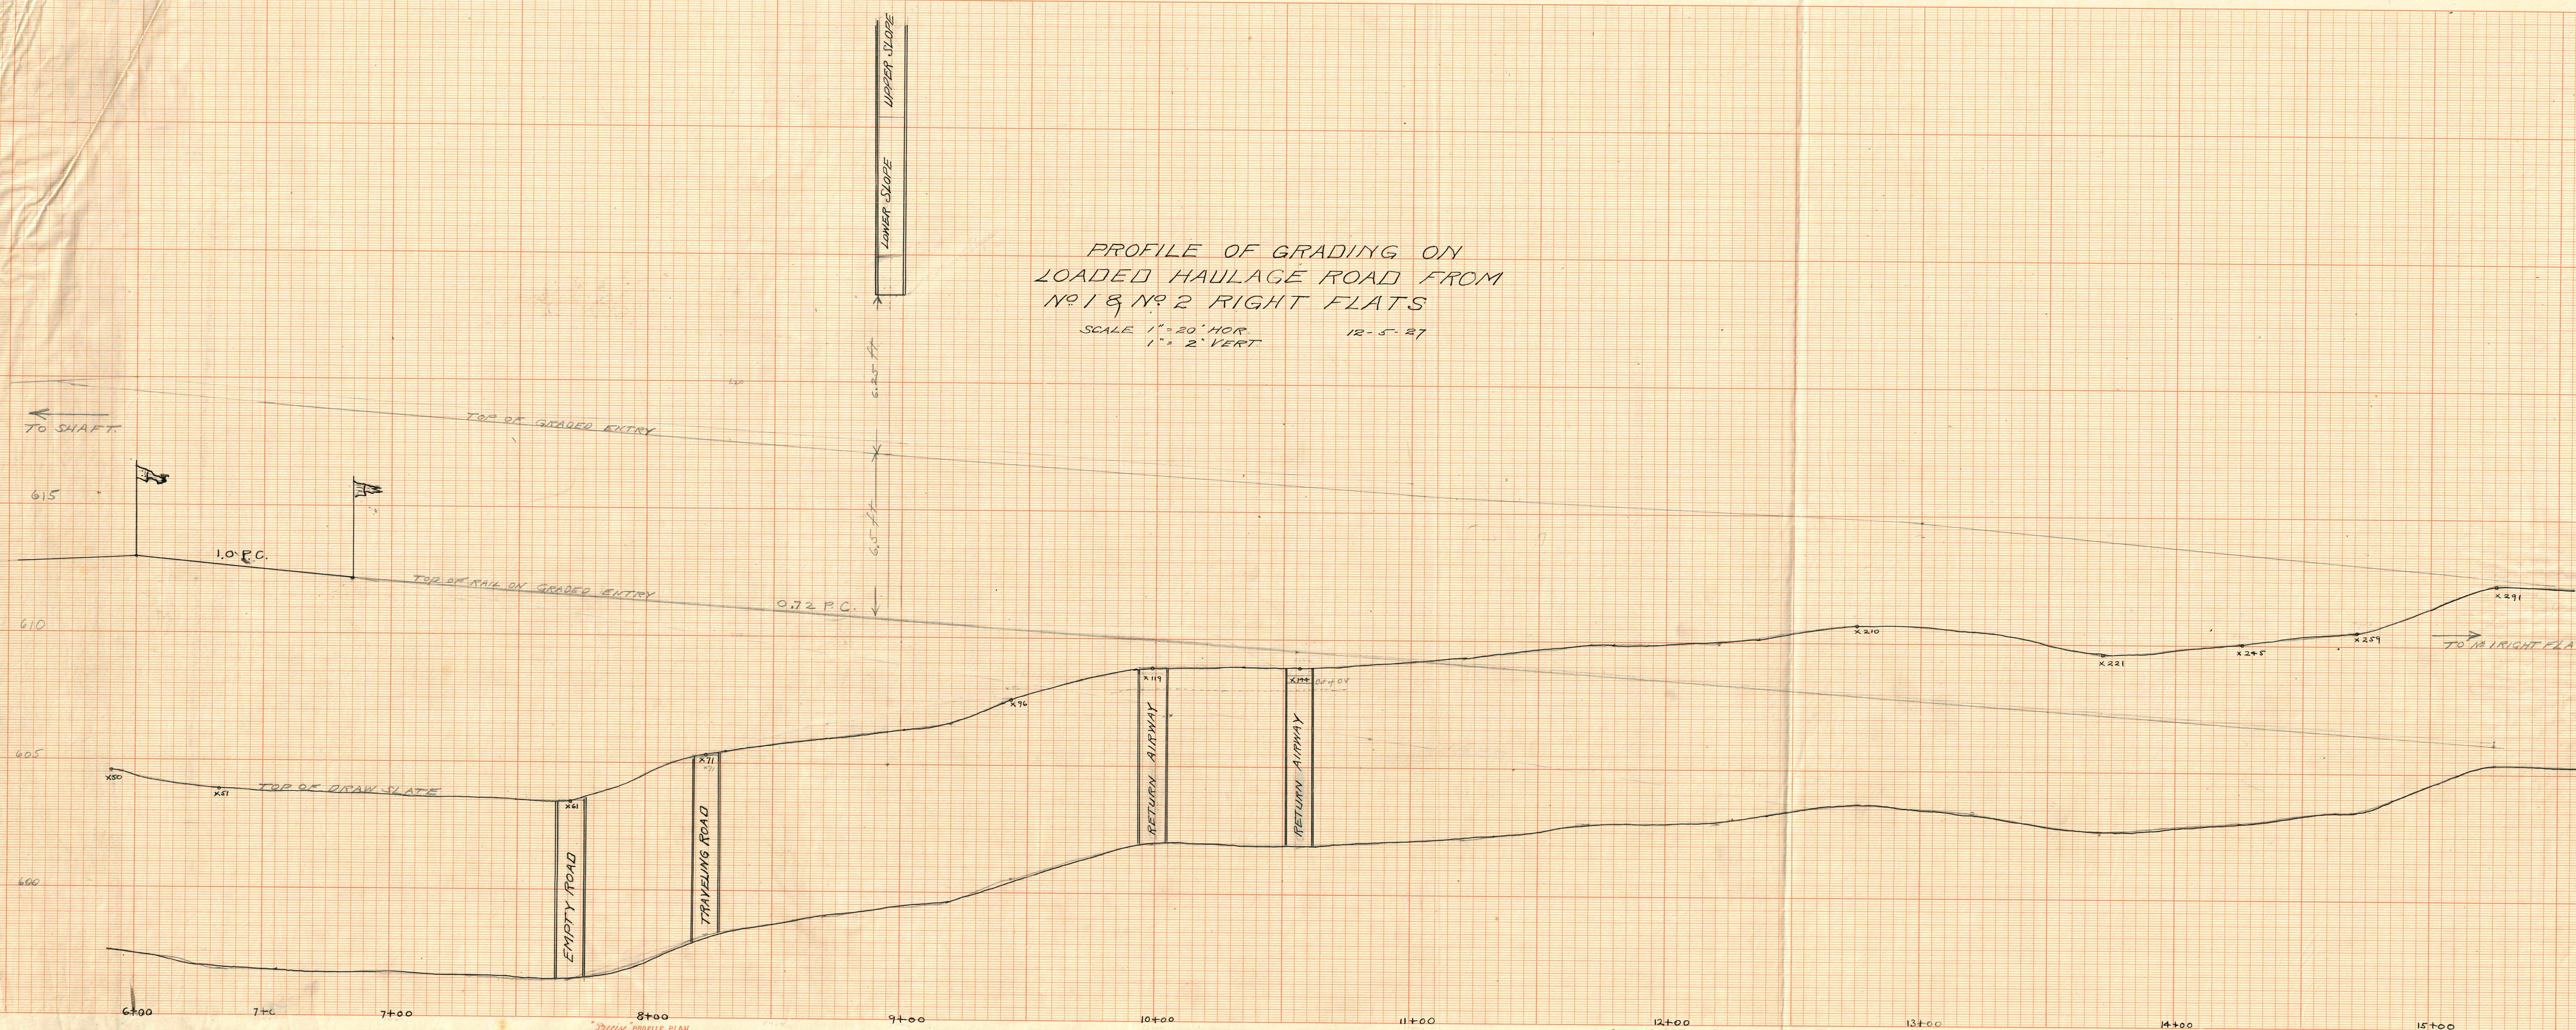

"Dress" PROFILE PLAN
 PLATE A.


