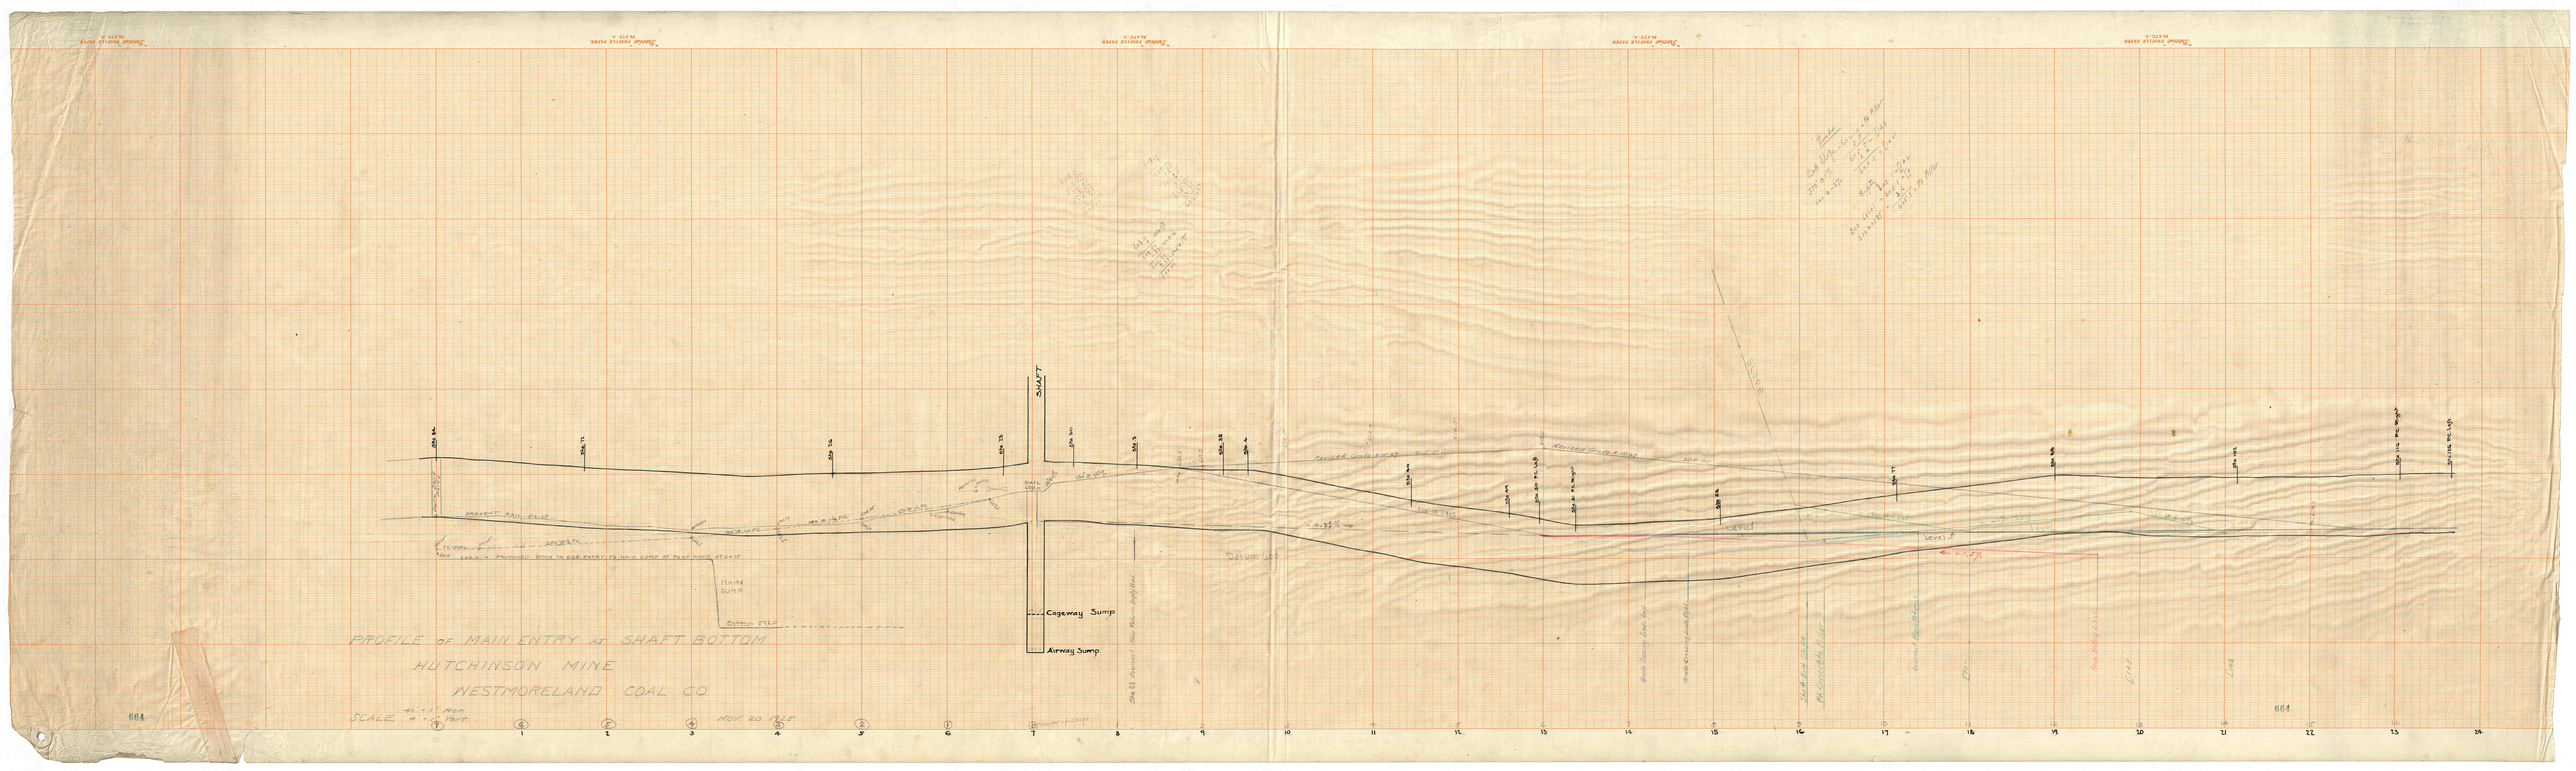
PROFILE OF MAIN ENTRY AT SHAFT BOTTOM
HUTCHINSON MINE
WESTMORELAND COAL CO.
SCALE 40' = 1" Hor. 4' = 1" Vert.
NOV. 20 1925
SHAFT
Cageway Sump
Airway Sump
MAIN SUMP
Bottom 5420
PRESENT RAIL PROFILE
Level
Level
Level
Datum 600
664
664