Rock excavation in Main Entry above shaft 11-4-27

First excavation { Root taken down 4233 cu. yds. solid 6350 cu. yds loose
Left in for fill 2071 " " " 3107 " " "
3243 " " " – excess sent outside

Second excavation { Root taken down 2803 " " " 4205 " " "
Left in for fill 2124 " " " 3186 " " "
1019 " " " = excess sent outside

PROFILE OF MAIN ENTRY AT SHAFT BOTTOM.
HUTCHINSON MINE
WESTMORELAND COAL CO.
SCALE 20' = 1" HOR / 2' = 1" VER'T. OCT-17-1927.

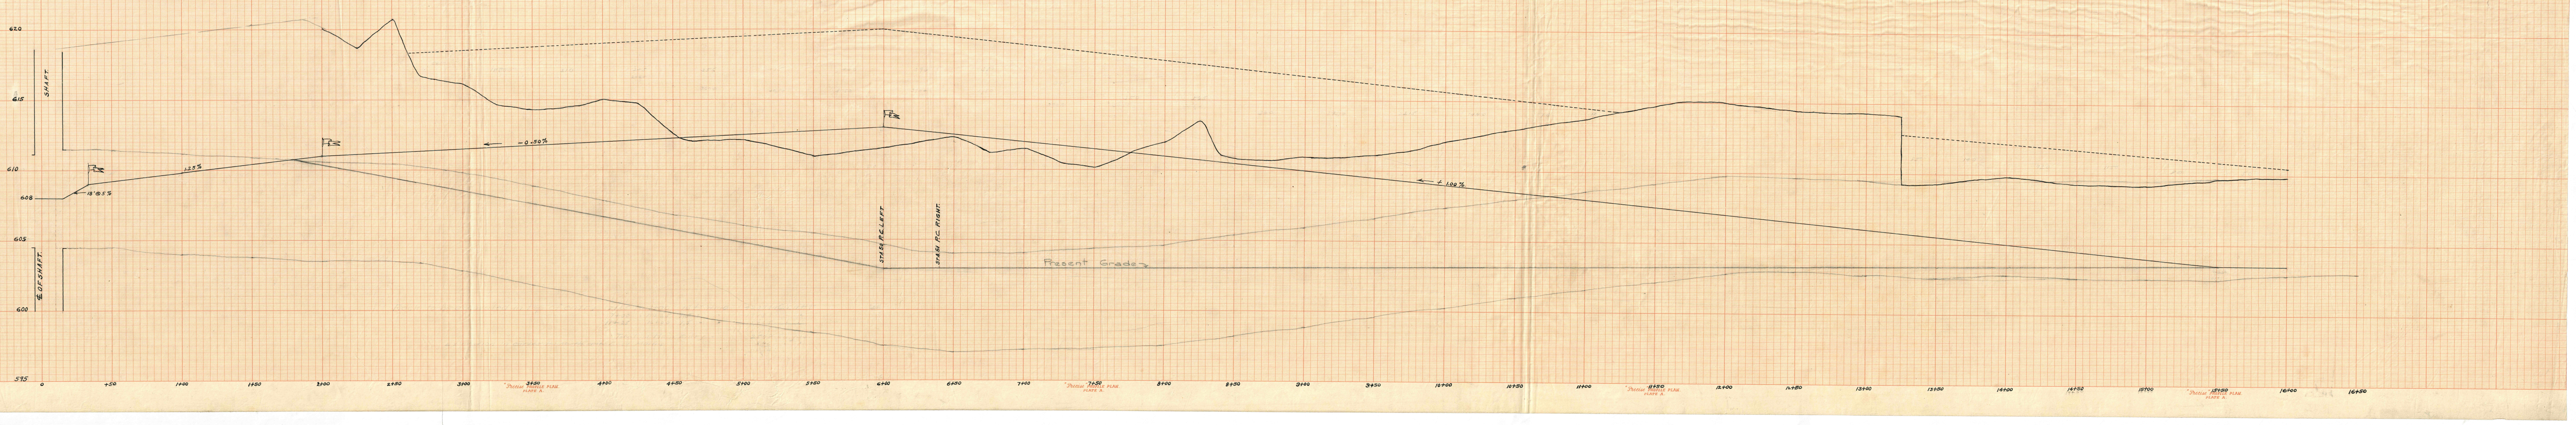
625
620
615
610
608
605
600
595
SHAFT.
℄ OF SHAFT.
18'@5%
1.25%
–0.50%
+1.00%
STA. 50 P.C. LEFT
STA. 51 P.C. RIGHT
Present Grade
0
+50
1+00
1+50
2+00
2+50
3+00
3+50
4+00
4+50
5+00
5+50
6+00
6+50
7+00
7+50
8+00
8+50
9+00
9+50
10+00
10+50
11+00
11+50
12+00
12+50
13+00
13+50
14+00
14+50
15+00
15+50
16+00
16+50

"Precise" PROFILE PLAN. PLATE A.