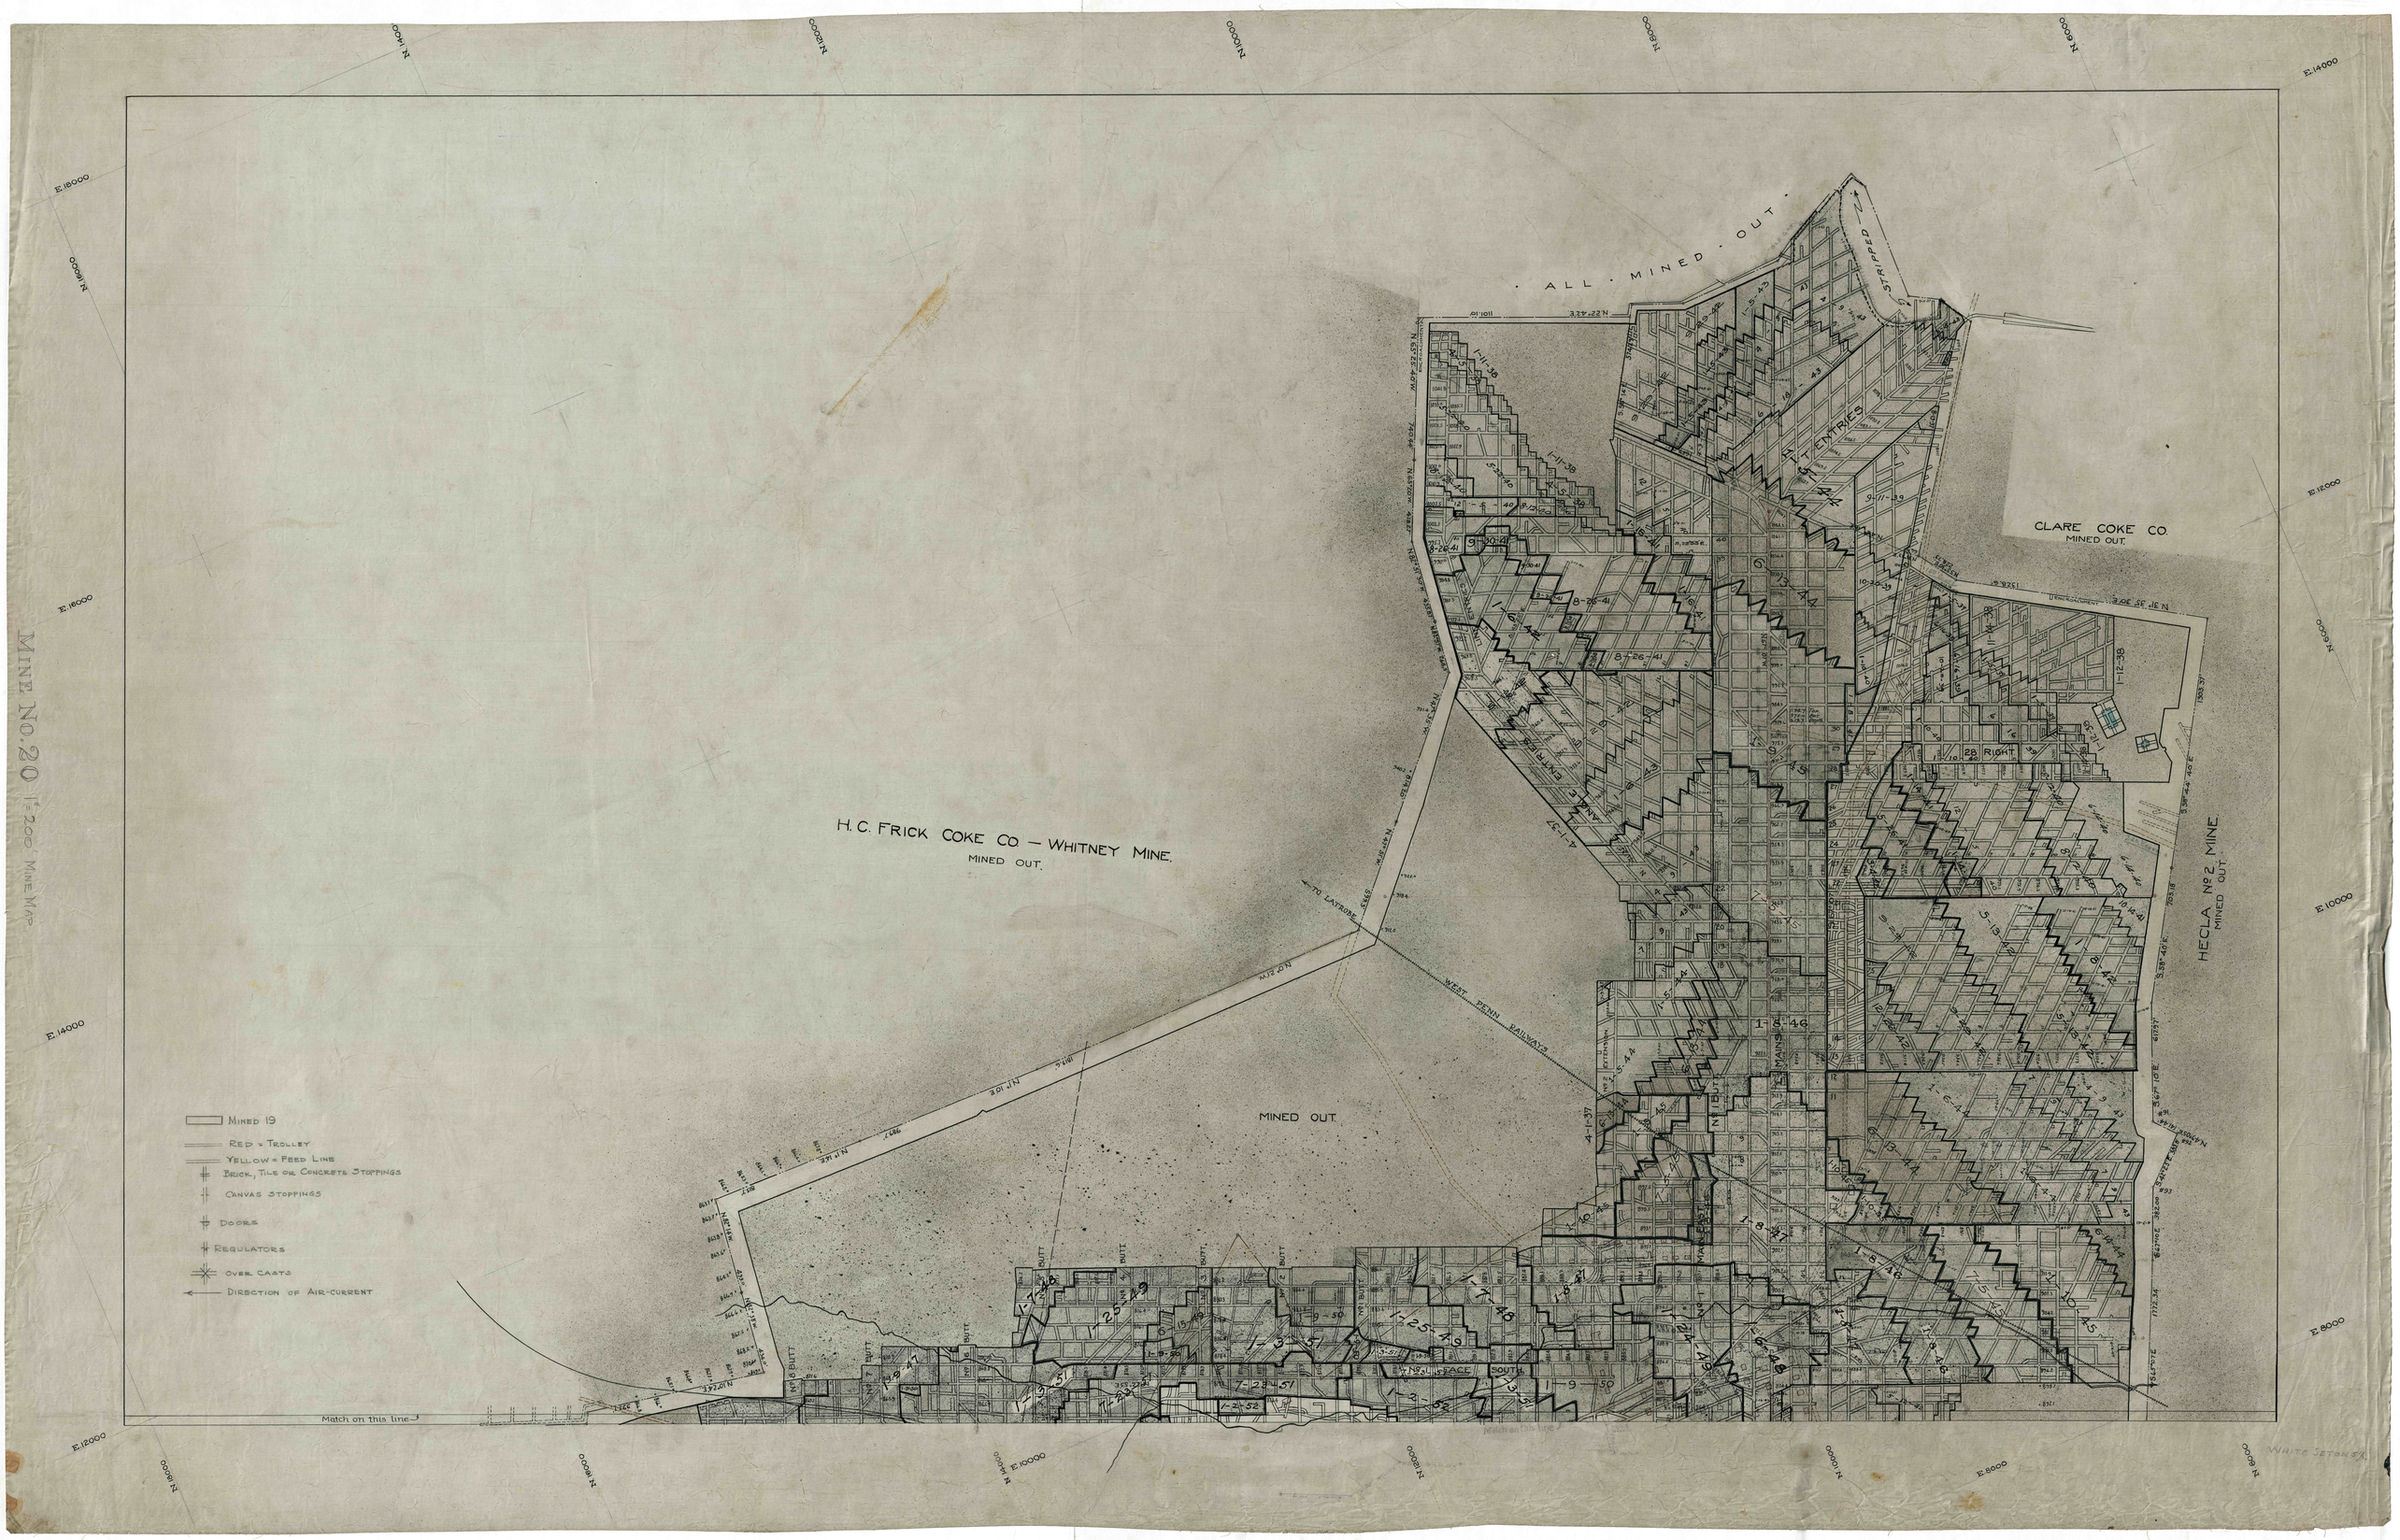

MINE No. 20 1"=200' MINE MAP
ALL · MINED · OUT
STRIPPED
CLARE COKE CO.
MINED OUT.
H. C. FRICK COKE CO. — WHITNEY MINE.
MINED OUT.
HECLA No. 2 MINE
MINED OUT.
TO LATROBE
WEST PENN RAILWAYS
MINED OUT.
Match on this line
MINED 19
RED = TROLLEY
YELLOW = FEED LINE
BRICK, TILE OR CONCRETE STOPPINGS
CANVAS STOPPINGS
DOORS
REGULATORS
OVER CASTS
DIRECTION OF AIR-CURRENT