

#23


3

6

North

22

24

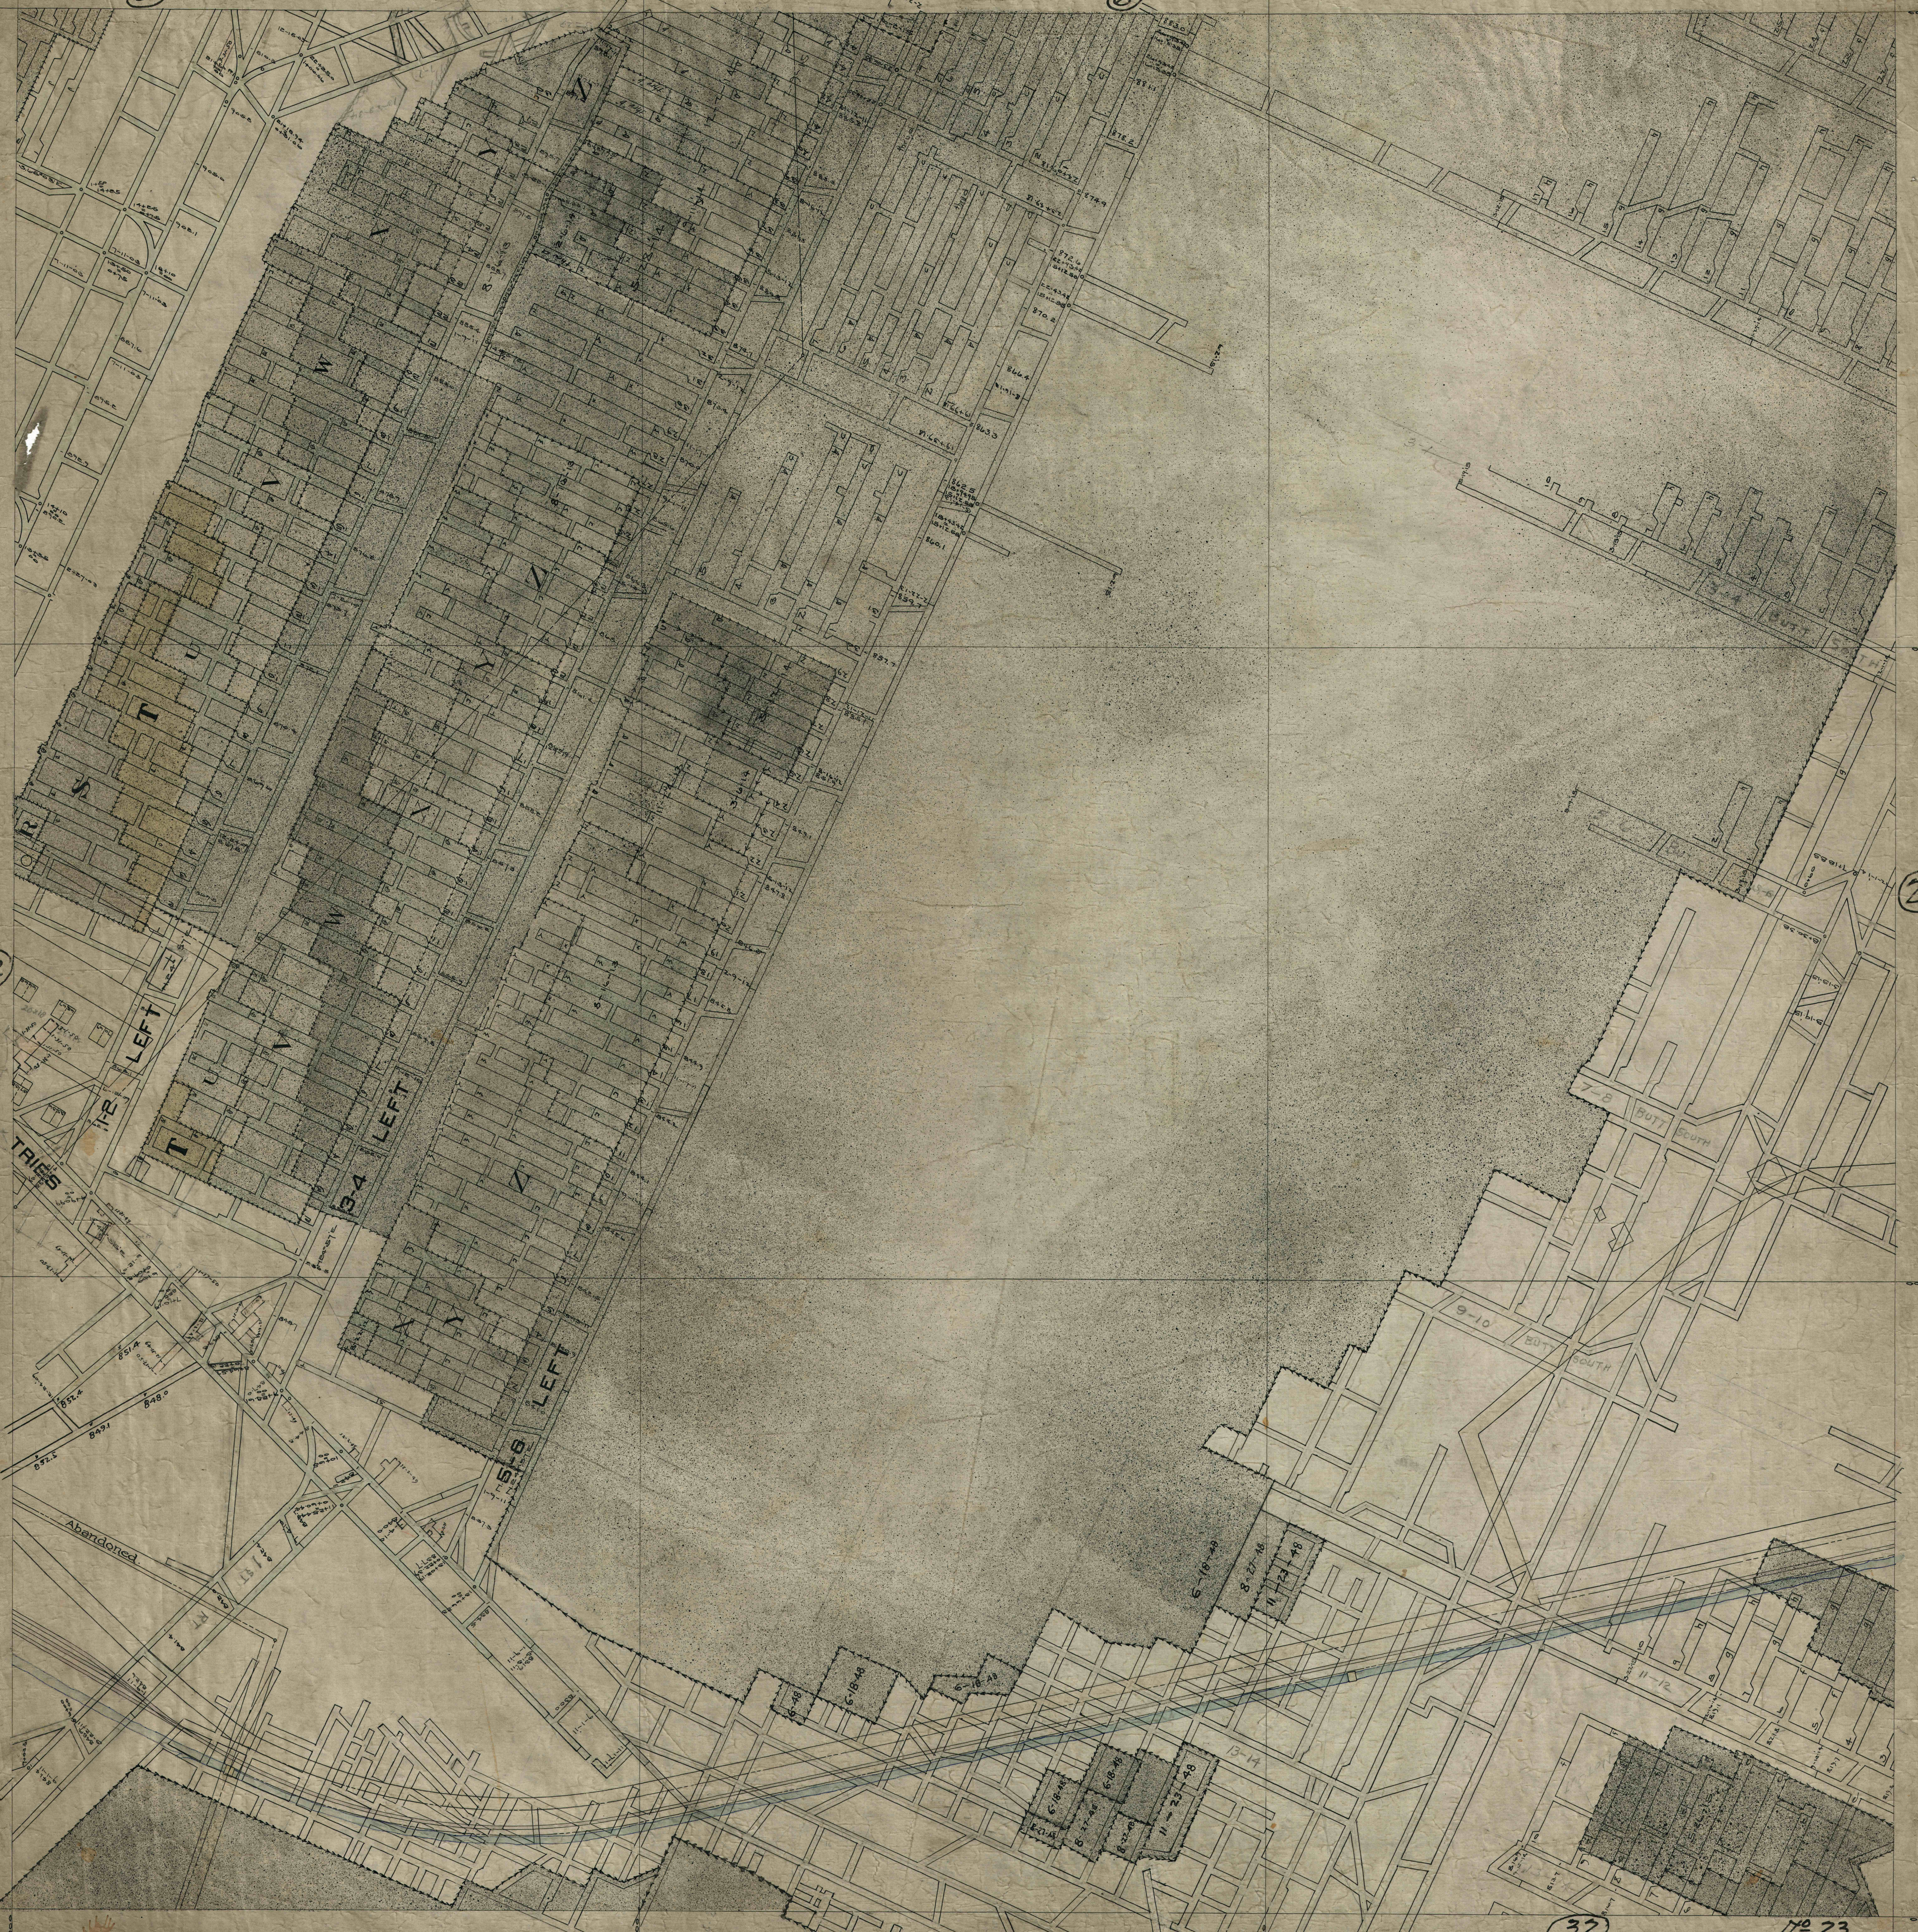

32

No 23  
#3 Dr