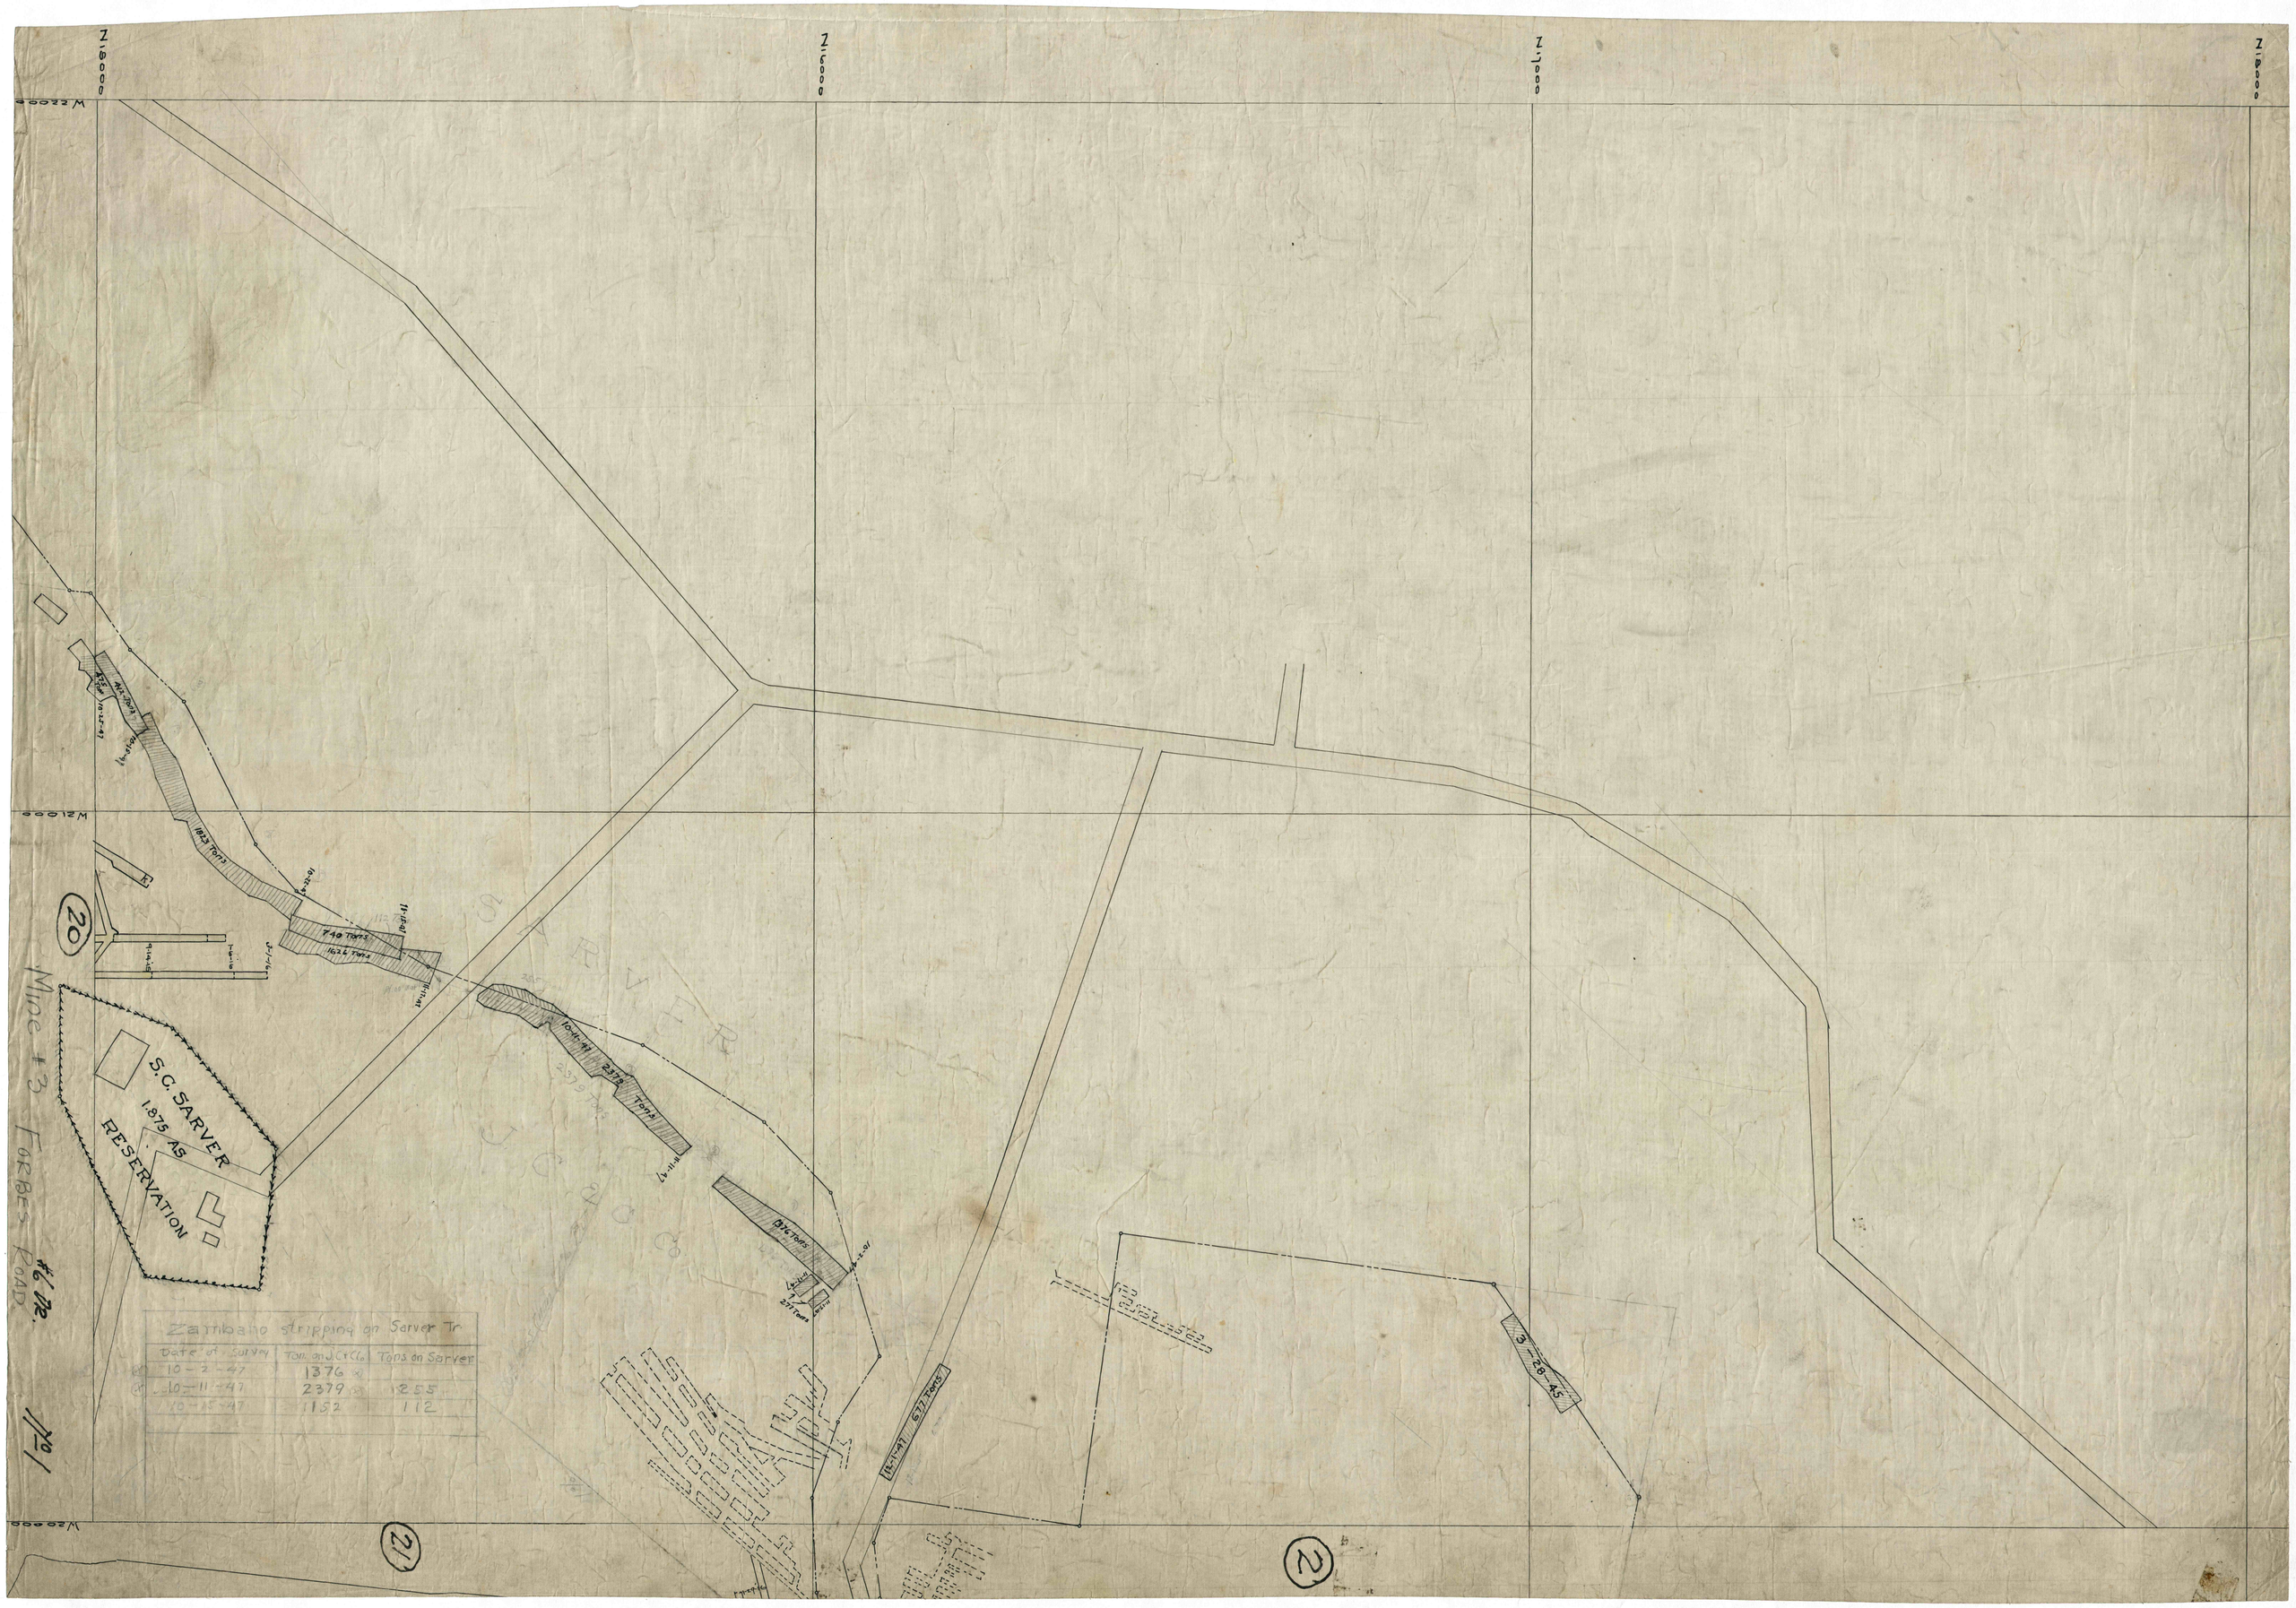

Zambano stripping on Sarver Tr.

Date of Survey	Ton. on J.C.&Co.	Tons on Sarver
10-2-47	1376	
10-11-47	2379	255
10-15-47	1152	112