


501

9 #

SPONT CO

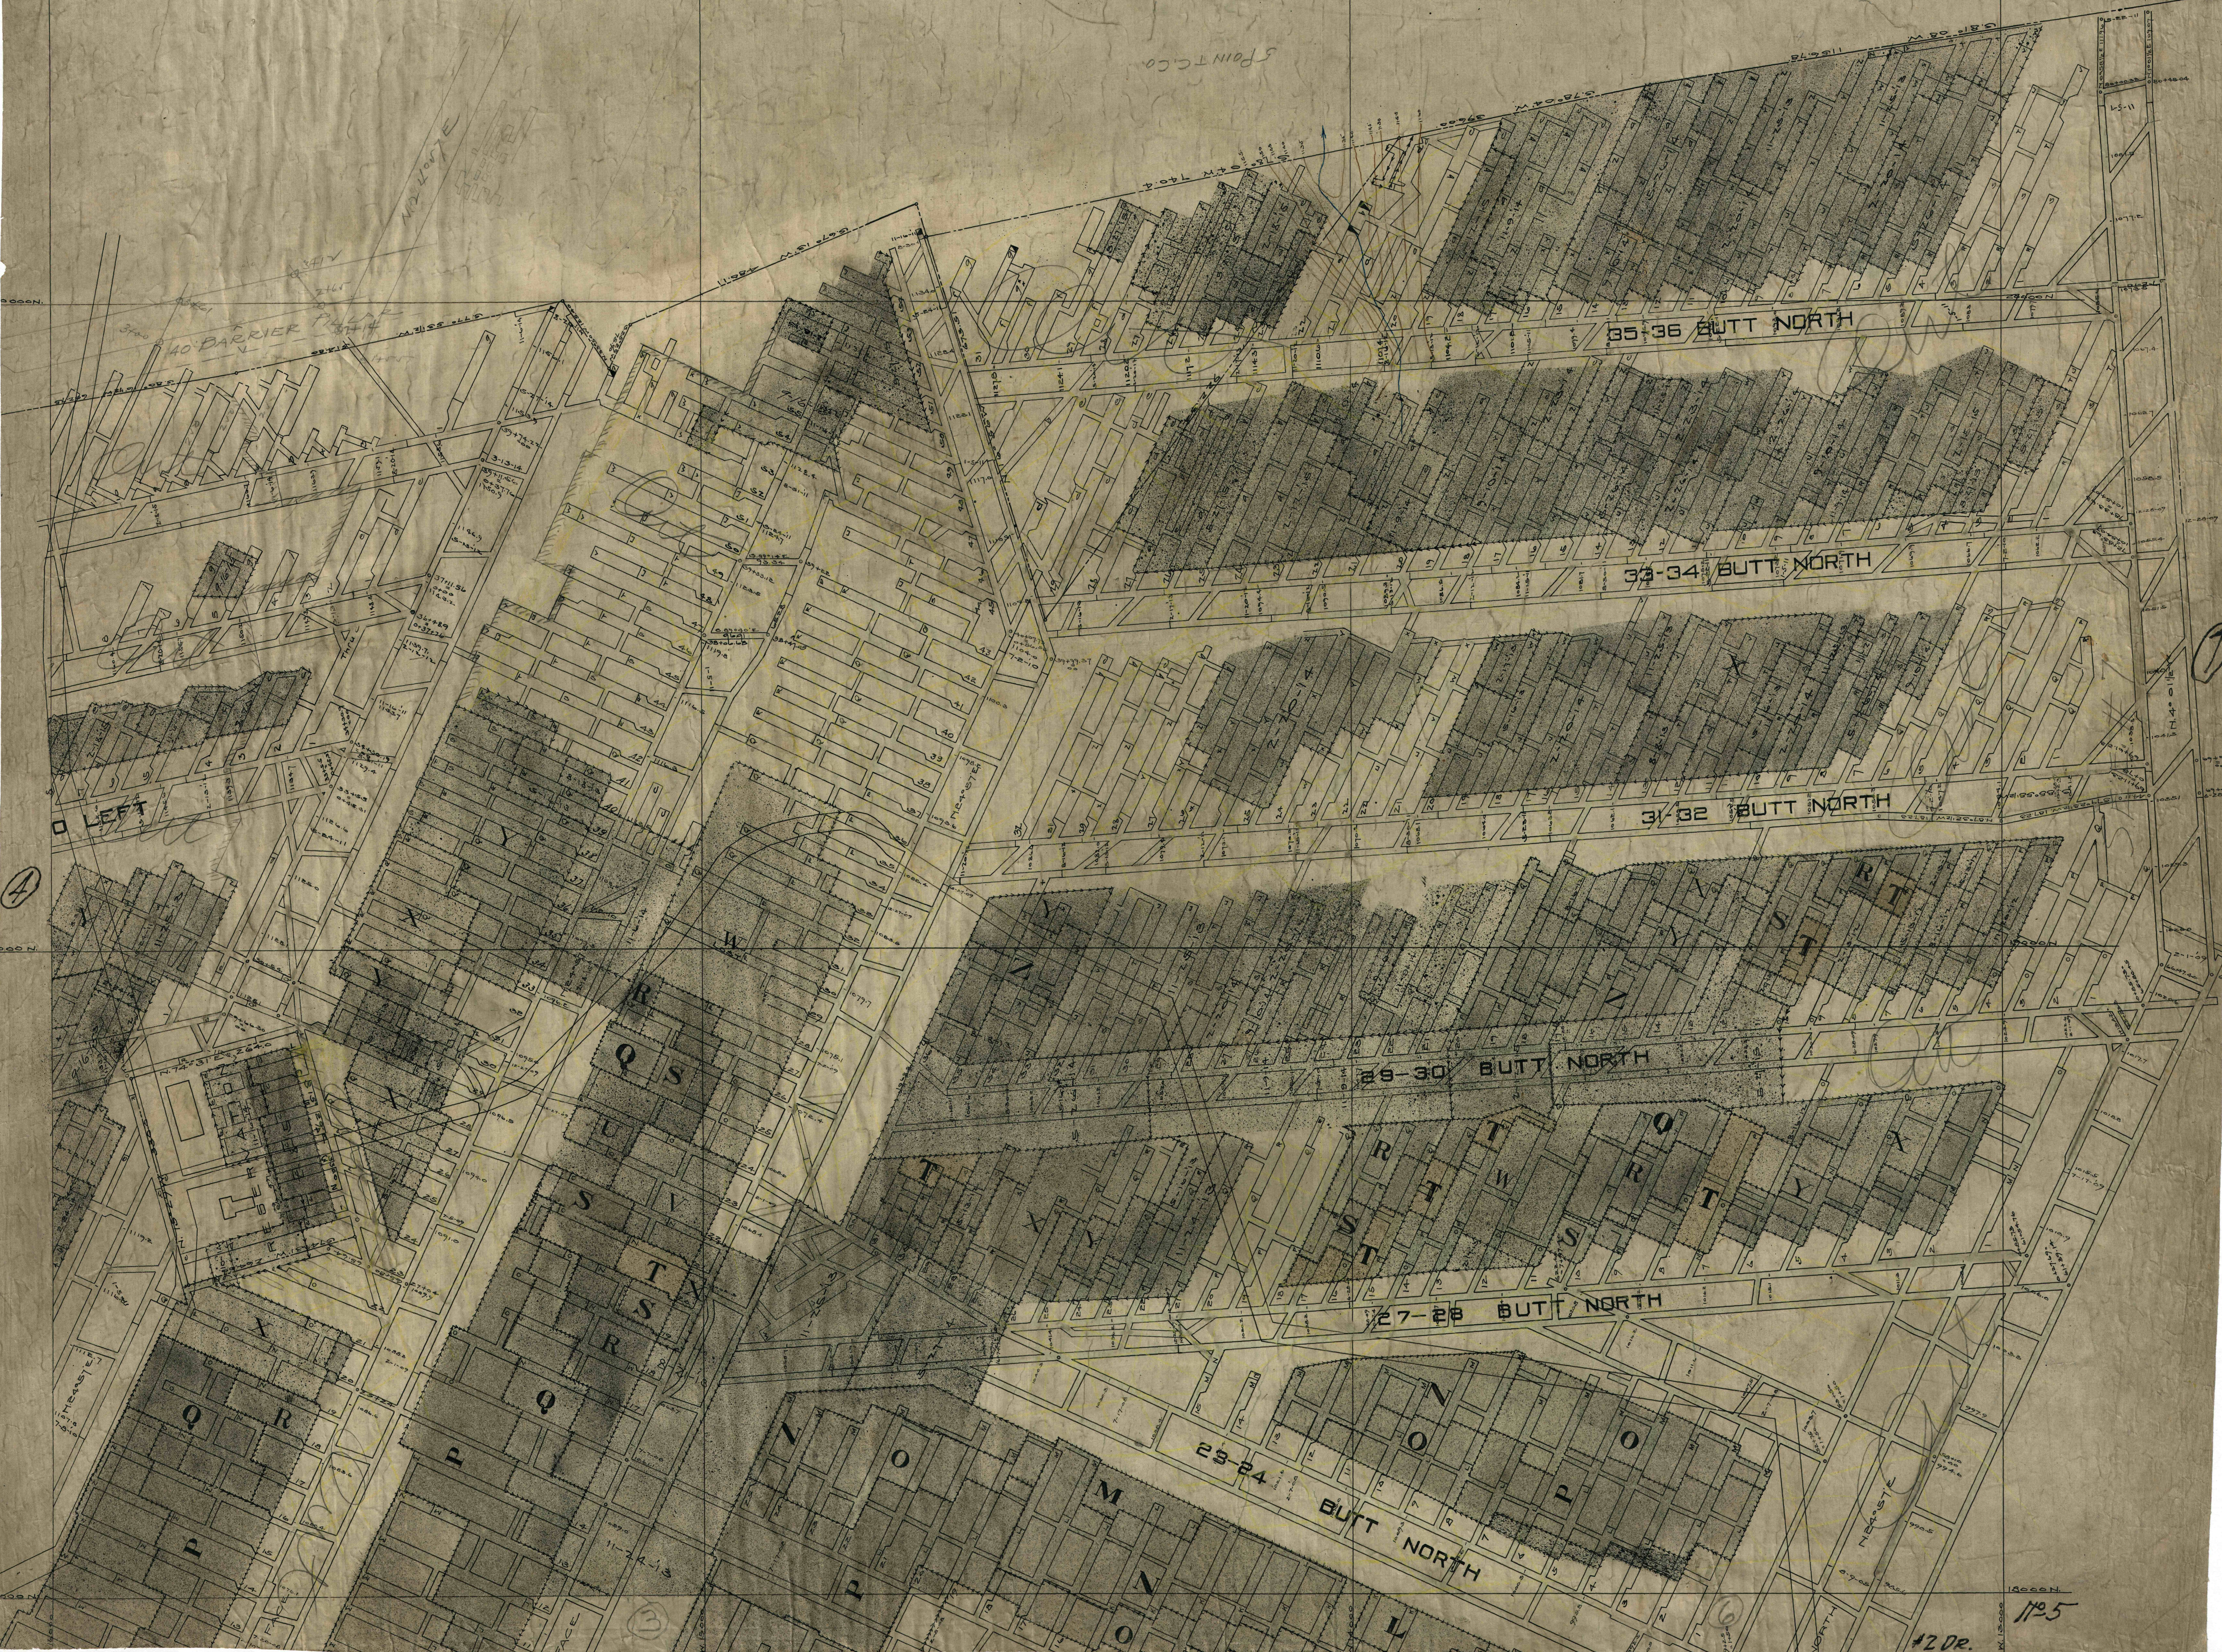

1195

#2 Dr.